

FILED

Date: 3-18-2020 By: SC

This survey consists of:

Map: _____

Narrative: _____

Corner Rpt: CS 65/104-56

DOUGLAS COUNTY
SURVEYOR

CORNER REPORT FORM

Section 17 Township 31S Range 5W
Douglas County Date 3-2020
PLSS Number 300440

CORNER DESIGNATION

1/4 COR 17/16

- Condition Report only
- Not Found
- Renewed
- Unrecorded
- Surveyed In
- Referenced out

Previous Renewals/Surveys, etc:

KING 1959 CS 51/56 DCSO MAY 1966 CS 54/25-18
SMALLEY 1991 CS 63/129

Monument(s) & Accessories Found: (Condition and Source)

DCSO BRASS CAP
42" Burnt stump S78°E 34°FT
5/8" I. Rod with Alum CAP S45°W 10° FT

Monument Detail

Sketch

COUNTY SURVEYORS OFFICE
T31S R5W
1/4 S17/S16
1966

Monument Set (Procedures and Description)

New Accessories

5/8" X 30" I. Rod N45°E 5° FT I. Rod have yellow Plastic
5/8" X 30" I. Rod S45°E 7° FT CAP'S STAMPED
5/8" X 30" I. Rod N45°W 5° FT I.E. ENGINEERING
5' Alum post alongside

Surveyor's Seal

Location & Comments

AREA BADLY BURNED
2019
CORNER IS APPROX
205' ABOVE ROAD
31-5-17.2

Compass Declination 15 1/2° E



Firm/Agency: i.e. Engineering, Inc.

Address: 809 SE Pine St., Roseburg, OR 97470

Party Chief: N. From Dahl

Notes:

Witness: L. Hedelens

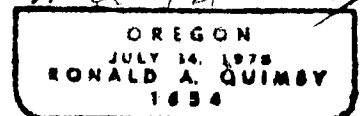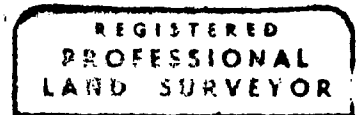

EXP 12-31-20
C.S. File 65/104-56