

FILED
Date: 3/18/2020 By: JC

This survey consists of:

Map: _____

Narrative: _____

Corner Rpt: CS 65/104-57

DOUGLAS COUNTY
SURVEYOR

CORNER REPORT FORM

Section 10 Township 3/S Range SW
Douglas County Date 3-2020
PLSS Number 500540

CORNER DESIGNATION

1/4 COR 10/11

- Condition Report only
- Not Found
- Renewed
- Unrecorded
- Surveyed In
- Referenced out

Previous Renewals/Surveys, etc:

BLM Resurvey 1972-73 10/35 Pg 15679

Monument(s) & Accessories Found: (Condition and Source)

FD BLM BRASS CAP
ORIG B.T.'S BURNT

Monument Detail

Sketch

U.S. DEPT OF THE INTERIOR
UNLAWFUL TO DISTURB

1/4

S10/S11

T31S R5W

1973

CADASTRAL SURVEY
BUREAU OF LAND MANAGEMENT

Monument Set (Procedures and Description)

New Accessories

5'x30" I. Rod's set N15°E 5 FT - S56°E 7 FT
N 35°W 7 FT AND S 45°W 6 FT


All Rods have yellow plastic caps marked
100 ENGINEERING 5' Alum post alongside

Surveyor's Seal

Location & Comments

AREA Badly
BURNT 2019


I. Rod's
Compass Declination 15 1/2° E
Firm/Agency: i.e. Engineering, Inc.
Address: 809 SE Pine St., Roseburg, OR 97470

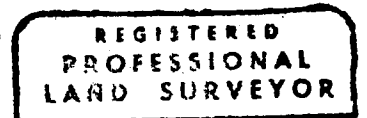

Party Chief: N. FROMPAHL

Notes:

Witness: L. Heddens

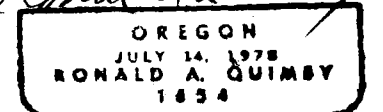

EXP 12-31-20

C.S. File 65/104-57