

FILED

Date: 3/18/2020 By: X

This survey consists of:

Map: _____

Narrative: _____

Corner Rpt: CS 65/104-58

DOUGLAS COUNTY
SURVEYOR

CORNER REPORT FORM

Section 2 Township 31S Range SW
Douglas County Date 3-2020
PLSS Number 540600

CORNER DESIGNATION

1/4 2/11

- Condition Report only
- Not Found
- Renewed
- Unrecorded
- Surveyed In
- Referenced out

Previous Renewals/Surveys, etc:

BLM RESURVEY 1972-73 Vol 38 Pg 15681

BLM Resurvey 2017 Vol 59 Pg 23723-4

Monument(s) & Accessories Found: (Condition and Source)

BLM BRASS CAP

50" Double Trunk Fir N28°E 138 FT (Healed Scar)

42" Fir S29 1/2 W 628 FT (Good Scar)

Monument Detail

Sketch

U.S. DEPT. OF THE INTERIOR
UNLAWFUL TO DISTURB

1/4 52/511

T31S R5W
1973

CADASTRAL SURVEY
BUR. OF LAND MANAGEMENT

Monument Set (Procedures and Description)

New Accessories

5" Alum post 5° FT North & 5° FT West

Surveyor's Seal

Location & Comments

AREA BADLY
BURNED 2019

Compass Declination 15 1/2° E



Firm/Agency: i.e. Engineering, Inc.

Address: 809 SE Pine St., Roseburg, OR 97470

Party Chief: N. From Dahl Road

Notes:

Witness: L. Heddens

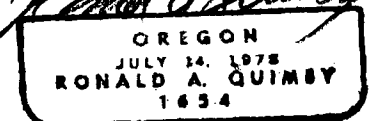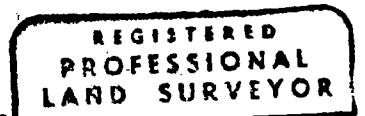

EXP 12-31-20
C.S. File 65/104-58