

FILED

Date: 3-18-2020 By: X

This survey consists of:

Map: _____

Narrative: _____

Corner Rpt: CS 65/104-59

CORNER REPORT FORM

Section 2 Township 315 Range 5W
Douglas County Date 3-2020
PLSS Number 540640

DOUGLAS COUNTY
SURVEYOR

CORNER DESIGNATION

C 1/4 52

- Condition Report only
- Not Found
- Renewed
- Unrecorded
- Surveyed In
- Referenced out

Previous Renewals/Surveys, etc:

BLM 2018 Group No. 2927 Filed 2-3-2020

Monument(s) & Accessories Found: (Condition and Source)

BLM BRASS CAP
9" PINE S28°E 382 FT (Burnt)
5" Madrone N153 1/4 W 383 FT (Burnt)

Monument Detail

Sketch

U. S DEPT. OF INTERIOR
T315 R5W
C 1/4 52
2018

Monument Set (Procedures and Description)

BUREAU OF LAND MANAGEMENT

New Accessories

5/8" x 30" I. Rod North 12° FT 5' Alum post along
5/8" x 30" I. Rod South 7° FT side of I. Rods
Both Rod have yellow Plastic caps stamped



Surveyor's Seal

Location & Comments

AREA Badly
BURNT 2019

Compass Declination 15 1/2° E
Firm/Agency: i.e. Engineering, Inc.
Address: 809 SE Pine St., Roseburg, OR 97470

Party Chief: R. Herchel / Ronald A. Quimby
Notes:
Witness: J. Ogden

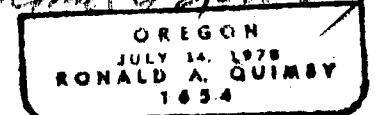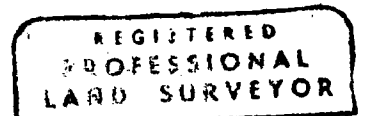

EXP 12-31-20
C.S. File 65/104-59