

FILED

Date: 3-18-2020 By: SC

This survey consists of:

Map: _____

Narrative: _____

Corner Rpt: CS 65/104-60

CORNER REPORT FORM

Section 23 Township 31S Range 5W
Douglas County Date 3-2020
PLSS Number 600360

DOUGLAS COUNTY
SURVEYOR

CORNER DESIGNATION

N 1/4 23/24

- Condition Report only
- Not Found
- Renewed
- Unrecorded
- Surveyed In
- Referenced out

Previous Renewals/Surveys, etc:

BLM RESURVEY 1973 PG. 15661

Monument(s) & Accessories Found: (Condition and Source)

BLM BRASS CAP
16" FIR 530°E 34' FT GOOD SCAR (SNAG)
14" FIR STUMP 553°W 23' FT

Monument Detail

Sketch

U.S. DEPT OF INTERIOR
UNLAWFUL TO DISTURB
N 1/4
S23 | S24
1973
CADASTRAL SURVEY
BUR. OF LAND MANAGEMENT

Monument Set (Procedures and Description)

New Accessories

5/8" x 30" I. ROD WEST 77° FT BOTH RODS HAVE YELLOW
PLASTIC CAP'S MARKED
5/8" x 30" I. ROD EAST 9° FT 12 ENGINEERING

5' ALUM. POST ALONG
SIDE

Surveyor's Seal

Location & Comments

AREA BURNT
BA 1/4 2019

Compass Declination 15 1/2° E



Firm/Agency: i.e. Engineering, Inc.

Address: 809 SE Pine St., Roseburg, OR 97470

Party Chief: R. Herchel

Notes:

Witness: J. Ogden

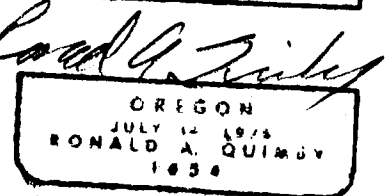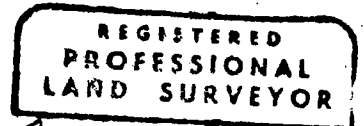

EXP 12-31-20

C.S. File 65/104-60