

FILED

Date: 3/19/2020 By: SC

This survey consists of:

Map: _____

Narrative: _____

Corner Rpt: CS 65/104-62

DOUGLAS COUNTY
SURVEYOR

CORNER REPORT FORM

Section 9 Township 31S Range 5W
Douglas County Date 2-2020
PLSS Number 360600

CORNER DESIGNATION

E 1/4 4
9

- Condition Report only
- Not Found
- Renewed
- Unrecorded
- Surveyed In
- Referenced out

Previous Renewals/Surveys, etc:

BLM Resurvey 10/35 PG. 14370
Quimby 11/16/22 11-2014

Monument(s) & Accessories Found: (Condition and Source)

BLM BRASS CAP
25" FIR S60°W 25' FT (BADLY BURNED)
12" FIR N130°W 25' FT (OPEN SCAR)

Monument Detail

Sketch

U.S. DEPT OF INTERIOR
UNLAWFUL TO DISTURB
T31S R5W

E 1/4 54

59

1966

CADASTRAL SURVEY

BUR. OF LAND MANAGEMENT

Monument Set (Procedures and Description)

New Accessories

5/8" x 30" I. ROD S30W 34 FT Both have yellow
5/8" x 30" I. ROD N12E 54 FT Plastic caps marked
1e engineering
5' Alum post 10' FT N 5' post set along side Surveyor's Seal
5' FT E

Location & Comments

AREA BADLY
BURNED 2019

Compass Declination 15' E



Firm/Agency: i.e. Engineering, Inc.

Address: 809 SE Pine St., Roseburg, OR 97470

Party Chief: R. Herbel

Notes:

Witness: J. Ogden

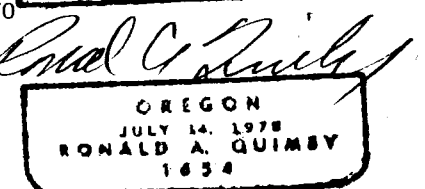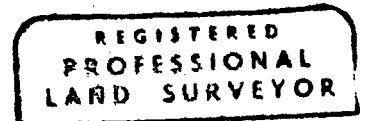

EXP 12-31-20

C.S. File 65/104-62