


CORNER ~~FD~~ TO be OK

IN T31S R5W

*Ronald A. Quimby*

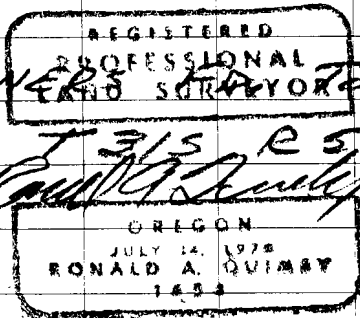

EXP 12-31-20

Sec. COR 4/3 only

PER PLSS 400700

See COR 7/8  
18/17

PER PLSS 200500

See COR. 23/24  
26/25

PER PLSS 600300

See COR 4/3  
9/10

PER PLSS 400600

2/2020

CORNERS FD TO be OK


IN T31S R5W

1/4 COR S21


S28

PER PLSS 340300

FILED  
Date: 3/19/2020 By: *X*  
This survey consists of:  
Map: \_\_\_\_\_  
Narrative: \_\_\_\_\_  
Corner Rpt: CS 65/104-63  
DOUGLAS COUNTY  
SURVEYOR

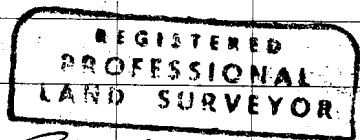

*Ronald A. Quimby*

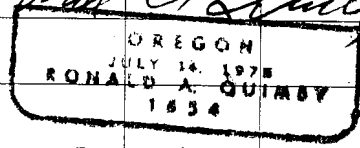

EXP 12-31-20