

FILED

Date: 3-19-2020 By: X

This survey consists of:

Map: _____

Narrative: _____

Corner Rpt: CS 65/104-65

DOUGLAS COUNTY SURVEYOR

CORNER REPORT FORM

Section 15 Township 31S Range 5W
Douglas County Date 2-2020
PLSS Number 500440

CORNER DESIGNATION

1/4 COR 15/14

- Condition Report only
- Not Found
- Renewed
- Unrecorded
- Surveyed In
- Referenced out

Previous Renewals/Surveys, etc:

KING 1959 CS 42/425 BLM RESURVEY 1972-73 Vol 38 Pg 1567L
DCSO 1966 CS 54/25-5 BLM REHAB 2000 Vol 53-20587-8

Monument(s) & Accessories Found: (Condition and Source)

BLM BRASS CAP

NO TREES

Monument Detail

Sketch

U.S. Dept of Interior
T 31 S R 5 W
1/4 S15/S14
1972

Monument Set (Procedures and Description)

BUREAU OF LAND MANAGEMENT

New Accessories

5/8" I. ROD S40°W 4³/₄ FT
5" I. ROD N69°W 5³/₈ FT
5/8" I. ROD N31°E 6²/₈ FT
5/8" I. ROD S32°E 5³/₈ FT

All rods have yellow plastic caps stamped 1C ENGINEERING
5' Alum post along side

Surveyor's Seal

Location & Comments

Compass Declination 15 1/2° E



Firm/Agency: i.e. Engineering, Inc.

Address: 809 SE Pine St., Roseburg, OR 97470

Party Chief: R. Heichel

Notes:

Witness: J. Ogden

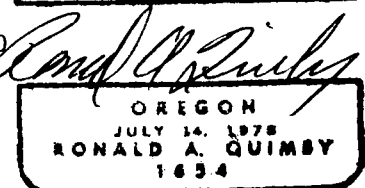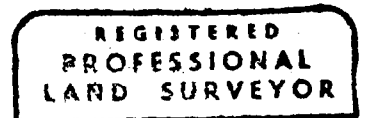

EXP 12-31-20

C.S. File 65/104-65