

FILED

Date: 3/19/2020 By: SC

This survey consists of:

Map: \_\_\_\_\_

Narrative: \_\_\_\_\_  
Corner Rpt: CS65/104-66

DOUGLAS COUNTY  
SURVEYOR

CORNER REPORT FORM

Section 23 Township 3/S Range 571  
Douglas County Date 2-2020  
PLSS Number 520400

CORNER DESIGNATION

W 1/4 14  
23

- Condition Report only
- Not Found
- Renewed
- Unrecorded
- Surveyed In
- Referenced out

Previous Renewals/Surveys, etc:

BLM RESURVEY 1973 P 15674

Monument(s) & Accessories Found: (Condition and Source)

BLM BRASS CAP  
16" FIR N55°W 49<sup>5</sup> FT BADLY BURNT

Monument Detail

Sketch

US Dept of Interior  
TBIS R5W  
W 1/4 514  
523  
1973

Monument Set (Procedures and Description)

BUREAU OF LAND MANAGEMENT

New Accessories

5/8" I. ROD N16°E 4<sup>3</sup> FT All Rod had yellow plastic  
5/8" I. ROD S32W 5<sup>0</sup> FT CAP STAMPED IENGINEERING  
5' ALUM POST ALONGSIDE

Surveyor's Seal


Location & Comments

AREA BADLY  
BURNT 2019

Compass Declination 15<sup>1</sup>/<sub>2</sub>°E  
Firm/Agency: i.e. Engineering, Inc.  
Address: 809 SE Pine St., Roseburg, OR 97470



Party Chief: R. Hoxby (Ronald Quimby)  
Notes:  
Witness: J. Ogdon

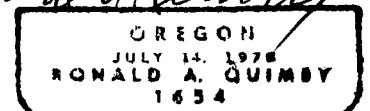

EXP 12-31-20  
C.S. File 65/104-66