

FILED

Date: 3/19/2020 By: JC

This survey consists of:

Map: _____

Narrative: _____

Corner Rpt: CS 65/104-67

CORNER REPORT FORM

Section 23 Township 31S Range SW

Douglas County Date 2-2020

PLSS Number 560300

DOUGLAS COUNTY SURVEYOR

CORNER DESIGNATION

E 1/4 23
26

- Condition Report only
- Not Found
- Renewed
- Unrecorded
- Surveyed In
- Referenced out

Previous Renewals/Surveys, etc:

BLM 1973

LANDMARK M 148-36 2005

Monument(s) & Accessories Found: (Condition and Source)

BLM BRASS CAP

12" FIR N 56° E 26.4 FT GOOD SCAR

10" FIR S 83 1/2° E 21.8 FT GOOD SCAR
35'

Monument Detail

Sketch

U.S. DEPT. OF THE INTERIOR
UNLAWFUL TO DISTURB

T31S R5W

E 1/4 523
526

1973

CADASTRA SURVEY

BUR. OF LAND MANAGEMENT

Monument Set (Procedures and Description)

New Accessories

Surveyor's Seal

Location & Comments

AREA BADLY
BURNT 2019

Compass Declination 15 1/2° E


Firm/Agency: i.e. Engineering, Inc.

Address: 809 SE Pine St., Roseburg, OR 97470

Party Chief: R. Heichel

Notes:

Witness: J. Ogden

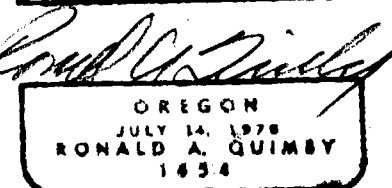

EXP 12-31-20

C.S. File 65/104-67