

FILED

Date: 5-5-2020 By: XC

This survey consists of:

Map: _____

Narrative: _____

Corner Rpt: CS 65/106-4

CORNER REPORT FORM

Section 33 Township 3/5 Range 5W

Douglas County Date 3-2020

PLSS Number
400200

DOUGLAS COUNTY
SURVEYOR

CORNER DESIGNATION

SEC COR 28/27
33/34

- Condition Report only
- Not Found
- Renewed
- Unrecorded
- Surveyed In
- Referenced out

Previous Renewals/Surveys, etc:

GLD RESURVEY 1955 Vol 28 Pg 11788-89 BLM RESURVEY 1966-68 Vol 35 Pg 14389
DCSO 1966 CS 54/25-22 EDWARDS 2018 M175-11

Monument(s) & Accessories Found: (Condition and Source)

GLD BRASS CAP
26" capped FIR STUMP N76°E 312 FT
13" MAPLE S12°E 31° FT (CHARRED)
24" FIR S35°W 46° FT (CHARRED)
Steel Post 2° south

Monument Detail

Sketch

U.S. Dept of THE INTERIOR
T 31 S R 5 W
528/527
533/534
1955

BUREAU OF LAND MANAGEMENT

Monument Set (Procedures and Description)

New Accessories

12" FIR N74°W 43° FT scribed T31SR5W528 BT
18" FIR N12°E 26° FT scribed T31SR5W527 BT
Alum. post 2° West

Surveyor's Seal



Location & Comments

AREA Badly
Burnt 2019

Compass Declination 15 1/2° E
Firm/Agency: i.e. Engineering, Inc.
Address: 809 SE Pine St., Roseburg, OR 97470

Party Chief: N. Fromm dsh *Ronald A. Quimby*

Notes:
Witness: L. Hedden S

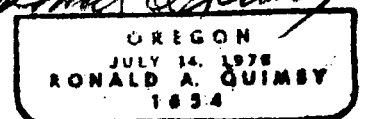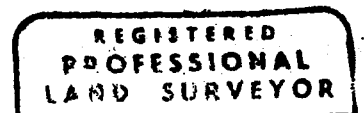

EXP 12-31-20

C.S. File 65/106-4