

FILED
Date: 5/5/2020 By: JC
This survey consists of:

CORNER REPORT FORM

Section 35 Township 34S Range SW
Douglas County Date 3-2020
PLSS Number 47B 700

Map: _____
Narrative: _____
Corner Rpt: CS 65/106-5

DOUGLAS COUNTY
SURVEYOR

CORNER DESIGNATION

See Cor 34/35
3

- Condition Report only
- Not Found
- Renewed
- Unrecorded
- Surveyed In
- Referenced out

Previous Renewals/Surveys, etc:

BLM Resurvey 1966-1968 V35 Pg 14360-61
DCSO 2013 CS 67/38-20

Monument(s) & Accessories Found: (Condition and Source)

BLM BRASS CAP
21" FIR STAMP N 57°W 25' (BURNT)
12" LIVE OAK N 30°E 58 1/2 FT GOOD SCAR
26" D FIR S 9W 47 1/2 FT GOOD SCAR
9" MANDRAKE S 31°W 28' FT GOOD SCAR
BRASS CAP SEE COR 2-3 ONLY EAST 97 1/2 FT

Monument Detail

Sketch

U.S. DEPT OF THE INTERIOR
UNLAWFUL TO DISTURB
T30 S R5W
534/535
S 3
T31 S R5W
CADASTRAL SURVEY
BUR OF LAND MANAGEMENT

Monument Set (Procedures and Description)

New Accessories

5' Alum post 15° west
5' Alum post 2° North

Surveyor's Seal



Location & Comments

Compass Declination 15 1/2° E
Firm/Agency: i.e. Engineering, Inc.
Address: 809 SE Pine St., Roseburg, OR 97470

Party Chief: N. Fromdah

Notes:

Witness: L. Hedders

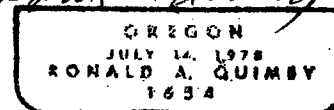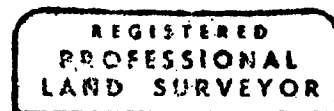

EXP 12-31-20

C.S. File 65/106-5