

FILED

Date: 5/14/2020 By: SC

This survey consists of:

Map: _____

Narrative: _____

Corner Rpt: CS 65/106-13

CORNER INVESTIGATION REPORT

DOUGLAS COUNTY
SURVEYOR

FS INDEX ID: S-18

CORNER: NORTHWEST 1/16 GCDB ID: 520260 DATE: 2/10/2020
TOWNSHIP: 31 S STATE: OREGON
RANGE: 2 W COUNTY: DOUGLAS
SECTION: 26 FOREST: UMPQUA
MERIDIAN: WILLAMETTE DISTRICT: TILLER

HISTORY OF VISITATIONS:

(1) 1972 - W.S. BARNES, M42-69

NFSL PROPERTY BOUNDARY CORNER?: YES NO

LINE(S) POSTED: SOUTH - 1972 WEST - 1972

MAINTAINED: SOUTH - 1981 WEST - 2018

GUARD POST(S): SOUTH - 4.5 FT WEST - 4.1 FT

CORNER HISTORY:

(1) ESTABLISHED CORNER BY SURVEY, SET IRON PIPE/BRASS CAP WITH 2 BT'S.

REGISTERED
PROFESSIONAL
LAND SURVEYOR

Jonathan B. Drew II

OREGON
DECEMBER 3, 2014
JONATHAN B. DREW II
89396

EXPIRES: 6/30/2021

MONUMENT FOUND/SET:

A 2-1/2" GALVANIZED IRON PIPE WITH A 3" BRASS CAP, PROJECTING 8 INCHES ABOVE THE GROUND.

RECORD MEASUREMENTS:

RECORD CORNER ACCESSORIES:

A 31" MADRONE WITH A HEALED DOUBLE BLAZE. (RECORD, (1)OAK)

(1)N66°30'E - 87.9 FT

A 21" PINE SNAG WITH A HEALED DOUBLE BLAZE.

(1)S1°30'W - 30.9 FT

NEW CORNER ACCESSORIES:

NO NEW ACCESSORIES ADDED.


METHOD OF MEASUREMENT:

NO NEW MEASUREMENTS TAKEN,
FILED AS CONDITION REPORT.

CORNER MAINTENANCE/OTHER INFO:

CLEAR BRUSH FROM AROUND MONUMENT & TO BT'S, BT FACES & A 6" BAND AT HEAD HEIGHT PAINTED RED. ADD NEW NAILS TO BT TAGS & ADD NEW TAGS WHERE NEEDED. MONUMENT SIZES ARE OUTSIDE DIAMETER & BT DIAMETERS ARE AT BREST HEIGHT.

CAP DIAGRAM:

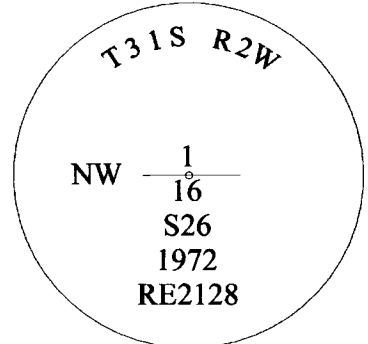

NFSL LINES BEAR: (1)S0°31'47"W - 1321.67 FT & (1)S89°35'00"W - 1313.62 FT

GEODETIC COORDINATES:

LATITUDE: N 42° 51' 15.005"

LONGITUDE: W 122° 55' 04.605"

ELLIPSOID HEIGHT:

DATUM: WGS 84

SOURCE: USFS OWNERSHIP GIS LAYER, FOR NAVIGATION TO THE CORNER.

DATE OF INVESTIGATION: 5/17/2018

REPORT BY: JONATHAN B. DREW II, PLS# 89396

FIELD CREW: JACOB HUNT, USFS SURVEY TECH
ANDREW HILLMAN, USFS SURVEY TECH

DOCUMENTS ON FILE AT:

WILLAMETTE NATIONAL FOREST
3106 PIERCE PARKWAY, STE D
SPRINGFIELD, OREGON 97477

THIS DOCUMENT FILED IN CS OFFICE: YES
OTHER DOCUMENT FILED WITH CS: NONE

C.S. FILE 65/106-13