

FILED

Date: 5/14/2020 By: SC
This survey consists of:
Map: _____
Narrative: _____
Corner Rpt: CS 65/106-16

**DOUGLAS COUNTY
SURVEYOR**

CORNER INVESTIGATION REPORT

FS INDEX ID: V-18

CORNER: WEST 1/16 GCDB ID: 520200 DATE: 2/10/2020
TOWNSHIP: 31 S STATE: OREGON
RANGE: 2 W COUNTY: DOUGLAS
SECTION: 26 & 35 FOREST: UMPQUA
MERIDIAN: WILLAMETTE DISTRICT: TILLER

HISTORY OF VISITATIONS:
(1) 1972 - W.S. BARNES, M42-69 & M42-72

NFSL PROPERTY BOUNDARY CORNER?: YES NO

LINE(S) POSTED: SOUTH - 1972 EAST - 1972

MAINTAINED: SOUTH - 2018 EAST - 1981

GUARD POST(S): EAST - 6.0 FT

CORNER HISTORY:

(1) ESTABLISHED CORNER BY SURVEY, SET IRON PIPE/BRASS CAP WITH 2 BT'S.

REGISTERED
PROFESSIONAL
LAND SURVEYOR

Jonathan B. Drew II

OREGON
DECEMBER 3, 2014
JONATHAN B. DREW II
89396

MONUMENT FOUND/SET:

A 2-1/2" ALUMINUM PIPE WITH A 3" ALUMINUM CAP, PROJECTING 4 INCHES ABOVE THE GROUND.

EXPIRES: 6/30/2021

RECORD CORNER ACCESSORIES:

A 27" FIR BEARS, N2°W - 19.6 FT, WITH A HEALED DOUBLE BLAZE.

(1)N2°W - 21.9 FT

A 20" BURNED FIR SNAG BEARS, S19°30'W - 18.3 FT, WITH A HEALED DOUBLE BLAZE.

(1)S18°W - 18.8 FT

RECORD MEASUREMENTS:

NEW CORNER ACCESSORIES:

A 16" FIR BEARS, N82°15'W - 34.0 FT, MARKED "W1/16S26" "BT" ON A DOUBLE BLAZE.

METHOD OF MEASUREMENT:


TRIMBLE S7 TOTAL STATION,
HOLD RECROD BEARING, N2°W, TO
THE CENTER OF THE NORTHWEST BT.
BEARINGS MEASURED TO CENTER AND
DISTANCES MEASURED TO AN
ALUMINUM NAIL SET AT SIDE CENTER.

NEW BT'S INCLUDE A 3/4" BRASS WASHER MARKED "OR PLS 89396" NAILED FLUSH IN THE LOWER BLAZE BETWEEN THE "B" & "T" MARKS.

CORNER MAINTENANCE/OTHER INFO:

CLEAR BRUSH FROM AROUND MONUMENT & TO BT'S, BT FACES & A 6" BAND AT HEAD HEIGHT PAINTED RED. ADD NEW NAILS TO BT TAGS & ADD NEW TAGS WHERE NEEDED. MONUMENT SIZES ARE OUTSIDE DIAMETER & BT DIAMETERS ARE AT BREST HEIGHT.

CAP DIAGRAM:

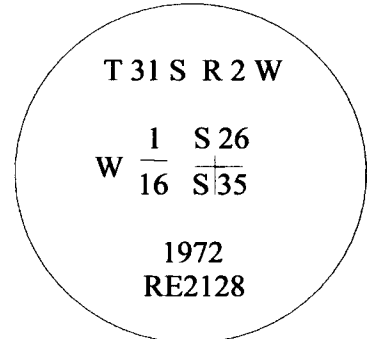

NFSL LINES BEAR: (1)S89°33'40"E - 1317.54 FT & (1)S00°09'44"W - 2629.42 FT

GEODETIC COORDINATES:

LATITUDE: N 42° 50' 35.601"

LONGITUDE: W 122° 55' 04.845"

ELLIPSOID HEIGHT:

DATUM: WGS84

SOURCE: USFS OWNERSHIP GIS LAYER, FOR NAVIGATION TO THE CORNER.

DATE OF INVESTIGATION: 05/16/2018

REPORT BY: JONATHAN B. DREW II, PLS# 89396

FIELD CREW: JACOB HUNT, USFS SURVEY TECH
ANDREW HILLMAN, USFS SURVEY TECH

DOCUMENTS ON FILE AT:

WILLAMETTE NATIONAL FOREST
3106 PIERCE PARKWAY, STE D
SPRINGFIELD, OREGON 97477

THIS DOCUMENT FILED IN CS OFFICE: YES

OTHER DOCUMENT FILED WITH CS: NONE

C.S. FILE 65/106-16