

FILED

Date: 5/14/2020 By: JC

This survey consists of:

Map: _____

Narrative: _____

Corner Rpt: CS 65/106-20

**DOUGLAS COUNTY
SURVEYOR**

CORNER INVESTIGATION REPORT

FS INDEX ID: L-5

CORNER: 1/4 GCDB ID: 200440 DATE: 2/10/2020

TOWNSHIP: 32 S STATE: OREGON

RANGE: 1 W COUNTY: DOUGLAS

SECTION: 17 & 18 FOREST: UMPQUA

MERIDIAN: WILLAMETTE DISTRICT: TILLER

NFSL PROPERTY BOUNDARY CORNER?: YES NO

LINE(S) POSTED: NORTH - 1980 SOUTH - 1980

MAINTAINED: NORTH - 2018 SOUTH - 1989

GUARD POST(S): SOUTH - 7.5 FT NORTH - 3.5 FT EAST - 2.0 FT

CORNER HISTORY:

- (1) ESTABLISHED CORNER, SET STONE & 2 BT'S.
- (2) CORNER NOT FOUND, FOUND MOUND OF STONE & STAKE AT APPROX. COR.
- (3) RE-ESTABLISHED CORNER BY SURVEY, SET IRON PIPE/BRASS CAP & 2 BT'S.
- (4) FOUND IRON PIPE/BRASS CAP & 2 BT'S.
- (5) FOUND BRASS CAP & 2 BT'S, MARKS 3 NEW BT'S.

MONUMENT FOUND/SET:

A 2-1/2" IRON PIPE WITH A 3" BRASS CAP, PROJECTING 2 INCHES ABOVE A COLLAR OF STONE.

RECORD CORNER ACCESSORIES:

NO TRACE FOUND OF A (1)8" FIR.

NO TRACE FOUND OF A (1)4" FIR.

A 26" FIR WITH A HEALED DOUBLE BLAZE.

A 20" FIR WITH A HEALED DOUBLE BLAZE.

A 9" CEDAR WITH SCRIBE VISIBLE ON A PARTIALLY HEALED SINGLE BLAZE.

A 8" CEDAR WITH SCRIBE VISIBLE ON A PARTIALLY HEALED SINGLE BLAZE.

A 8" MAPLE WITH A HEALED SINGLE BLAZE.

NEW CORNER ACCESSORIES:

NO NEW ACCESSORIES ADDED.

CORNER MAINTENANCE/OTHER INFO:

CLEAR BRUSH FROM AROUND MONUMENT & TO BT'S, BT FACES & A 6" BAND AT HEAD HEIGHT PAINTED RED. ADD NEW NAILS TO BT TAGS & ADD NEW TAGS WHERE NEEDED. MONUMENT SIZES ARE OUTSIDE DIAMETER & BT DIAMETERS ARE AT BREST HEIGHT.

NFSL LINES BEAR: (3)N1°10'18.8"E - 2488.63 FT & (3)S1°10'18.8"W - 2488.63 FT

GEODETIC COORDINATES:

LATITUDE: N 42° 47' 18.855"

LONGITUDE: W 122° 51' 12.653"

ELLIPSOID HEIGHT:

DATUM: WGS84

SOURCE: CONSUMER GRADE GPS, FOR NAVIGATION TO THE CORNER.

DATE OF INVESTIGATION: 05/07/2018

REPORT BY: JONATHAN B. DREW II, PLS# 89396

FIELD CREW: JACOB HUNT, USFS SURVEY TECH
ANDREW HILLMAN, USFS SURVEY TECH

DOCUMENTS ON FILE AT:

WILLAMETTE NATIONAL FOREST
3106 PIERCE PARKWAY, STE D
SPRINGFIELD, OREGON 97477

HISTORY OF VISITATIONS:

- (1) 1883 - R.S. MOORE, GLO SURVEY
- (2) 1968 - J.M. POWELL, CS 54/71
- (3) 1980 - B. SHANER, M79-68
- (4) 1989 - G.V. NYGREN, USFS CORNER CARD
- (5) 2004 - R. WYTCHERLY, M144-49

REGISTERED
PROFESSIONAL
LAND SURVEYOR

Jonathan B. Drew II

OREGON
DECEMBER 3, 2014
JONATHAN B. DREW II
89396

EXPIRES: 6/30/2021


RECORD MEASUREMENTS:

- (1)N83°E - 11.22 FT
- (1)N52°W - 21.78 FT
- (3,4,5)S77°W - 17.9 FT
- (3,4,5)S24°E - 26.0 FT
- (5)N74°E - 25.1 FT
- (5)N21°W - 8.7 FT
- (5)N74°W - 18.7 FT

METHOD OF MEASUREMENT:

NO NEW MEASUREMENTS TAKEN,
FILED AS CONDITION REPORT.

CAP DIAGRAM:

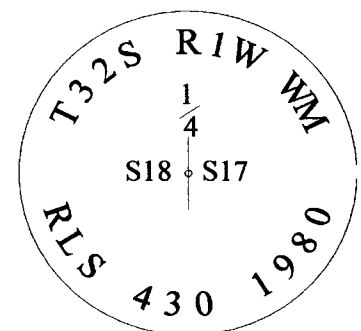

THIS DOCUMENT FILED IN CS OFFICE: YES
OTHER DOCUMENT FILED WITH CS: NONE

C.S. FILE 65/106-20