

FILED

Date: 5/26/2020 By: JC

This survey consists of:

Map: _____

Narrative: _____

Corner Rpt: CS 65/106-23

DOUGLAS COUNTY SURVEYOR

CORNER INVESTIGATION REPORT

FS INDEX ID: N-7

CORNER: 1/4 GCDB ID: 240400 DATE: 2/10/2020
 TOWNSHIP: 32 S STATE: OREGON
 RANGE: 1 W COUNTY: DOUGLAS & JACKSON
 SECTION: 17 & 20 FOREST: UMPQUA
 MERIDIAN: WILLAMETTE DISTRICT: TILLER

NESL PROPERTY BOUNDARY CORNER?: YES NO

LINE(S) POSTED: EAST - 1980 WEST - 1980

MAINTAINED: EAST - NONE WEST - 2018

GUARD POST(S): WEST - 3.0 FT

CORNER HISTORY:

- (1) ESTABLISHED CORNER, SET WOOD POST WITH 2 BT'S.
- (2) DOES NOT FIND CORNER
- (3) RE-ESTABLISHED CORNER, IN ERROR, VOIDED CORNER & RESET IN (4).
- (4) RE-ESTABLISHED CORNER, SET IRON PIPE/BRASS CAP WITH 2 NEW BT'S.
- (5,6) FOUND IRON PIPE/BRASS CAP & 2 BT'S, ALSO FINDS 1/2" IRON PIN FOR RM.
- (7) FOUND IRON PIPE/BRASS CAP & 2 BT'S, MARKS 1 NEW BT.
- (8) FOUND IRON PIPE/BRASS CAP & 2 BT'S, MARKS 1 NEW BT.

MONUMENT FOUND/SET:

A 2-1/2" IRON PIPE WITH A 3" BRASS CAP, PROJECTING 2 INCHES ABOVE THE GROUND.

RECORD CORNER ACCESSORIES:

NO TRACE FOUND OF A (1)30" CEDAR.
NO TRACE FOUND OF A (1)14" FIR.

A ROOTHOLE IN APPROXIMATE POSITION OF A (4)11" FIR.

A 14" CEDAR WITH A HEALED SINGLE BLAZE.

NO TRACE FOUND OF A (5)1/2" IRON PIN.

A 15" FIR WITH A HEALED SINGLE BLAZE.

A 23" CEDAR WITH SCRIBE VISIBLE ON A PARTIALLY HEALED SINGLE BLAZE.

NEW CORNER ACCESSORIES:

NO NEW ACCESSORIES ADDED.

CORNER MAINTENANCE/OTHER INFO:

CLEAR BRUSH FROM AROUND MONUMENT & TO BT'S, BT FACES & A 6" BAND AT HEAD HEIGHT PAINTED RED. ADD NEW NAILS TO BT TAGS & ADD NEW TAGS WHERE NEEDED. MONUMENT SIZES ARE OUTSIDE DIAMETER & BT DIAMETERS ARE AT BREAST HEIGHT.

NFSL LINES BEAR: (4)S85°34'19"E - 2660.69 FT & (4)N85°34'19"W - 2660.69 FT

GEODETIC COORDINATES:

LATITUDE: N 42° 46' 52.350"

LONGITUDE: W 122° 50' 38.265"

ELLIPSOID HEIGHT:

DATUM: WGS84

SOURCE: CONSUMER GRADE GPS, FOR NAVIGATION TO THE CORNER.

DATE OF INVESTIGATION: 05/09/2018

REPORT BY: JONATHAN B. DREW II, PLS# 89396

FIELD CREW: JACOB HUNT, USFS SURVEY TECH
ANDREW HILLMAN, USFS SURVEY TECH

DOCUMENTS ON FILE AT:

WILLAMETTE NATIONAL FOREST
3106 PIERCE PARKWAY, STE D
SPRINGFIELD, OREGON 97477

HISTORY OF VISITATIONS:

- (1) 1883 - R.S. MOORE, GLO SURVEY
- (2) 1955 - H. THIELSEN, GLO RESURVEY
- (3) 1974 - B.W. HOLT, M49-71
- (4) 1979 - B.W. HOLT, M70-72 & JACKSON CS# 7885
- (5) 1980 - E. MCGINTY, JACKSON CS# 8420
- (6) 1984 - E. MCGINTY, JACKSON CS# 10067
- (7) 2003 - L. HERZSTEIN, CS 65/48-24A&B
- (8) 2014 - K. HOFFINE, CS 65/82-32

REGISTERED PROFESSIONAL LAND SURVEYOR

Jonathan B. Drew II

OREGON
DECEMBER 3, 2014
JONATHAN B. DREW II
89396

EXPIRES: 6/30/2021


RECORD MEASUREMENTS:

- (1)N30°E - 15.84 FT
- (1)S30°W - 5.28 FT
- (4,7)N89°W - 7.6 FT, (5)N86°W
- (4,7)S13°W - 13.2 FT, (5)S15°W,
- (8)S13°W - 13.35 FT
- (5)S78°W - 13.31 FT
- (7)N3°15'E - 9.1 FT, (8)N2°45'W - 9.0 FT
- (8)S10°45'W - 20.45 FT

METHOD OF MEASUREMENT:

NO NEW MEASUREMENTS TAKEN,
FILED AS CONDITION REPORT.

CAP DIAGRAM:

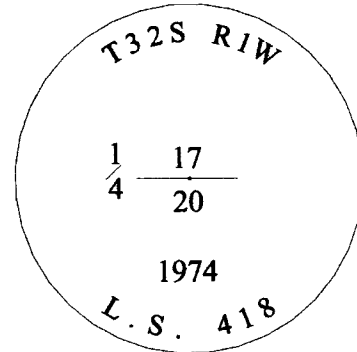

THIS DOCUMENT FILED IN CS OFFICE: YES
OTHER DOCUMENT FILED WITH CS: NONE

C.S. FILE 65/106-23