

FILED

Date: 5/24/2020 By: JC

This survey consists of:

Map: _____

Narrative: _____

Corner Rpt: CS 65/106-24

DOUGLAS COUNTY SURVEYOR

CORNER INVESTIGATION REPORT

FS INDEX ID: H-21

CORNER: SOUTH 1/16 **GCDB ID:** 600520 **DATE:** 2/10/2020
TOWNSHIP: 32 S **STATE:** OREGON
RANGE: 2 W **COUNTY:** DOUGLAS
SECTION: 11 & 12 **FOREST:** UMPQUA
MERIDIAN: WILLAMETTE **DISTRICT:** TILLER
NFSL PROPERTY BOUNDARY CORNER?: YES NO
LINE(S) POSTED: SOUTH - 1976 WEST - 1976
MAINTAINED: SOUTH - 2013 WEST - 2018
GUARD POST(S): SOUTH - 3.5 FT WEST - 3.0 FT

HISTORY OF VISITATIONS:

- (1) 1976 - G.S. BAUGHMAN, M56-73
- (2) 1985 - L. MOFFIT, USFS CORNER CARD
- (3) 2013 - J. DREW II, USFS CORNER CARD

CORNER HISTORY:

- (1) ESTABLISHED CORNER BY SURVEY, SET IRON PIPE/BRASS CAP WITH 2 BT'S.
- (2) FOUND IRON PIPE/BRASS CAP WITH 2 BT'S, MARKS 1 NEW BT.
- (3) FOUND IRON PIPE/BRASS CAP WITH 3 BT'S.

MONUMENT FOUND/SET:

A 3" BRASS CAP FLUSH IN 12"x12" CONCRETE BLOCK, PROJECTING 4 INCHES ABOVE THE GROUND.

RECORD CORNER ACCESSORIES:

- A 21" FIR WITH A HEALED DOUBLE BLAZE.
- A ROOT HOLE WITH DOWNED 18" FIR STUMP AND LOG LAYS NORTH.
- A 13" FIR WITH A HEALED DOUBLE BLAZE.

NEW CORNER ACCESSORIES:

NO NEW ACCESSORIES ADDED.

CORNER MAINTENANCE/OTHER INFO:

CLEAR BRUSH FROM AROUND MONUMENT & TO BT'S, BT FACES & A 6" BAND AT HEAD HEIGHT PAINTED RED. ADD NEW NAILS TO BT TAGS & ADD NEW TAGS WHERE NEEDED. MONUMENT SIZES ARE OUTSIDE DIAMETER & BT DIAMETERS ARE AT BREAST HEIGHT.

NFSL LINES BEAR: (1)N89°04'34"W - 2620.31 FT & (1)S0°02'16"E - 1269.46 FT

GEODETIC COORDINATES:

LATITUDE: N 42° 47' 59.68"
LONGITUDE: W 122° 53' 33.86"
ELLIPSOID HEIGHT:

DOCUMENTS ON FILE AT:

WILLAMETTE NATIONAL FOREST
 3106 PIERCE PARKWAY, STE D
 SPRINGFIELD, OREGON 97477

DATUM: WGS84

SOURCE: USFS OWNERSHIP GIS LAYER, FOR NAVIGATION TO THE CORNER.

DATE OF INVESTIGATION: 5/7/2018

REPORT BY: JONATHAN B. DREW II, PLS# 89396

FIELD CREW: JACOB HUNT, USFS SURVEY TECH
 ANDREW HILLMAN, USFS SURVEY TECH

THIS DOCUMENT FILED IN CS OFFICE: YES
OTHER DOCUMENT FILED WITH CS: NONE

REGISTERED
 PROFESSIONAL
 LAND SURVEYOR

Jonathan B. Drew II

OREGON
 DECEMBER 3, 2014
 JONATHAN B. DREW II
 89396

EXPIRES: 6/30/2021


RECORD MEASUREMENTS:

- (1,2)N58°E - 25.7 FT
- (1,2)N61°W - 37.3 FT
- (2)S44°W - 18.6 FT

METHOD OF MEASUREMENT:

NO NEW MEASUREMENTS TAKEN,
 FILED AS CONDITION REPORT.

CAP DIAGRAM:

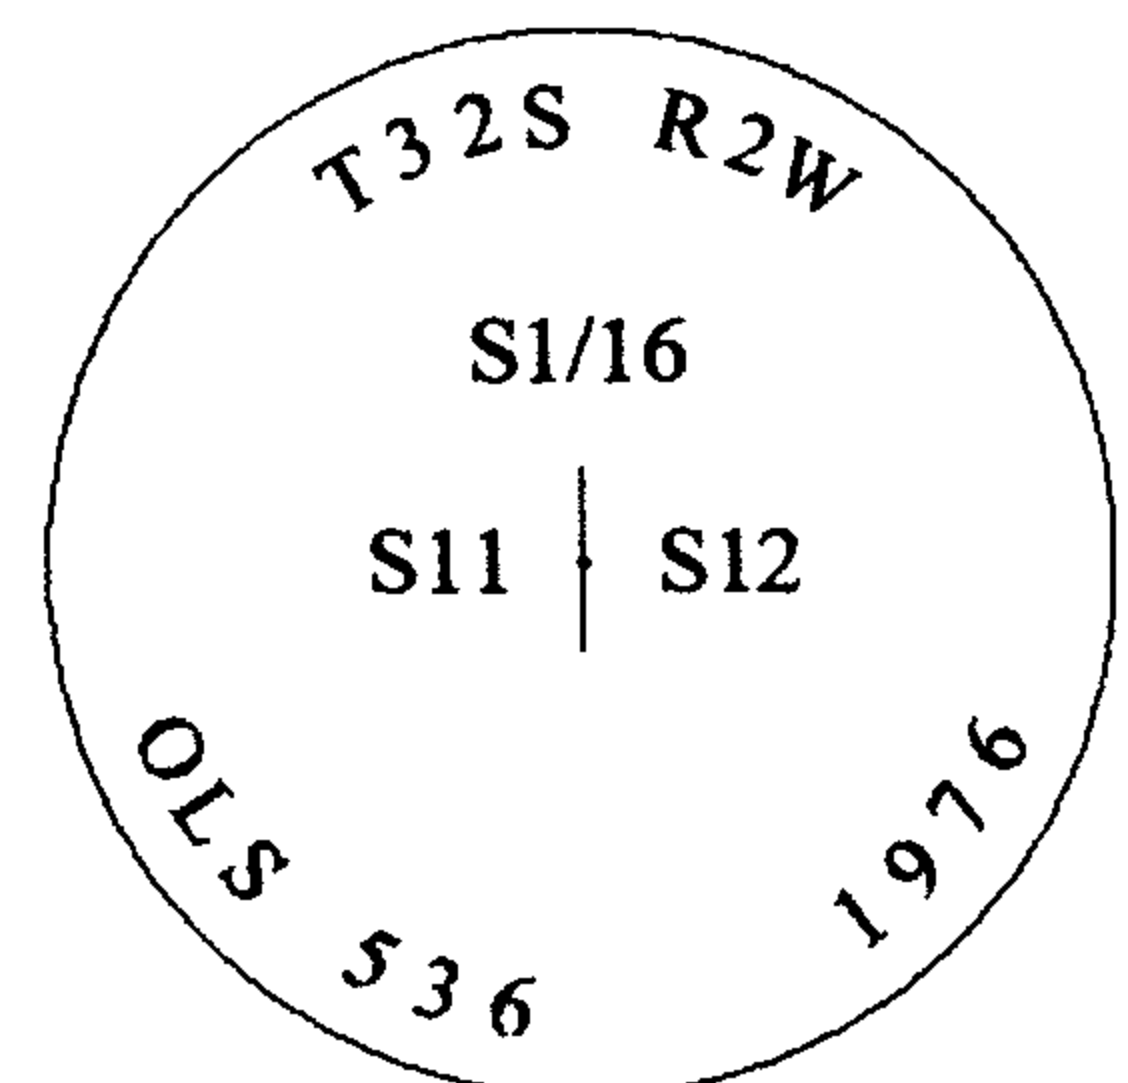

C.S. FILE 65/106-24