

FILED

Date: 5/24/2020 By: SC

This survey consists of:

Map: \_\_\_\_\_

Narrative: \_\_\_\_\_

Corner Rpt: 65/106-25

### CORNER INVESTIGATION REPORT

DOUGLAS COUNTY SURVEYOR

FS INDEX ID: H-19

CORNER: CENTER SOUTH 1/16 GCDB ID: 540520 DATE: 2/10/2020  
TOWNSHIP: 32 S STATE: OREGON  
RANGE: 2 W COUNTY: DOUGLAS  
SECTION: 11 FOREST: UMPQUA  
MERIDIAN: WILLAMETTE DISTRICT: TILLER

NESL PROPERTY BOUNDARY CORNER?:  YES  NO

LINE(S) POSTED: SOUTH - 1976 EAST - 1976

MAINTAINED: SOUTH - 1985 EAST - 2018

GUARD POST(S):

CORNER HISTORY:

- (1) ESTABLISHED CORNER BY SURVEY, SET BRASS CAP WITH 4" STEM IN ROCK WITH CONCRETE & 2 BT'S.
- (2) FOUND BRASS CAP IN 1 FT SQUARE CONCRETE BLOCK WITH 2 BT'S.

MONUMENT FOUND/SET:

A 3" BRASS CAP FLUSH IN 12"x12" CONCRETE BLOCK, PROJECTING 4 INCHES ABOVE THE GROUND.

RECORD CORNER ACCESSORIES:

- A 26" FIR WITH A HEALED DOUBLE BLAZE.
- A 12" FIR WITH A HEALED DOUBLE BLAZE.

NEW CORNER ACCESSORIES:

NO NEW ACCESSORIES ADDED.

CORNER MAINTENANCE/OTHER INFO:

CLEAR BRUSH FROM AROUND MONUMENT & TO BT'S, BT FACES & A 6" BAND AT HEAD HEIGHT PAINTED RED. ADD NEW NAILS TO BT TAGS & ADD NEW TAGS WHERE NEEDED. MONUMENT SIZES ARE OUTSIDE DIAMETER & BT DIAMETERS ARE AT BREAST HEIGHT.

NFSL LINES BEAR: (1)S89°04'34"E - 2620.31 FT & (1)S0°39'56"W - 1292.62 FT

GEODETIC COORDINATES:

LATITUDE: N 42° 48' 00.093"

LONGITUDE: W 122° 54' 09.003"

ELLIPSOID HEIGHT:

DATUM: WGS84

SOURCE: USFS OWNERSHIP GIS LAYER, FOR NAVIGATION TO THE CORNER.

DATE OF INVESTIGATION: 5/7/2018

REPORT BY: JONATHAN B. DREW II, PLS# 89396

FIELD CREW: JACOB HUNT, USFS SURVEY TECH  
ANDREW HILLMAN, USFS SURVEY TECH

DOCUMENTS ON FILE AT:

WILLAMETTE NATIONAL FOREST  
3106 PIERCE PARKWAY, STE D  
SPRINGFIELD, OREGON 97477

THIS DOCUMENT FILED IN CS OFFICE: YES  
OTHER DOCUMENT FILED WITH CS: NONE

- HISTORY OF VISITATIONS:
- (1) 1976 - G.S. BAUGHMAN, M56-73
  - (2) 1985 - L. MOFFIT, USFS CORNER CARD.

REGISTERED PROFESSIONAL LAND SURVEYOR

*Jonathan B. Drew II*

OREGON  
DECEMBER 3, 2014  
JONATHAN B. DREW II  
89396

EXPIRES: 6/30/2021


RECORD MEASUREMENTS:

- (1,2)S12°E - 46.3 FT
- (1,2)N6°E - 71.0 FT

METHOD OF MEASUREMENT:

NO NEW MEASUREMENTS TAKEN,  
FILED AS CONDITION REPORT.

CAP DIAGRAM:

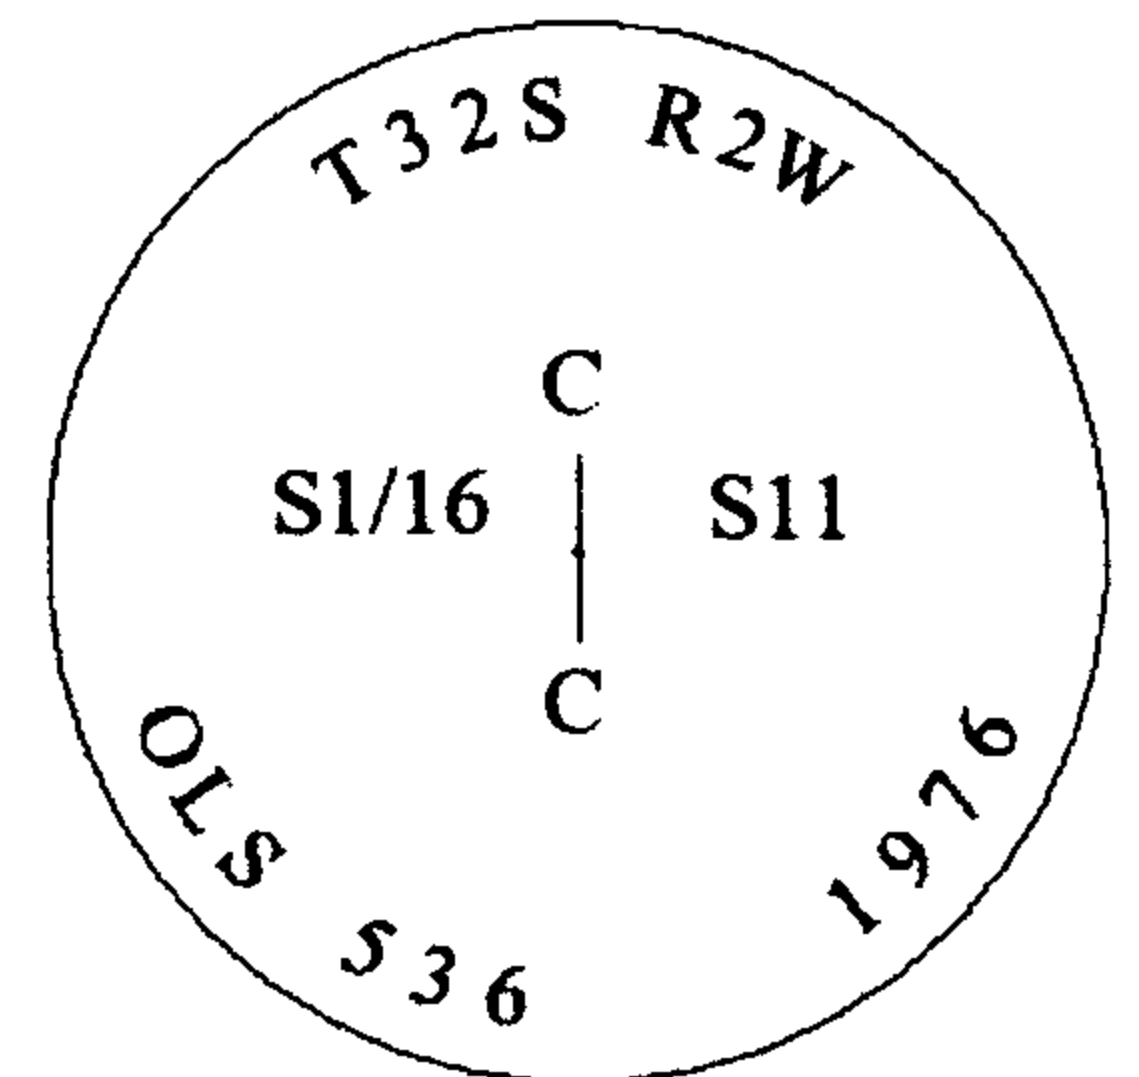

C.S. FILE 65/106-25