

FILED

Date: 6/30/2020 By: X

This survey consists of:

Map: _____

Narrative: _____
Corner Rpt: CS 65/106-28

DOUGLAS COUNTY
SURVEYOR

CORNER REPORT FORM

Section 31 Township 309 Range 2W
Douglas County Date 6-2020
PLSS Number 140200

CORNER DESIGNATION

N 1/4 sec 31 on 1/4



Condition Report only
Not Found
Renewed
Unrecorded
Surveyed In
Referenced out

Previous Renewals/Surveys, etc:

DCSO MAY 1958 CS 48/106
Johnstone DEC 1985 M 100-21

Monument(s) & Accessories Found: (Condition and Source)

ORIG. stone approx 15x8x6 with + on top
52" FIR S62°E 37' FT GOOD SCAR
15" split maple S32°W 9.9 FT

Alum. cap on 5/8" I. ROD PER M 100-21 BEARS
West S8°E FT

Monument Detail

Sketch

Monument Set (Procedures and Description)



New Accessories

Surveyor's Seal

Location & Comments

Compass Declination 15 1/2° E
Firm/Agency: i.e. Engineering, Inc.
Address: 809 SE Pine St., Roseburg, OR 97470

Party Chief: Al Fromdahl
Notes:
Witness: L. Hedden

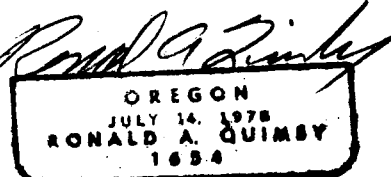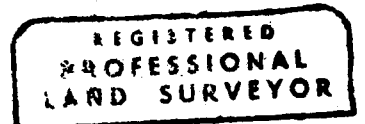

EXP 12-31-20
C.S. File 65/106-28



CS 65/106-28