

FILED

Date: 6/30/2020 By: SC

This survey consists of:

Map: _____

Narrative: _____
Corner Rpt: CS 65/106-29

DOUGLAS COUNTY
SURVEYOR

CORNER REPORT FORM

Section 36 Township 30 S Range 3 W
Douglas County Date 6-2020
PLSS Number 700140

CORNER DESIGNATION

E 1/4 S 36

- Condition Report only
- Not Found
- Renewed
- Unrecorded
- Surveyed In
- Referenced out


Previous Renewals/Surveys, etc:

MENCH 1908 Vol 16 Pgs 6796-97
DCSO 1976 CS 59/24-9

Monument(s) & Accessories Found: (Condition and Source)

BT'S TO REFERENCE MONUMENT (MAN. NOT KD)
18" W. FIR S 84 1/2° W 9.8' WITH TAG NO SCAR
Root hole S 40 1/2° E 11.9'

Monument Detail

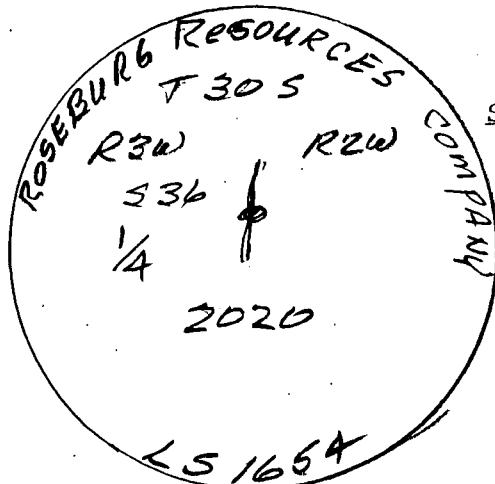

Sketch

Monument Set (Procedures and Description)

Establish Location of R.M. SET 5/8" X 30" I. ROD WITH
2 1/2" ALUM. CAP 47 3/4 FT SOUTH OF R.M NO OR 16.
Tree's TO 1/4 COR REMAIN

New Accessories

5" FIR N 27° E 14 1/2 FT scribed E 1/4 S 36 BT
18" FIR N 12° W 48 1/2 FT " " " "
Set Alum posts 5' North & 5' South

Surveyor's Seal

Location & Comments

CORNER IS APPROX
7' NORTH OF
E-W RAVIDE
ORIG LIVE TREE
STUMP NORTH
30 1/2 FT (REC
4.40 CH)

Compass Declination 15 1/2° E



Firm/Agency: i.e. Engineering, Inc.

Address: 809 SE Pine St., Roseburg, OR 97470

Party Chief: N. Fromdahl / Ronald A. Quimby

Notes:

Witness: L. Hedden

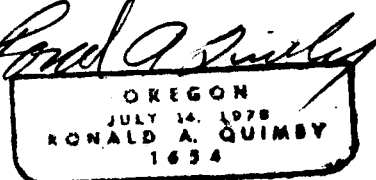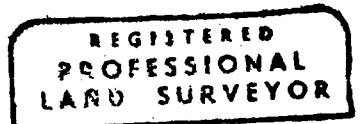

EXN 12-31-20

C.S. File 65/106-29