

FILED

Date: 6/30/2020 By: JC

This survey consists of:

Map: _____

Narrative: _____
Corner Rpt: CS 65/106-29

DOUGLAS COUNTY
SURVEYOR

CORNER REPORT FORM

Section 30 Township 30S Range 2W
Douglas County Date 6-2020
PLSS Number
100200

CORNER DESIGNATION

CC | 30
36 | 31

- Condition Report only
- Not Found
- Renewed
- Unrecorded
- Surveyed In
- Referenced out

Previous Renewals/Surveys, etc:

DCSD 1939 CS 16/11
DCSD 1958 CS 49/86

Monument(s) & Accessories Found: (Condition and Source)

3/4" I. PIPE

BRASS CAP SEC. COR 25²30 ONLY N1⁰W 46² FT

Monument Detail

Sketch

Monument Set (Procedures and Description)

New Accessories

8" Hemlock N59°E 4.1 FT Scribbled T30S R2W S30 RT
7" Hemlock N83°W 8.5 FT MARKED X
Alum posts 5' NORTH & 10' EAST

Surveyor's Seal



Location & Comments

Compass Declination 15 1/2° E
Firm/Agency: i.e. Engineering, Inc.
Address: 809 SE Pine St., Roseburg, OR 97470

Party Chief: N. From Dahl

Notes:

Witness: L. Hedden

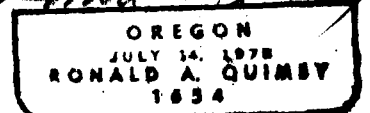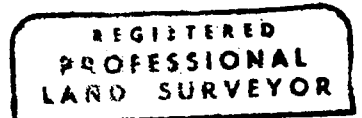

EXP 12-31-20

C.S. File 65/106-30