

FILED

Date: 6/30/2020 By: SC

This survey consists of:

Map: \_\_\_\_\_

Narrative: \_\_\_\_\_  
Corner Rpt: C565/106-34

DOUGLAS COUNTY  
SURVEYOR

CORNER REPORT FORM

Section 36 Township 30S Range 3W  
Douglas County Date 6-2020  
PLSS Number 700144

CORNER DESIGNATION

LIVE Tree

- Condition Report only
- Not Found
- Renewed
- Unrecorded
- Surveyed In
- Referenced out

Previous Renewals/Surveys, etc.:

Referred to in PLSS 700140 BY DCSO  
1976 C559/24-9

Monument(s) & Accessories Found: (Condition and Source)

55" FIR STUMP 4' TALL 301 1/2 FT NORTH OF  
1/4 COR 236 ONLY (REC N 19.40 CH 290 1/2 FT) ON  
LARGE STUMP IN THE AREA

Monument Detail

Sketch

Set 5' Alum post in center of stump

Monument Set (Procedures and Description)



New Accessories

5' Alum post 5' North & 5' South

Surveyor's Seal

Location & Comments

Compass Declination 15 1/2° E  
Firm/Agency: i.e. Engineering, Inc.  
Address: 809 SE Pine St., Roseburg, OR 97470  
Party Chief: N. Fromdahl  
Notes:  
Witness: L. Heddens

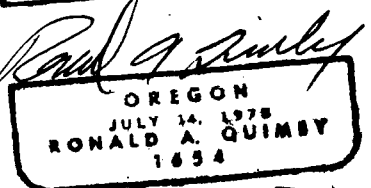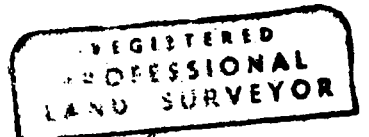

EXP 12-31-20

C.S. File 65/106-34