

FILED

Date: 6/30/2020 By: X

This survey consists of:

Map: _____

Narrative: _____

Corner Rpt: CS 65/106-36

CORNER REPORT FORM

Section 30 Township 30S Range 2W
Douglas County Date 6-2020
PLSS Number 139200

DOUGLAS COUNTY
SURVEYOR

CORNER DESIGNATION

South 1/4 S30 only

- Condition Report only
- Not Found
- Renewed
- Unrecorded
- Surveyed In
- Referenced out

Previous Renewals/Surveys, etc:


Mensch 1908 Vol 16 PG 6B14 DCSO 1940 CS 16/55
DCSO 1958 CS 49/86 Johnstone 1985 M 100-21

Monument(s) & Accessories Found: (Condition and Source)

2 1/2" ALUMI CAP ON 5/8" I. ROD
60" FIR STUMP N62°E 41' FT
23" HEMLOCK N48°E 31' FT GOOD SCAR
37" HEMLOCK N33°W 29' FT " "
GRANITE STONE N 1/4 S31 EAST 58' FT

Monument Detail

Sketch

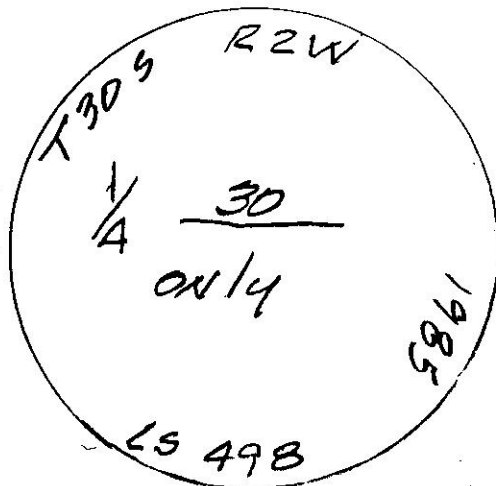

Monument Set (Procedures and Description)


New Accessories

30" CEDAR S78°W 30.1 FT scribed 1/4 S30 BT


Surveyor's Seal

Location & Comments

Compass Declination 15 1/2° E
Firm/Agency: i.e. Engineering, Inc.
Address: 809 SE Pine St., Roseburg, OR 97470

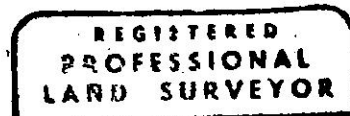

Party Chief: N. Fromdahl
Notes:
Witness: L. Hedden

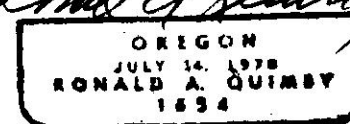

C.S. File 65/106-36



S
R
M
W
30
498
S
L
O
W
L
Y
30