

FILED

Date: 10/19/2020 By: SC

This survey consists of:

Map: \_\_\_\_\_

Narrative: \_\_\_\_\_  
Corner Rpt: CS 65/106-42

CORNER REPORT FORM

Section 4 Township 25S Range 2W  
Douglas County Date 10-2020  
PLSS Number 400640

DOUGLAS COUNTY  
SURVEYOR

CORNER DESIGNATION

1/4 COR. 54/53

- Condition Report only
- Not Found
- Renewed
- Unrecorded
- Surveyed In
- Referenced out

Previous Renewals/Surveys, etc:

BLM RESURVEY 1951-1963 Vol 32 Pg 13349

Weyco 1965 CS 53/112-1

Monument(s) & Accessories Found: (Condition and Source)

GLD BRASS CAP (stone gone)

REMNANT OF Hemlock STUMP N142°W 2'

REMNANT OF Hemlock STUMP S46°E 26'

REMNANT OF FIR STUMP S69°W 17.5 FT

Monument Detail

Sketch




Monument Set (Procedures and Description)

New Accessories

PK IN 20' TA N Blk St N64°E 36.9 FT  
5/8" 30" IR RODS WITH PLASTIC CAP STAMPED  
100 ENGINEERING WITH FOOT ALONG SIDE  
S31°E 11' FT - S54°W 7.4 FT N35°W 16.3 FT Surveyor's Seal

Location & Comments

Compass Declination 15 1/2° E  
 Firm/Agency: i.e. Engineering, Inc.  
 Address: 809 SE Pine St., Roseburg, OR 97470

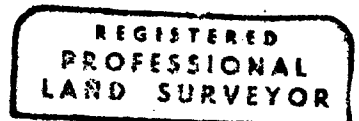


Party Chief: N. Frandahl

Notes:

Witness: L. Hedden

J. Ogden

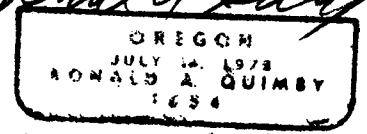

EXP 12-31-20  
C.S. File 65/106-42