

FILED

Date: 10/21/2020 By: X

This survey consists of:

Map: \_\_\_\_\_

Narrative: \_\_\_\_\_

Corner Rpt: CS 65/106-45

DOUGLAS COUNTY  
SURVEYOR

CORNER REPORT FORM

Section 10 Township 25S Range 2W  
Douglas County Date 10-2020  
PLSS Number 400542

CORNER DESIGNATION

LINE Tree

- Condition Report only
- Not Found
- Renewed
- Unrecorded
- Surveyed In
- Referenced out

Previous Renewals/Surveys, etc:

BLM Resurvey 1962 Vol 32 Pg 13229 DCSO 1977 CS 54/27  
LAND 1992 M114-57 BLM Resurvey 2014-2015 Vol 58 Pg

Monument(s) & Accessories Found: (Condition and Source)


2333B

Fd Alum. CAP ON 5/8" I. ROD IN TOP OF 24" FIR  
Stump

Monument Detail

Sketch

Monument Set (Procedures and Description)

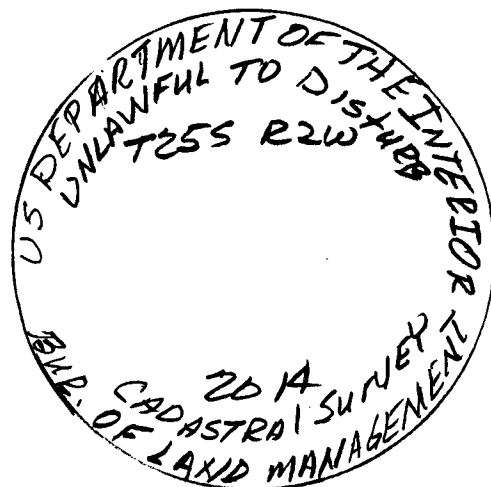

New Accessories

Set 5/8" x 30" I. RODS with plastic CAP STAMPED  
ie engineering

N 35° E 23' FT N 30° W 26' FT  
Post set along side of I. RODS

Location & Comments

AREA TURN T  
BALLY 9-2020  
CORNER IS APPROX.  
300' SOUTH OF  
ROAD

Compass Declination 15 1/2° E

Firm/Agency: i.e. Engineering, Inc.

Address:



809 SE Pine St., Roseburg, OR 97470

Party Chief: N. Fromdhal

Notes:

Witness: L. Hedden  
J. Ogden

Surveyor's Seal

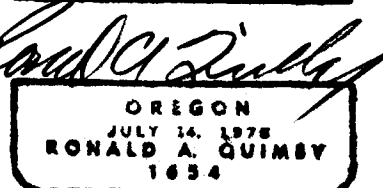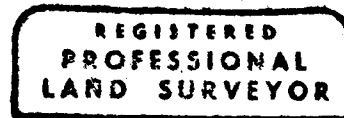

EXP 12-31-20

C.S. File 65/106-45