

RENEWAL

Monument Detail

Monument Set (Procedure and Description)

NONE


N/A

New Accessories

15" DIA MADRONE ~~BEARS N 27° W, 56.4 FT~~ "1/4 514 CS BT"

8" DIA. D. FIR DOUBLE BLAZED AND SCRIBED "YES 13 CS BT"
BEARS N 20° E, 30.1 FT

Sketch of Monument, Accessories, and General Area

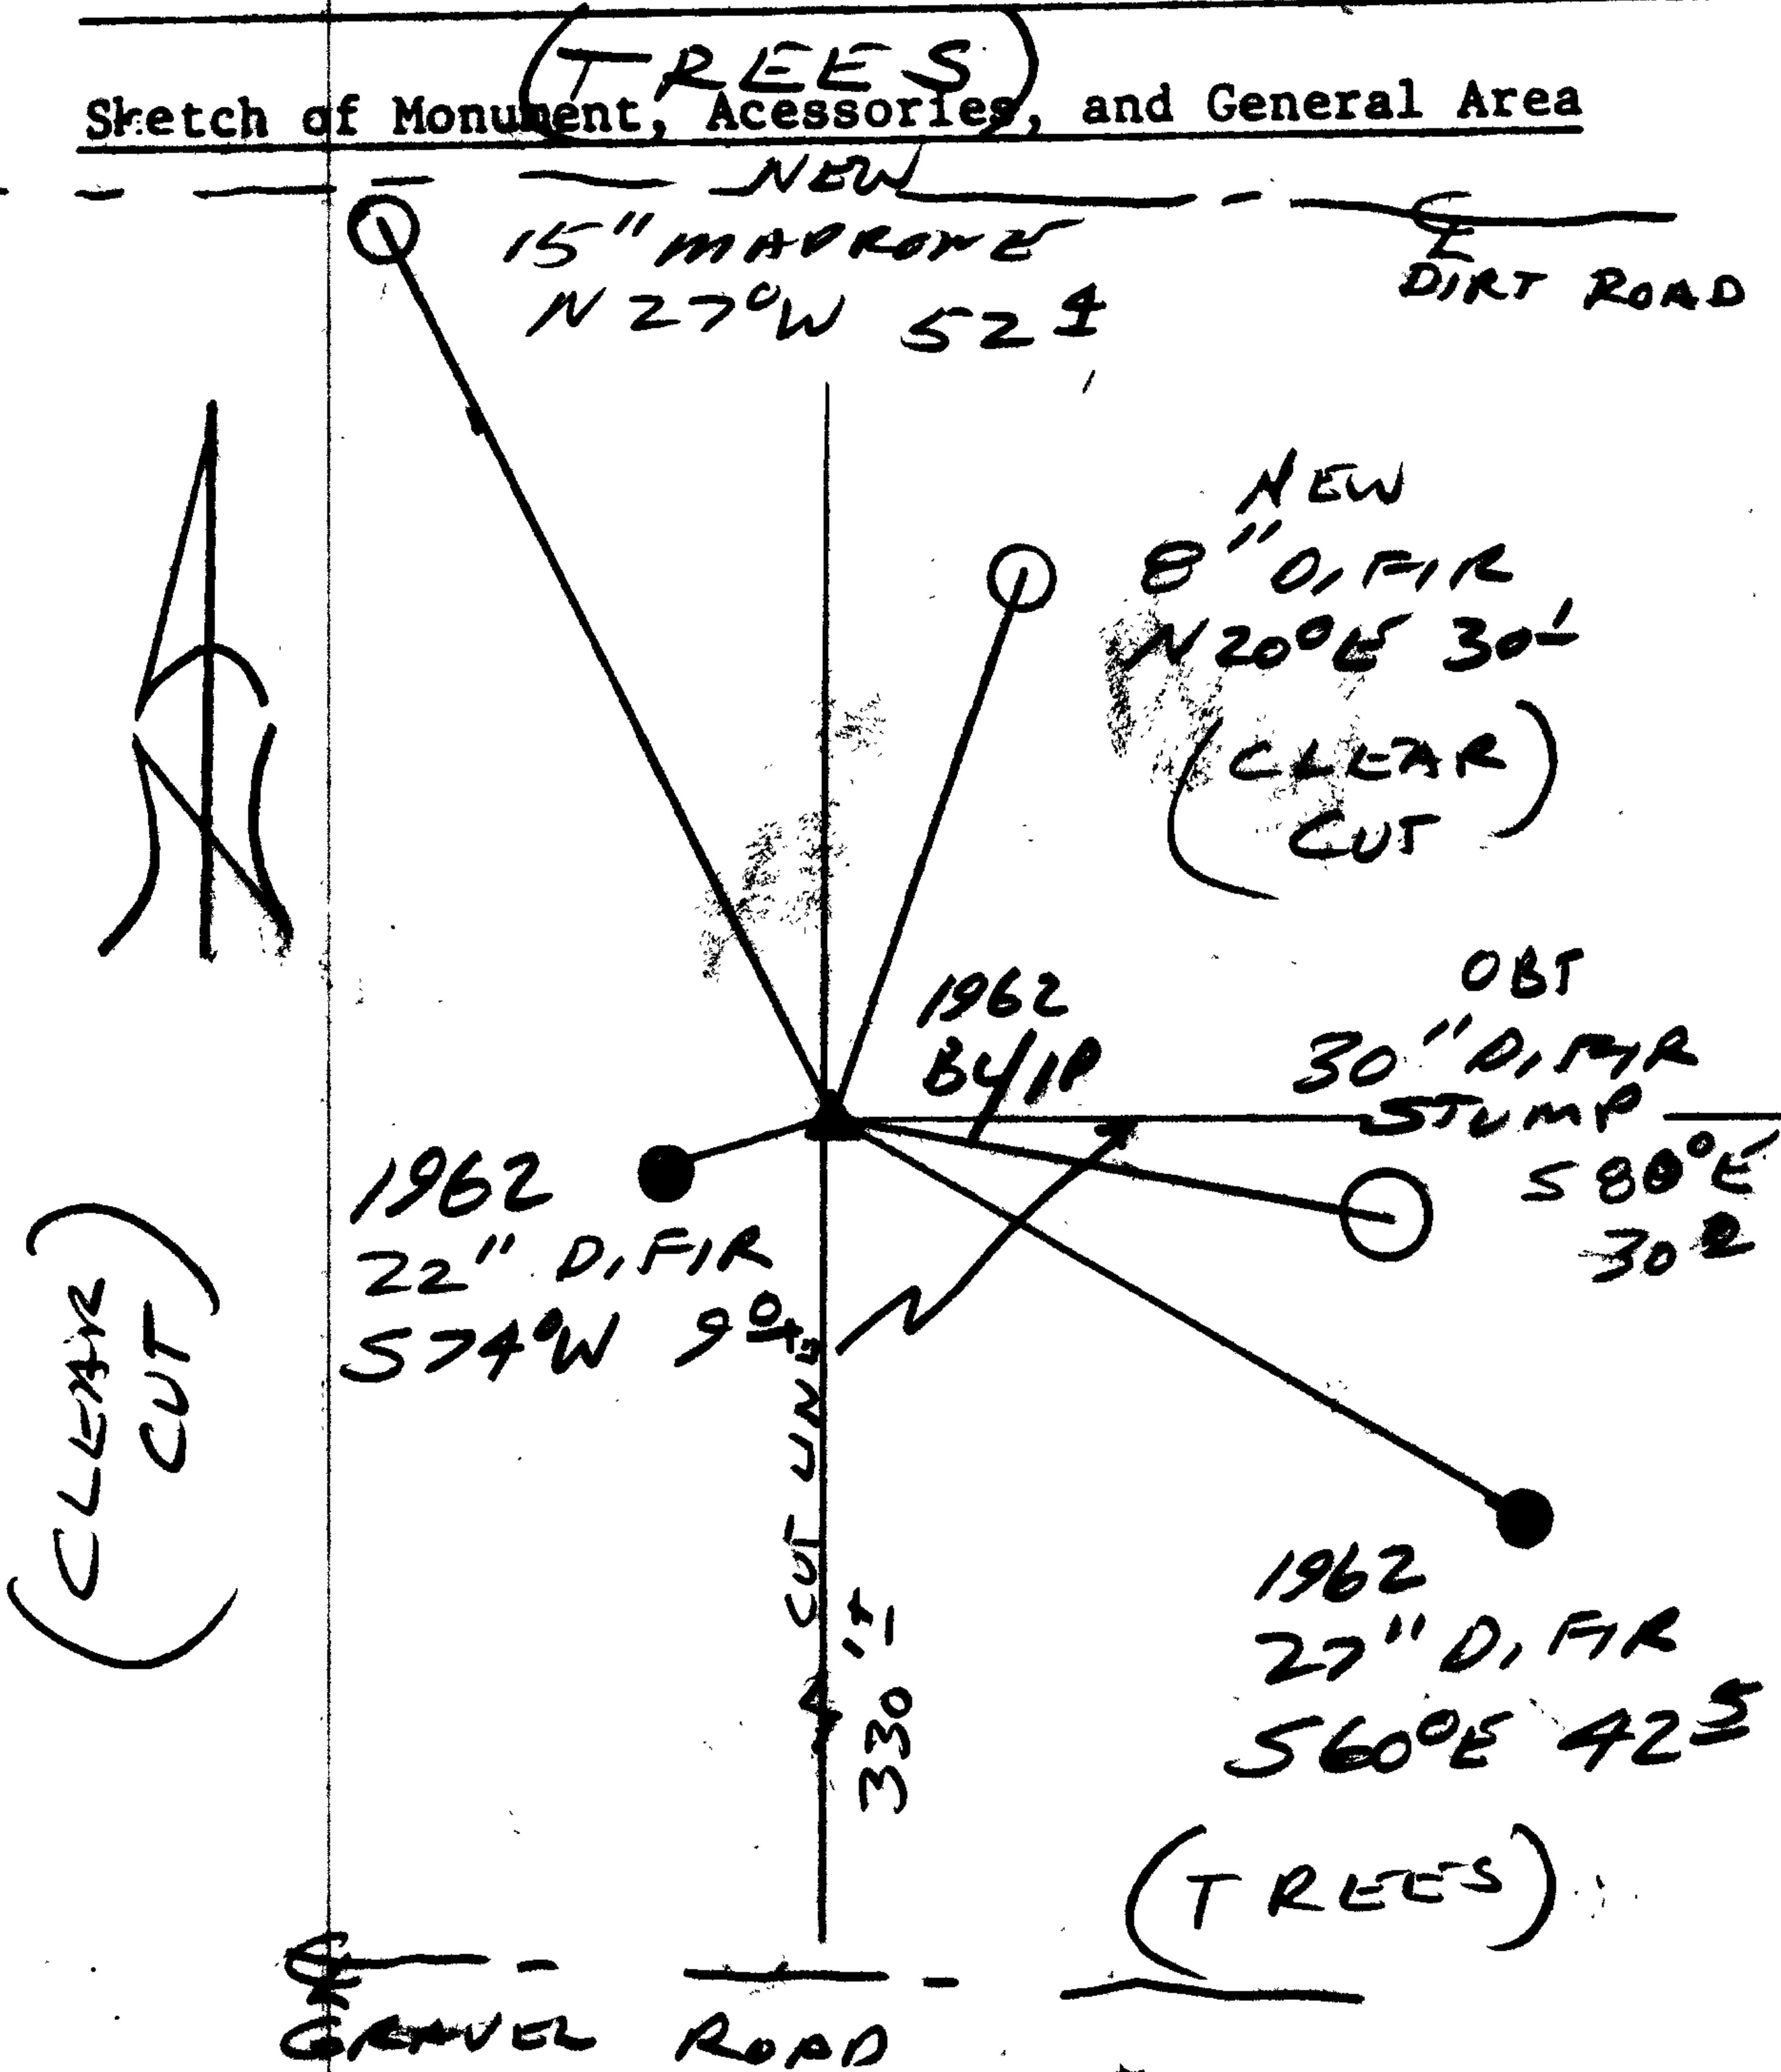


Location & Comments

Comp. Declin. 17 3/4° E
 Agency DL 50
 Party Chief MANOULLI SMITH
 Notekeeper [Signature]
 Witnesses STEPHEN FLAVS

Address

Surveyor's Seal

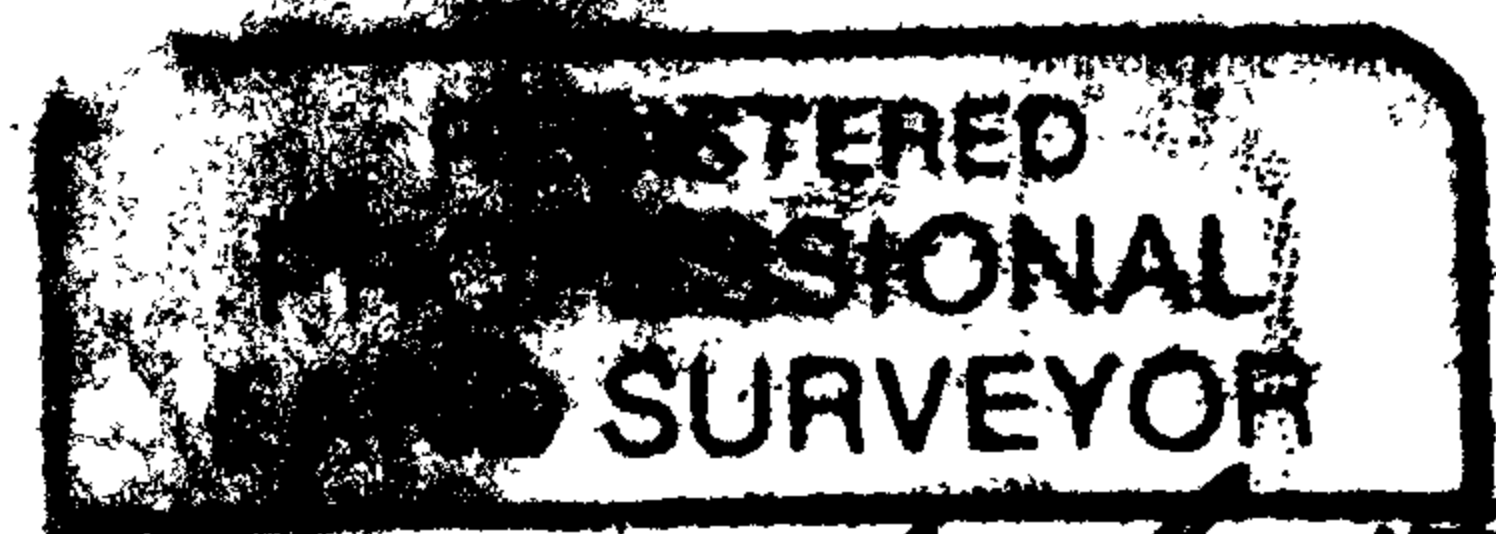

James W. Smith
 BEARS 6-30-98

