

GOVERNMENT CORNER RESTORATION FORM

Date: 3-16-1998 By: JC

Township 25S Range 7W Sec. 14 County DOUGLAS

This survey consists of:

State OR Date 3-10-98 No. \_\_\_\_\_

Map: \_\_\_\_\_

Narrative: \_\_\_\_\_

Corner Rpt: 66/2-4

Corner Designation

$\frac{1}{4} \frac{S14}{S23}$

DOUGLAS COUNTY  
Condition Report only  
SURVEYOR

Not Found

Renewed

Unrecorded

Surveyed In

Referenced Out

Previous Renewals 1968 BLM

MONUMENT DETAIL

Monument(s) Found: (Condition and Source)

3/4" DIA. BRASS CAP ON A  
2 1/2" O.D. IRON PIPE PROTRUDES  
5" ABOVE GROUND (1968)

U.S. DEPT. OF THE INTERIOR  
T 25S R 7W

$\frac{1}{4} \frac{S14}{S23}$

1968

BUR. OF LAND MANAGEMENT

Accessories Found:

9" NOW 21" DIA. D.FIR WITH A FULLY HEALED  
SINGLE BLAZE, BEARS N 30° E, 18.8 FT  
(AGREES WITH REC.) 1968

12" NOW 23" DIA. D.FIR WITH A FULLY HEALED  
SINGLE BLAZE, BEARS S 33° E, 25.4 FT  
(AGREES WITH REC.) 1968

RENEWAL

Monument Set (Procedure and Description)

Monument Detail

NONE

N/A


New Accessories

18" DIA. D. FIR DOUBLE BLAZED AND SCRIBED "Y4523CS BT"  
BEARS S 68° W, 20.5 FT

7" DIA. I. CEDAR DOUBLE BLAZED AND SCRIBED "Y4523CS BT"  
BEARS N 112° E, 36.4 FT

Sketch of Monument, Accessories, and General Area

Location & Comments

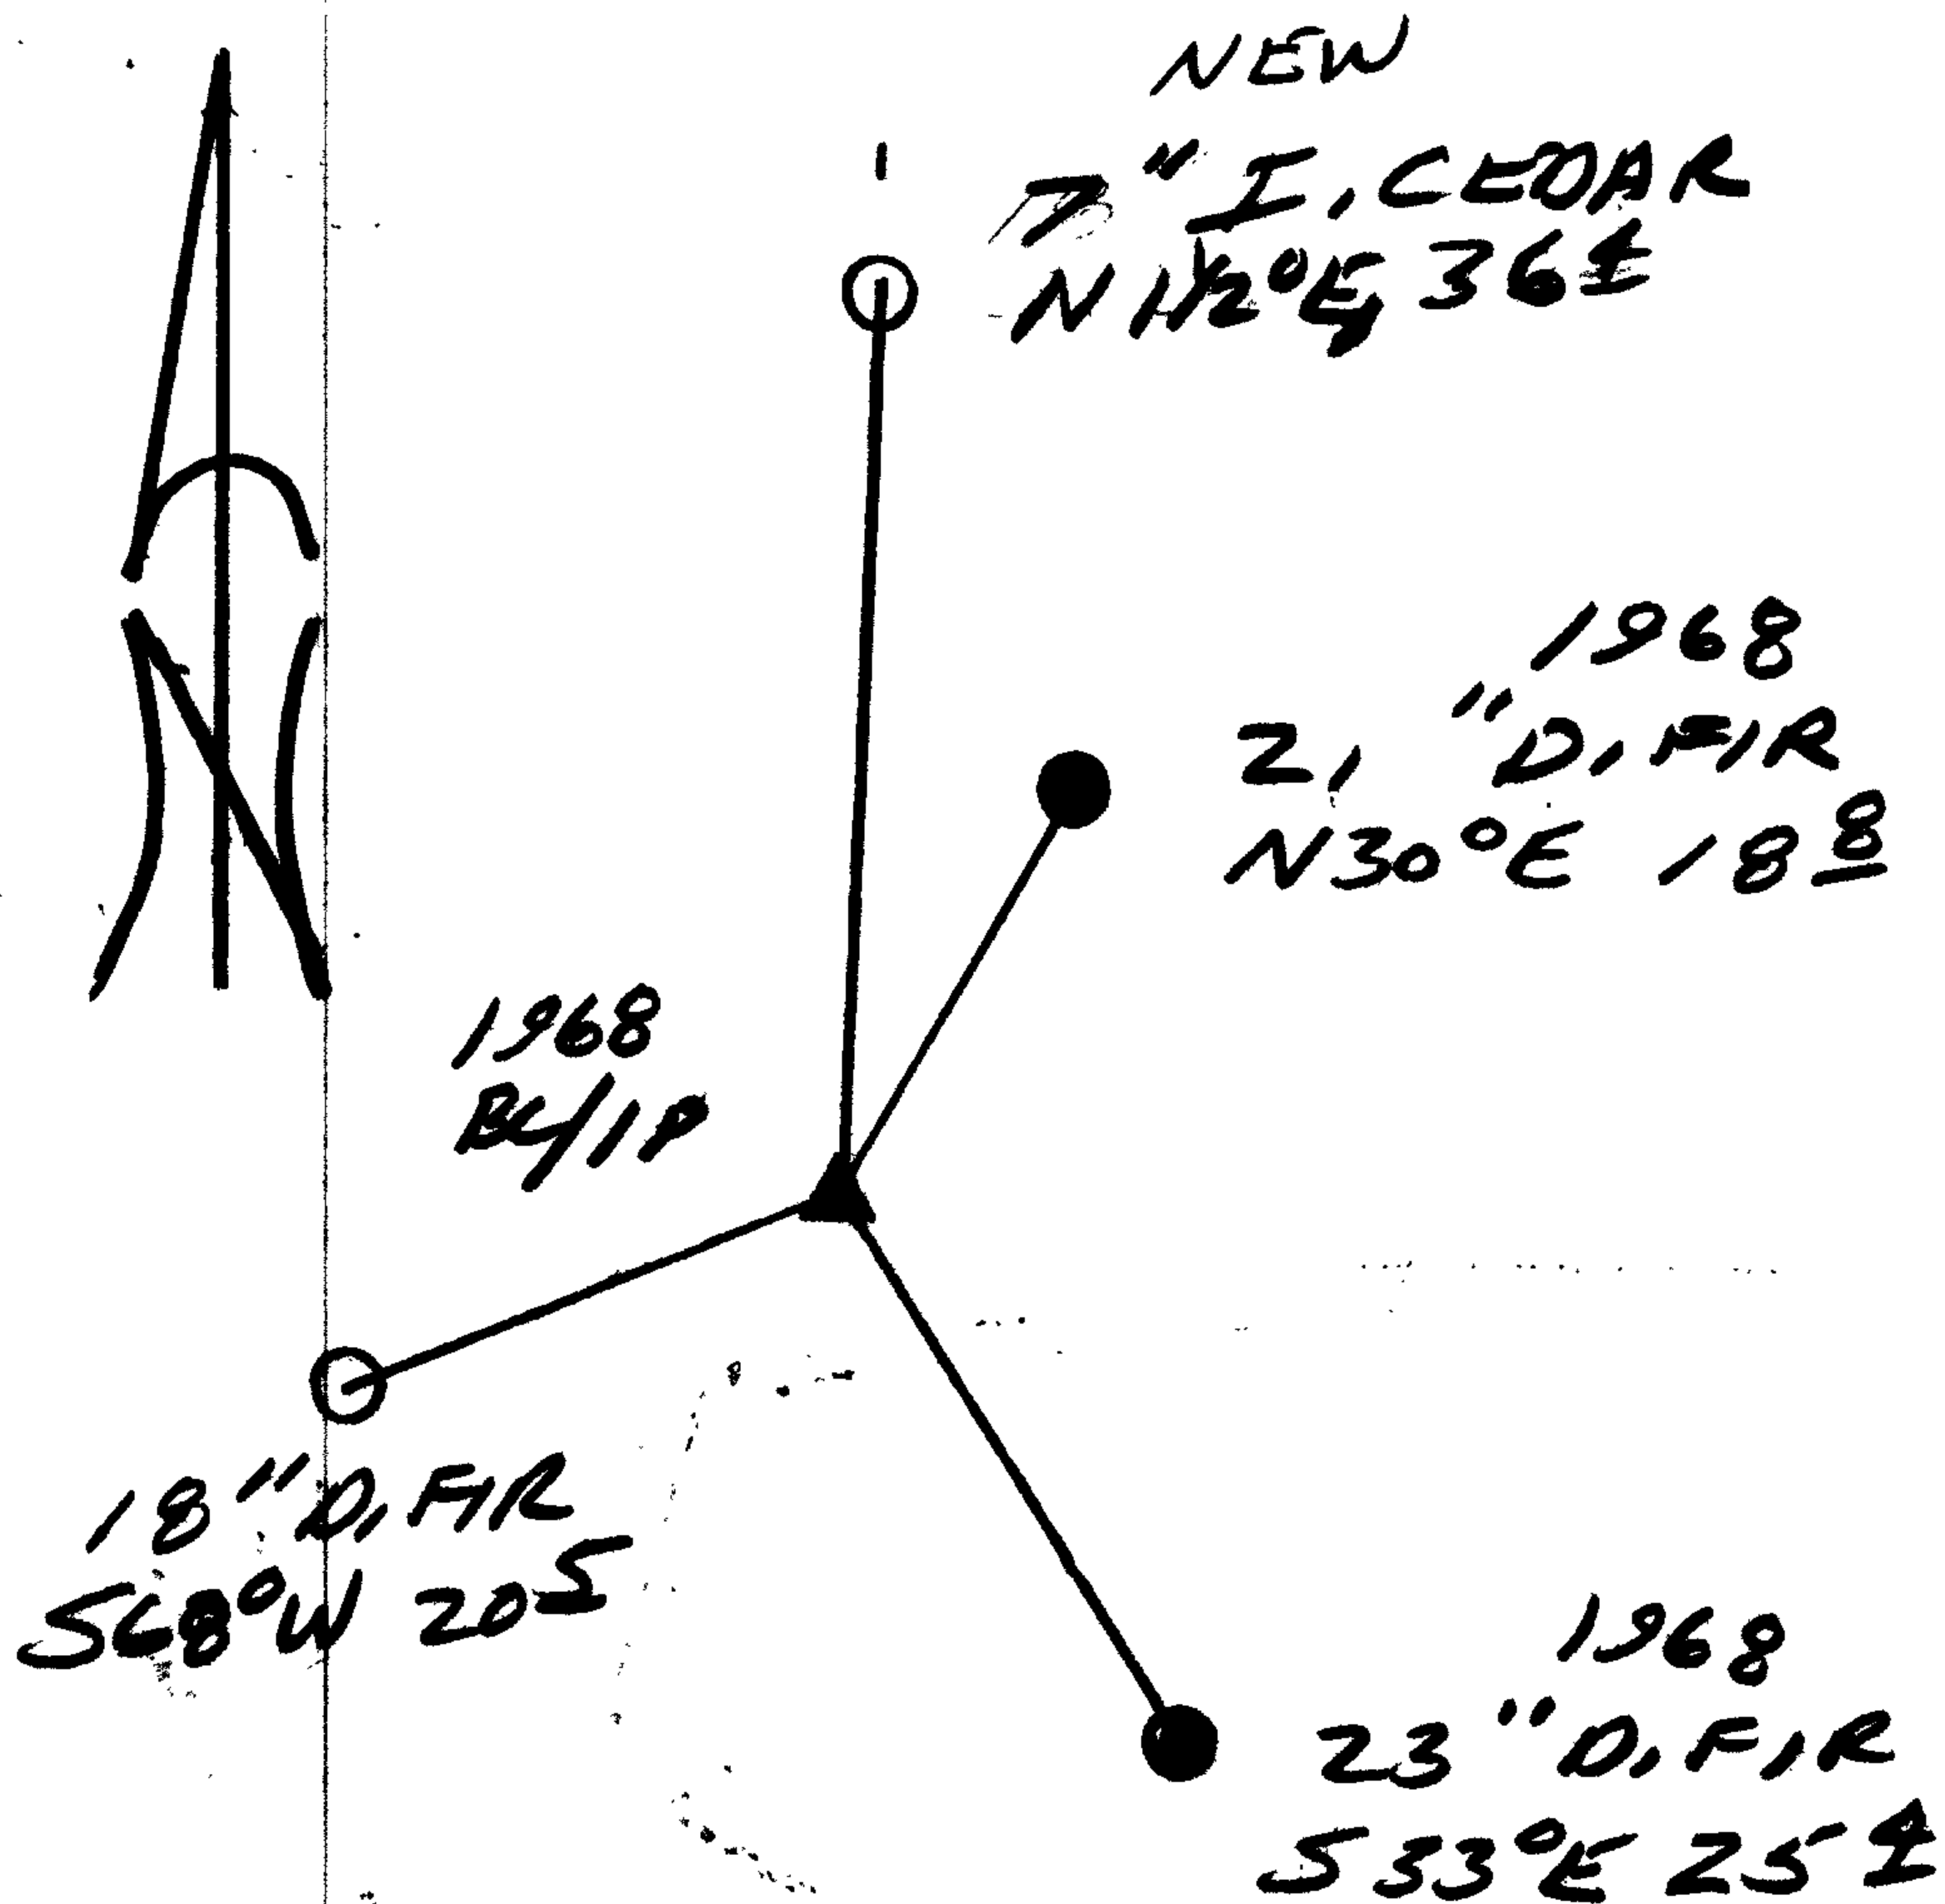

Comp. Declin. 1734'15"  
 Agency M50  
 Party Chief RANDALL W. SMITH  
 Notekeeper [Signature]  
 Witnesses STEPHEN J. FLASK

Address

Surveyor's Seal

REGISTERED  
 PROFESSIONAL  
 LAND SURVEYOR

[Signature]

OREGON  
 JULY 25, 1990  
 RANDALL W. SMITH