

GOVERNMENT CORNER RESTORATION FORM

Date: 3-17-1998 By: JC

This survey consists of:

Township 25S Range 7W Sec. 29 County DOUGLAS

Map: \_\_\_\_\_

State OR

Date 3-16-98

No. \_\_\_\_\_

Narrative: \_\_\_\_\_

Corner Rpt: 66/2-6

Corner Designation

1/4 S29  
4 S32

DOUGLAS COUNTY SURVEYOR

- Condition Report Only
- Not Found
- Renewed
- Unrecorded
- Surveyed In
- Referenced Out

MONUMENT DETAIL

Previous Renewals 1921 + 1971 DCSO

Monument(s) Found: (Condition and Source)

4" NOW 16" DIA D. FIR WITH FULLY HEALED BLAZES ON FOUR SIDES. (ORIG CORNER TREE)

2 1/2" DIA. BRASS CAP ON A 1 1/2" O.D. IRON PIPE PROTRUDES 15" ABOVE GROUND BEARS S 30° W, 1.5 FT FROM CORNER TREE.

COUNTY SURVEYORS OFFICE  
T25S  
1/4 S29  
S32  
R7W  
1971

Accessories Found:

BRG'S TAKEN FROM CORNER TREE

8" NOW ROTTEN MADRONE AT RECORD BEARING " NORTH, 11.9 FT " (EVIDENCE OF OLD BLAZE) ORT

8" NOW ROOT HOLE WITH SPROUTS OF YOUNG MADRONE'S GROWING AT RECORD BEARING " S 12° E, 16.5 FT " ORT

29" NOW 36" DIA D. FIR WITH A FULLY HEALED SINGLE BLAZE BEARS N 86° E 18.0 FT (REL N 86° E, 17.0 FT DISTANCE GOES TO BLAZE!) 1921

10" NOW 26" DIA D. FIR WITH A FULLY HEALED SINGLE BLAZE BEARS S 7° E 34.3 FT (REL S 7° E, 35.2 FT FITS WELL AS A SLOPE DISTANCE). 1921

RENEWAL

Monument Detail

Monument Set (Procedure and Description)

NONE

50 BRASS CAP IS SURROUNDED BY A MOUND OF STONE.


N/A

New Accessories  
BRG'S TAKEN FROM CORNER TREE

5" DIA. B. OAK DOUBLE BLAZED AND SCRIBED "Y4S32CS BT"  
BEARS S59°W, 22.5 FT (NOTE TREE IS PISTOL BUTT BEARING  
GOES TO CENTER OF ROOT CROWN).

4" DIA. MADRONE BARK SCRIBED "Y4S29CS BT"  
BEARS N 33 1/2° E, 25.6 FT

Sketch of Monument, Accessories, and General Area

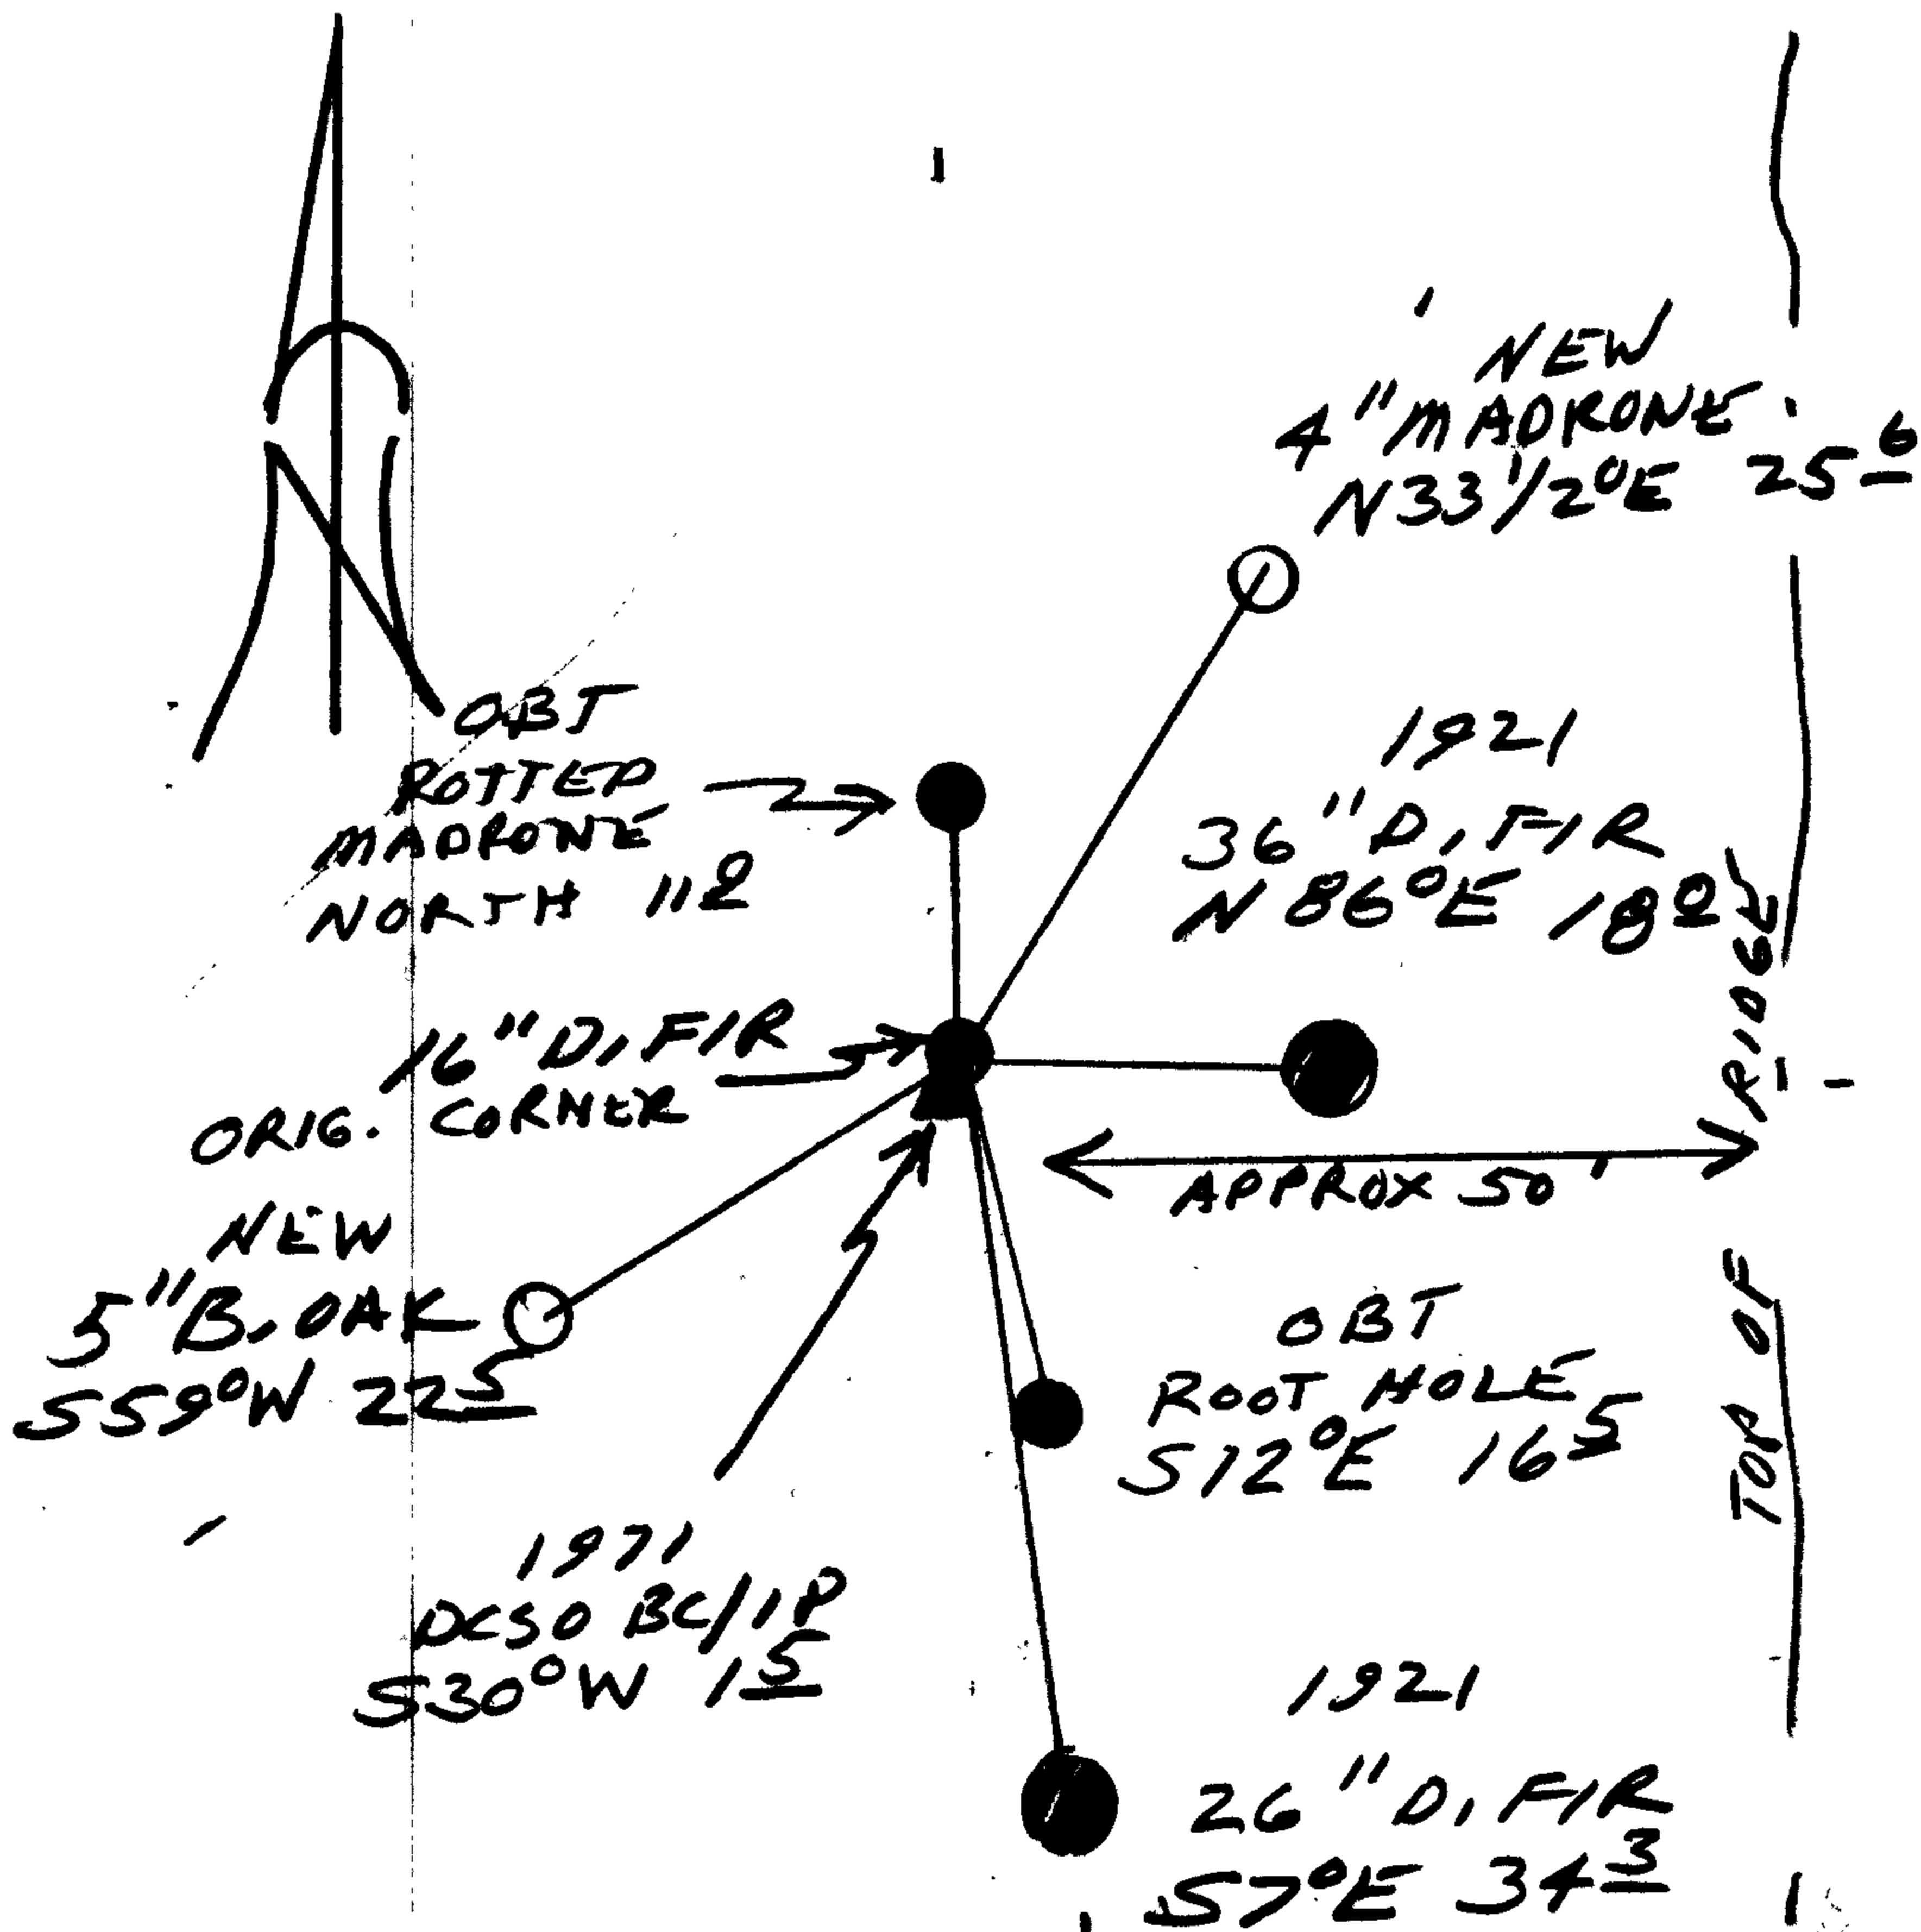

Location & Comments

Comp. Declin. 17 3/4° E  
 Agency DLSO  
 Party Chief RANDALL W. SMITH  
 Notekeeper FRANK H. A.  
 Witnesses STEPHEN J. FLAUS

Address

Surveyor's Seal

REGISTERED PROFESSIONAL LAND SURVEYOR

*Randall W. Smith*  
DAYS 6-30-98

OREGON  
JULY 25, 1900  
RANDALL W. SMITH  
2409