

RENEWAL

Monument Set (Procedure and Description)

Monument Detail


NONE

N/A

New Accessories

16" D/A. HEMLOCK DOUBLE BLAZED AND SCRIBED "Y459CS 13T"
BEARS N10°E, 11.9 FT

Sketch of Monument, Accessories, and General Area

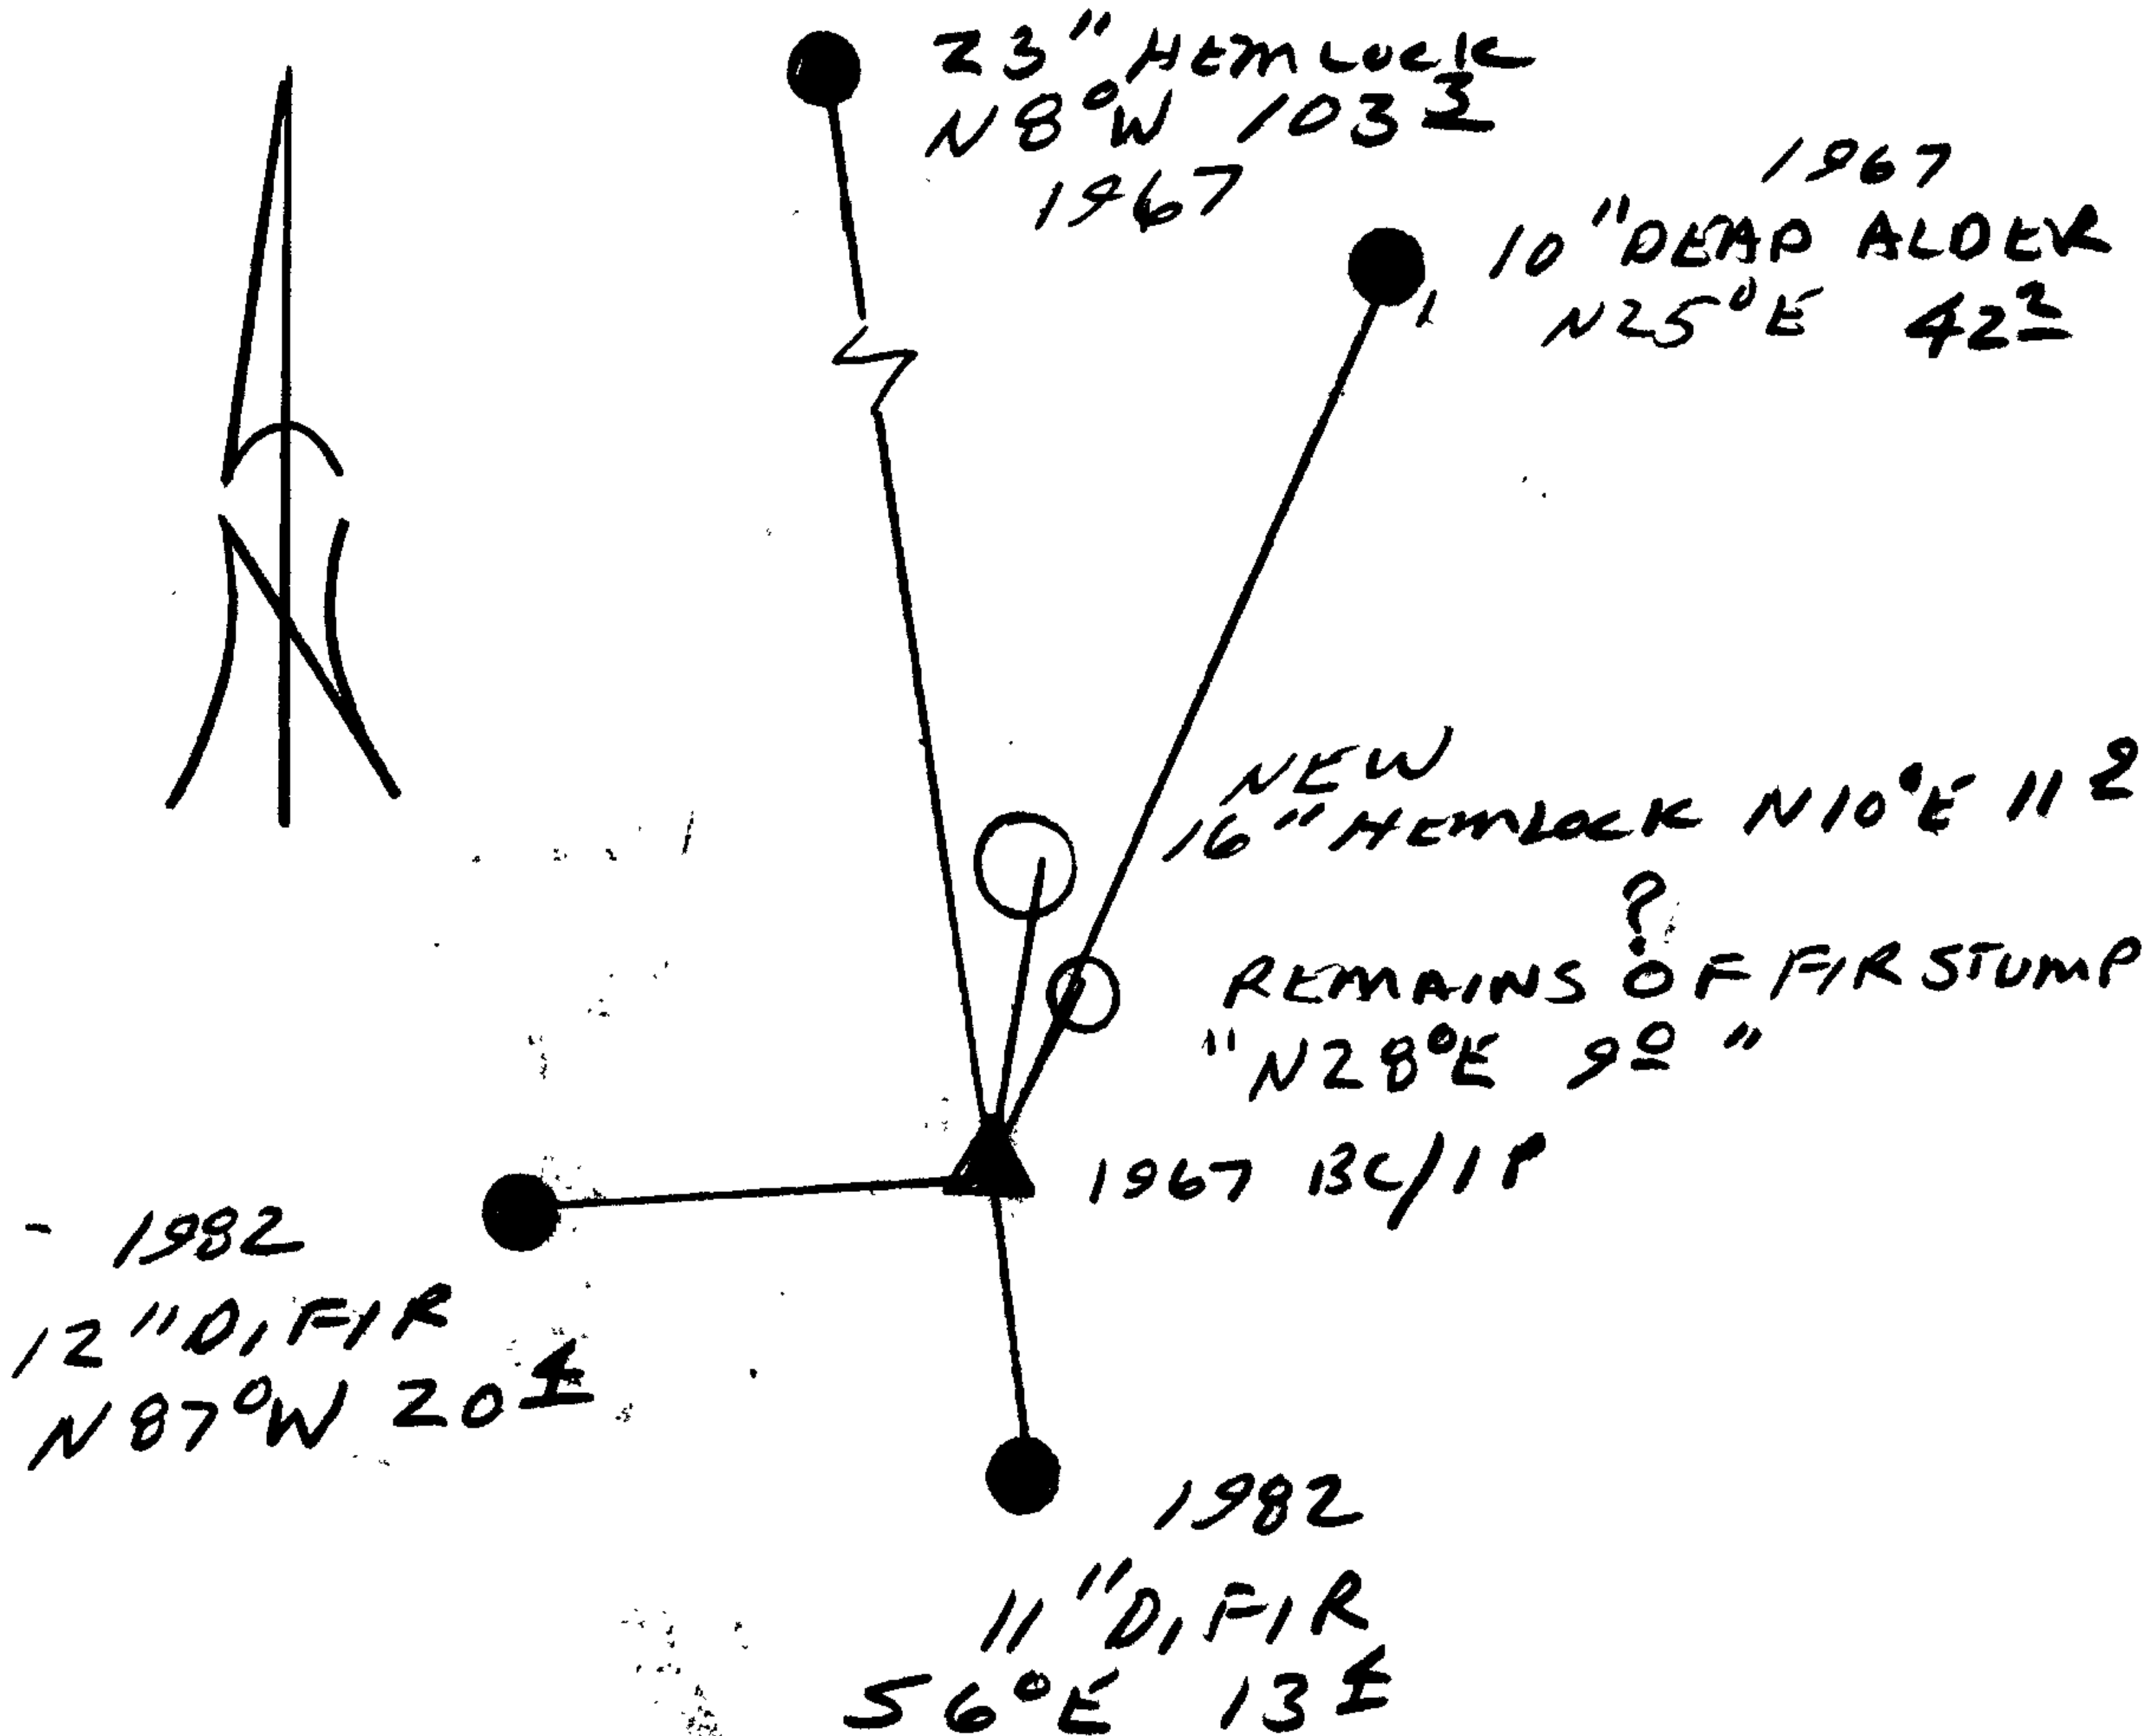

Location & Comments

CORNER LIES ON A FLAT
PORTION OF A EAST-WEST
RIDGE, APPROX 30 FT
NORTH OF SOUTH EDGE

Comp. Declin. 17 3/4° E
Agency DCSO
Party Chief RANDALL W. SMITH
Notekeeper [Signature]
Witnesses STEPHEN J. FLAKE

Address

Surveyor's Seal

REGISTERED
PROFESSIONAL
LAND SURVEYOR

[Signature]
EXPIRES 6-30-98

OREGON
JULY 25, 1990
RANDALL W. SMITH
2489