

GOVERNMENT CORNER RESTORATION FORM

Date: 5-12-1998 By: JC

Township 21S Range 11W Sec. 5 County DOUGLAS

This survey consists of: _____

State OR Date 4-21-98 No. _____

Narrative: _____

Corner Rpt: 66/2-14

Corner Designation

E/16 55
58

DOUGLAS COUNTY

Condition SURVEYOR Only

Not Found

Renewed

Unrecorded

Surveyed In

Referenced Out

MONUMENT DETAIL

Previous Renewals 1976 + 1967 UCSO

Monument(s) Found: (Condition and Source)

2 1/2" DIA BRASS CAP ON A
1 1/2" O.D. IRON PIPE, PROTRUDES
10" ABOVE GROUND. (1967)

COUNTY SURVEYORS OFFICE

T 21 S

E 55
/16 58

R 11 W

1967

Accessories Found:

6" NOW 5" DIA DOWN AND ROTTED FIR BEAMS
S 8° E, 6.8 FT (AGREES WITH REC.) 1967

14" NOW 15" DIA. FIR WITH A FULL HEALED SINGLE
BLAZE BEAMS N 50° E, 14.1 FT (AGREES WITH REC.)
1967

11" NOW 12" DIA. FIR SNAG WITH A FULL HEALED
DOUBLE BLAZE BEAMS S 31 1/2° E, 25.0 FT
(AGREES WITH REC.) 1976

RENEWAL

Monument Set (Procedure and Description)

Monument Detail

NONE


N/A

New Accessories

11" DIA. HEMLOCK DOUBLE BLAZED AND SCRIBED "EY1659CS BT"
BEARS S62 1/2° W, 9.5 FT

7" DIA. HEMLOCK DOUBLE BLAZED AND SCRIBED "EY1655CS BT"
BEARS N63° W 12.0 FT.

Sketch of Monument, Accessories, and General Area

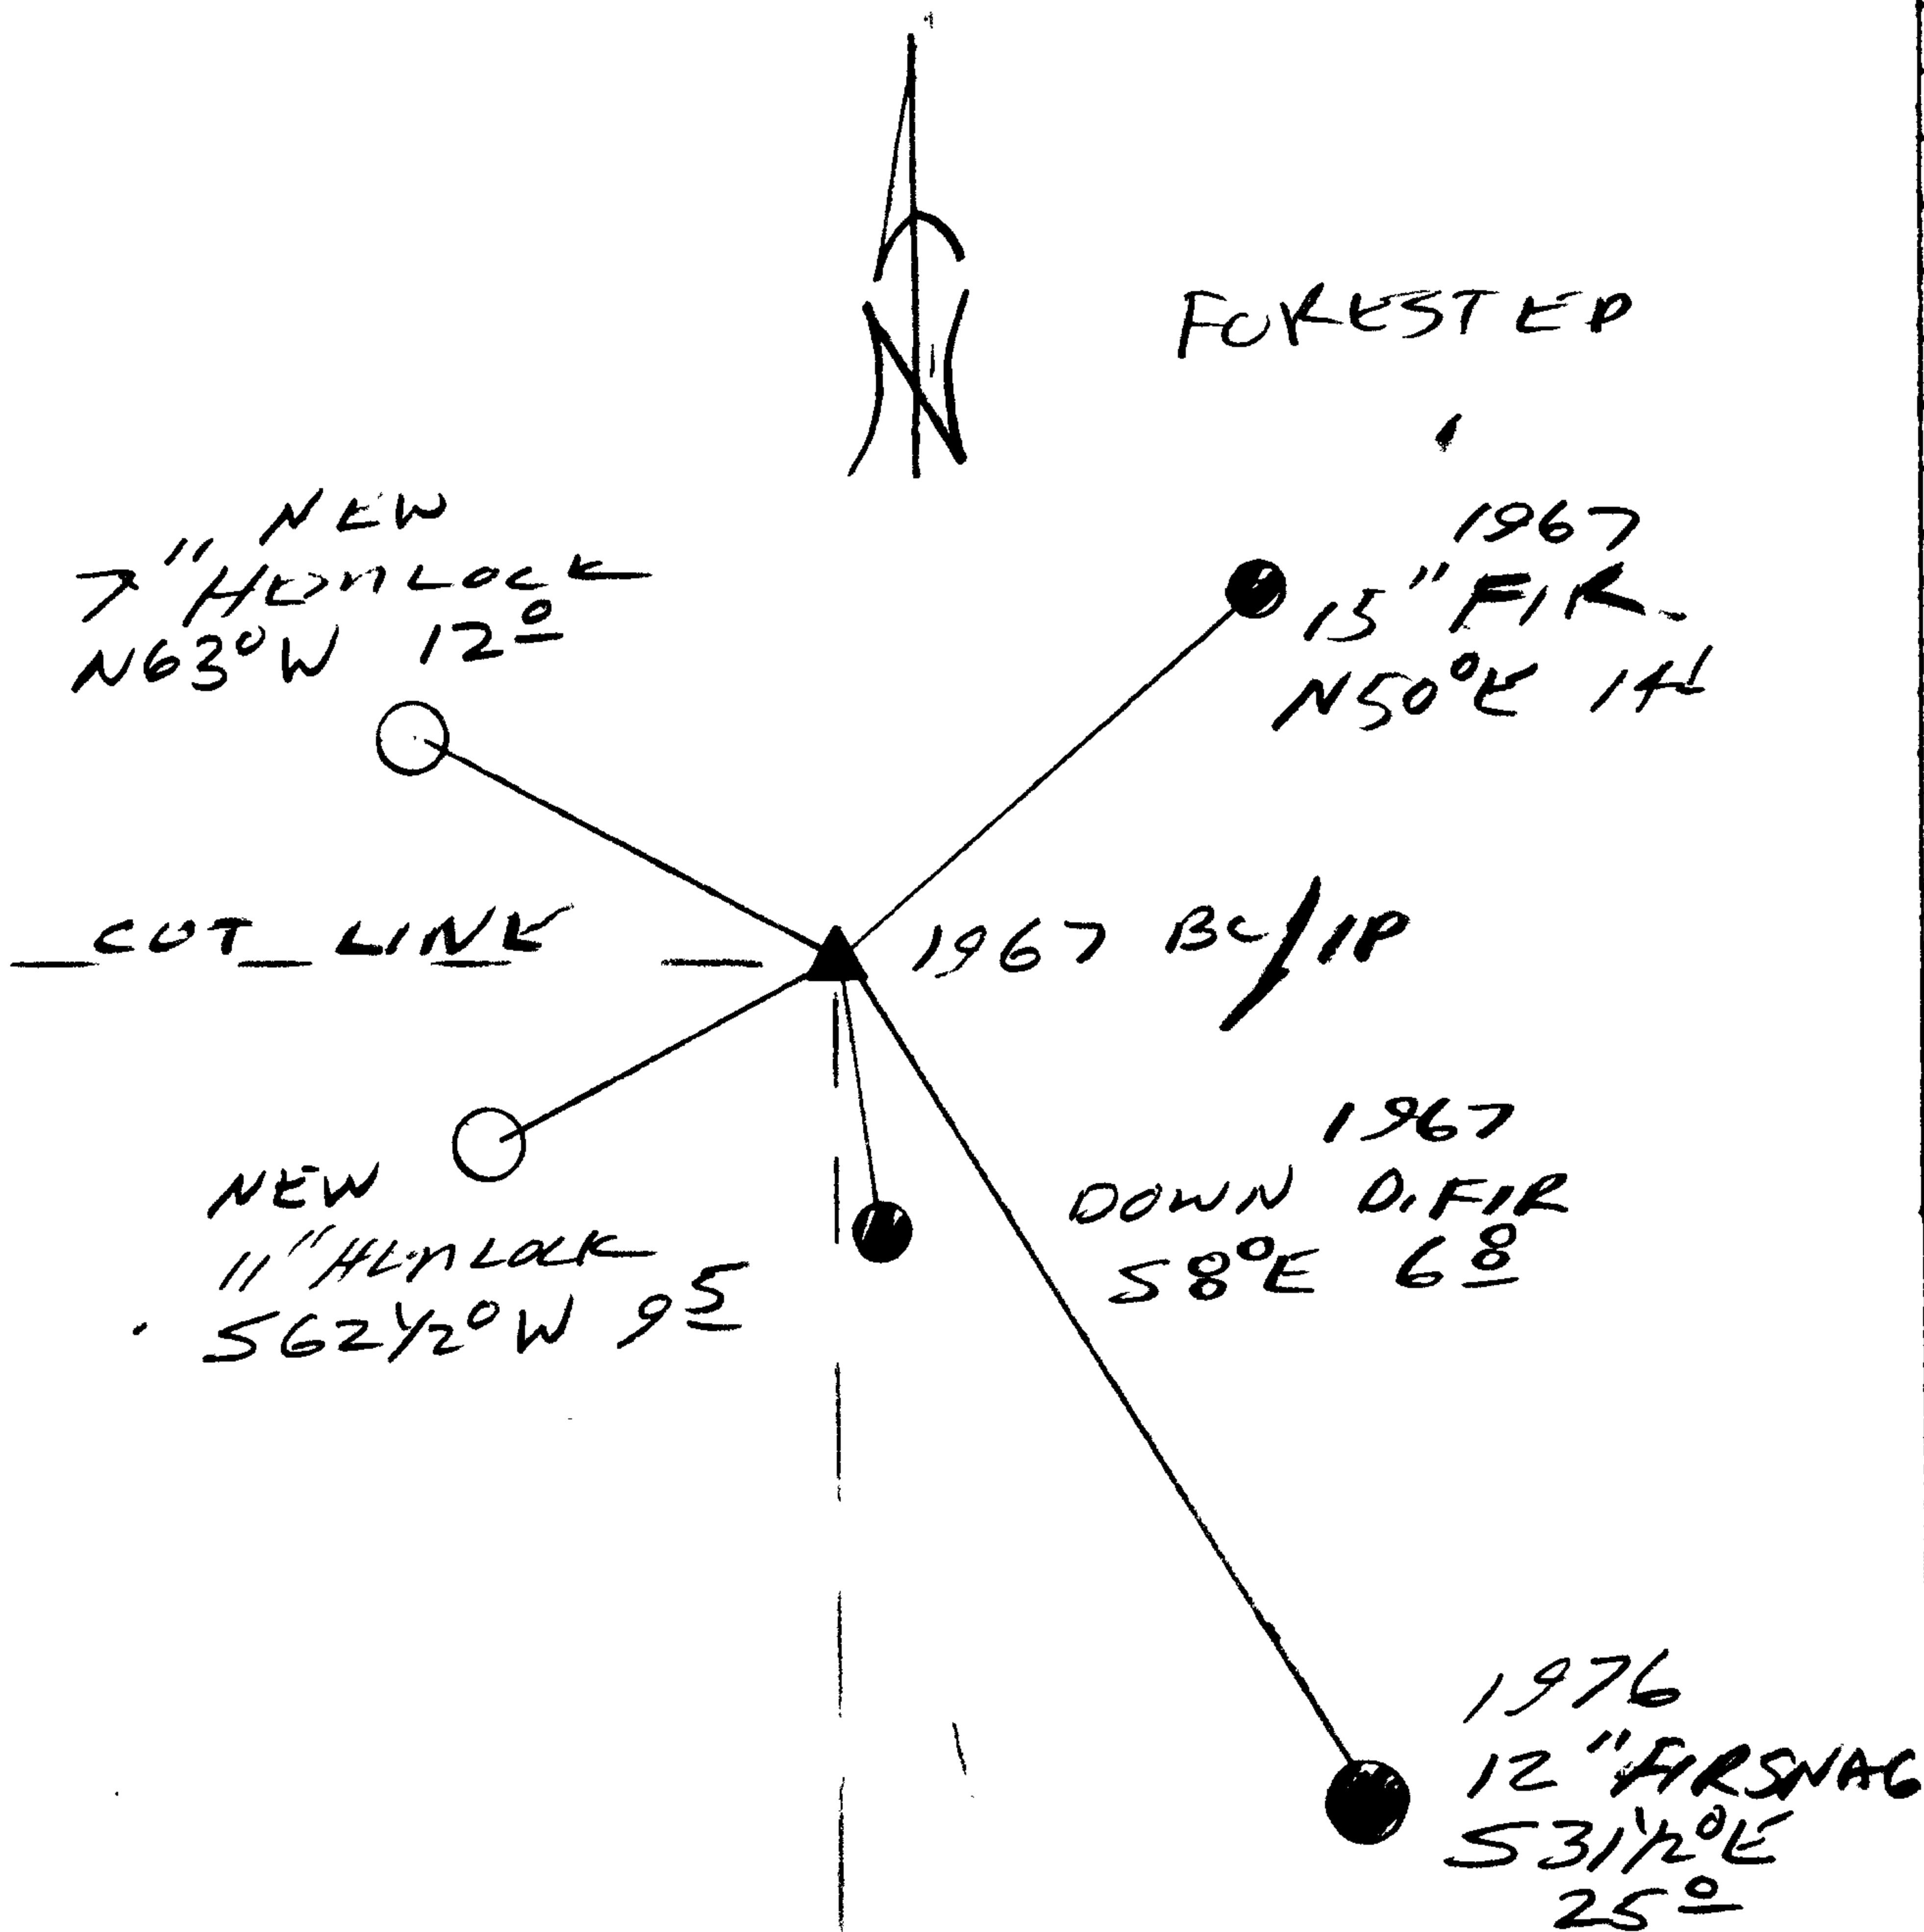

Location & Comments

Comp. Declin. 17 3/4° E
 Agency ORSO
 Party Chief RANDALL W. SMITH
 Notekeeper CHUCK L. BENT
 Witnesses _____

Address

Surveyor's Seal

REGISTERED
 PROFESSIONAL
 LAND SURVEYOR

Randall W. Smith
 EY1655 E-30-98

OREGON
 JULY 25, 1990
 RANDALL W. SMITH
 2489