

RENEWAL

Monument Set (Procedure and Description)

2 3/8" DIA BRASS CAP ON A 1 3/8" OD BY 32" LONG IRON PIPE IS SET AT SURVEYED CORNER POSITION, PROTRUDES 8" ABOVE GROUND.

Monument Detail


DOUGLAS CO. SURVEYOR'S OFFICE
T 21 S
NE 1/16 S 8
R 11 W
1998

New Accessories

13" MAPLE DOUBLE BLAZED AND SCRIBED "NE 1/16 S 8 CS BT"
BEARS S 76 1/2° E, 7.4 FT

10" D. FIR DOUBLE BLAZED AND SCRIBED "NE 1/16 S 8 CS BT"
BEARS S 53 1/4° W, 9.2 FT (NOTE BT AS PISTOL BUTT BRG DIST. IS TO CENTER OF TRUNK)

Sketch of Monument, Accessories, and General Area

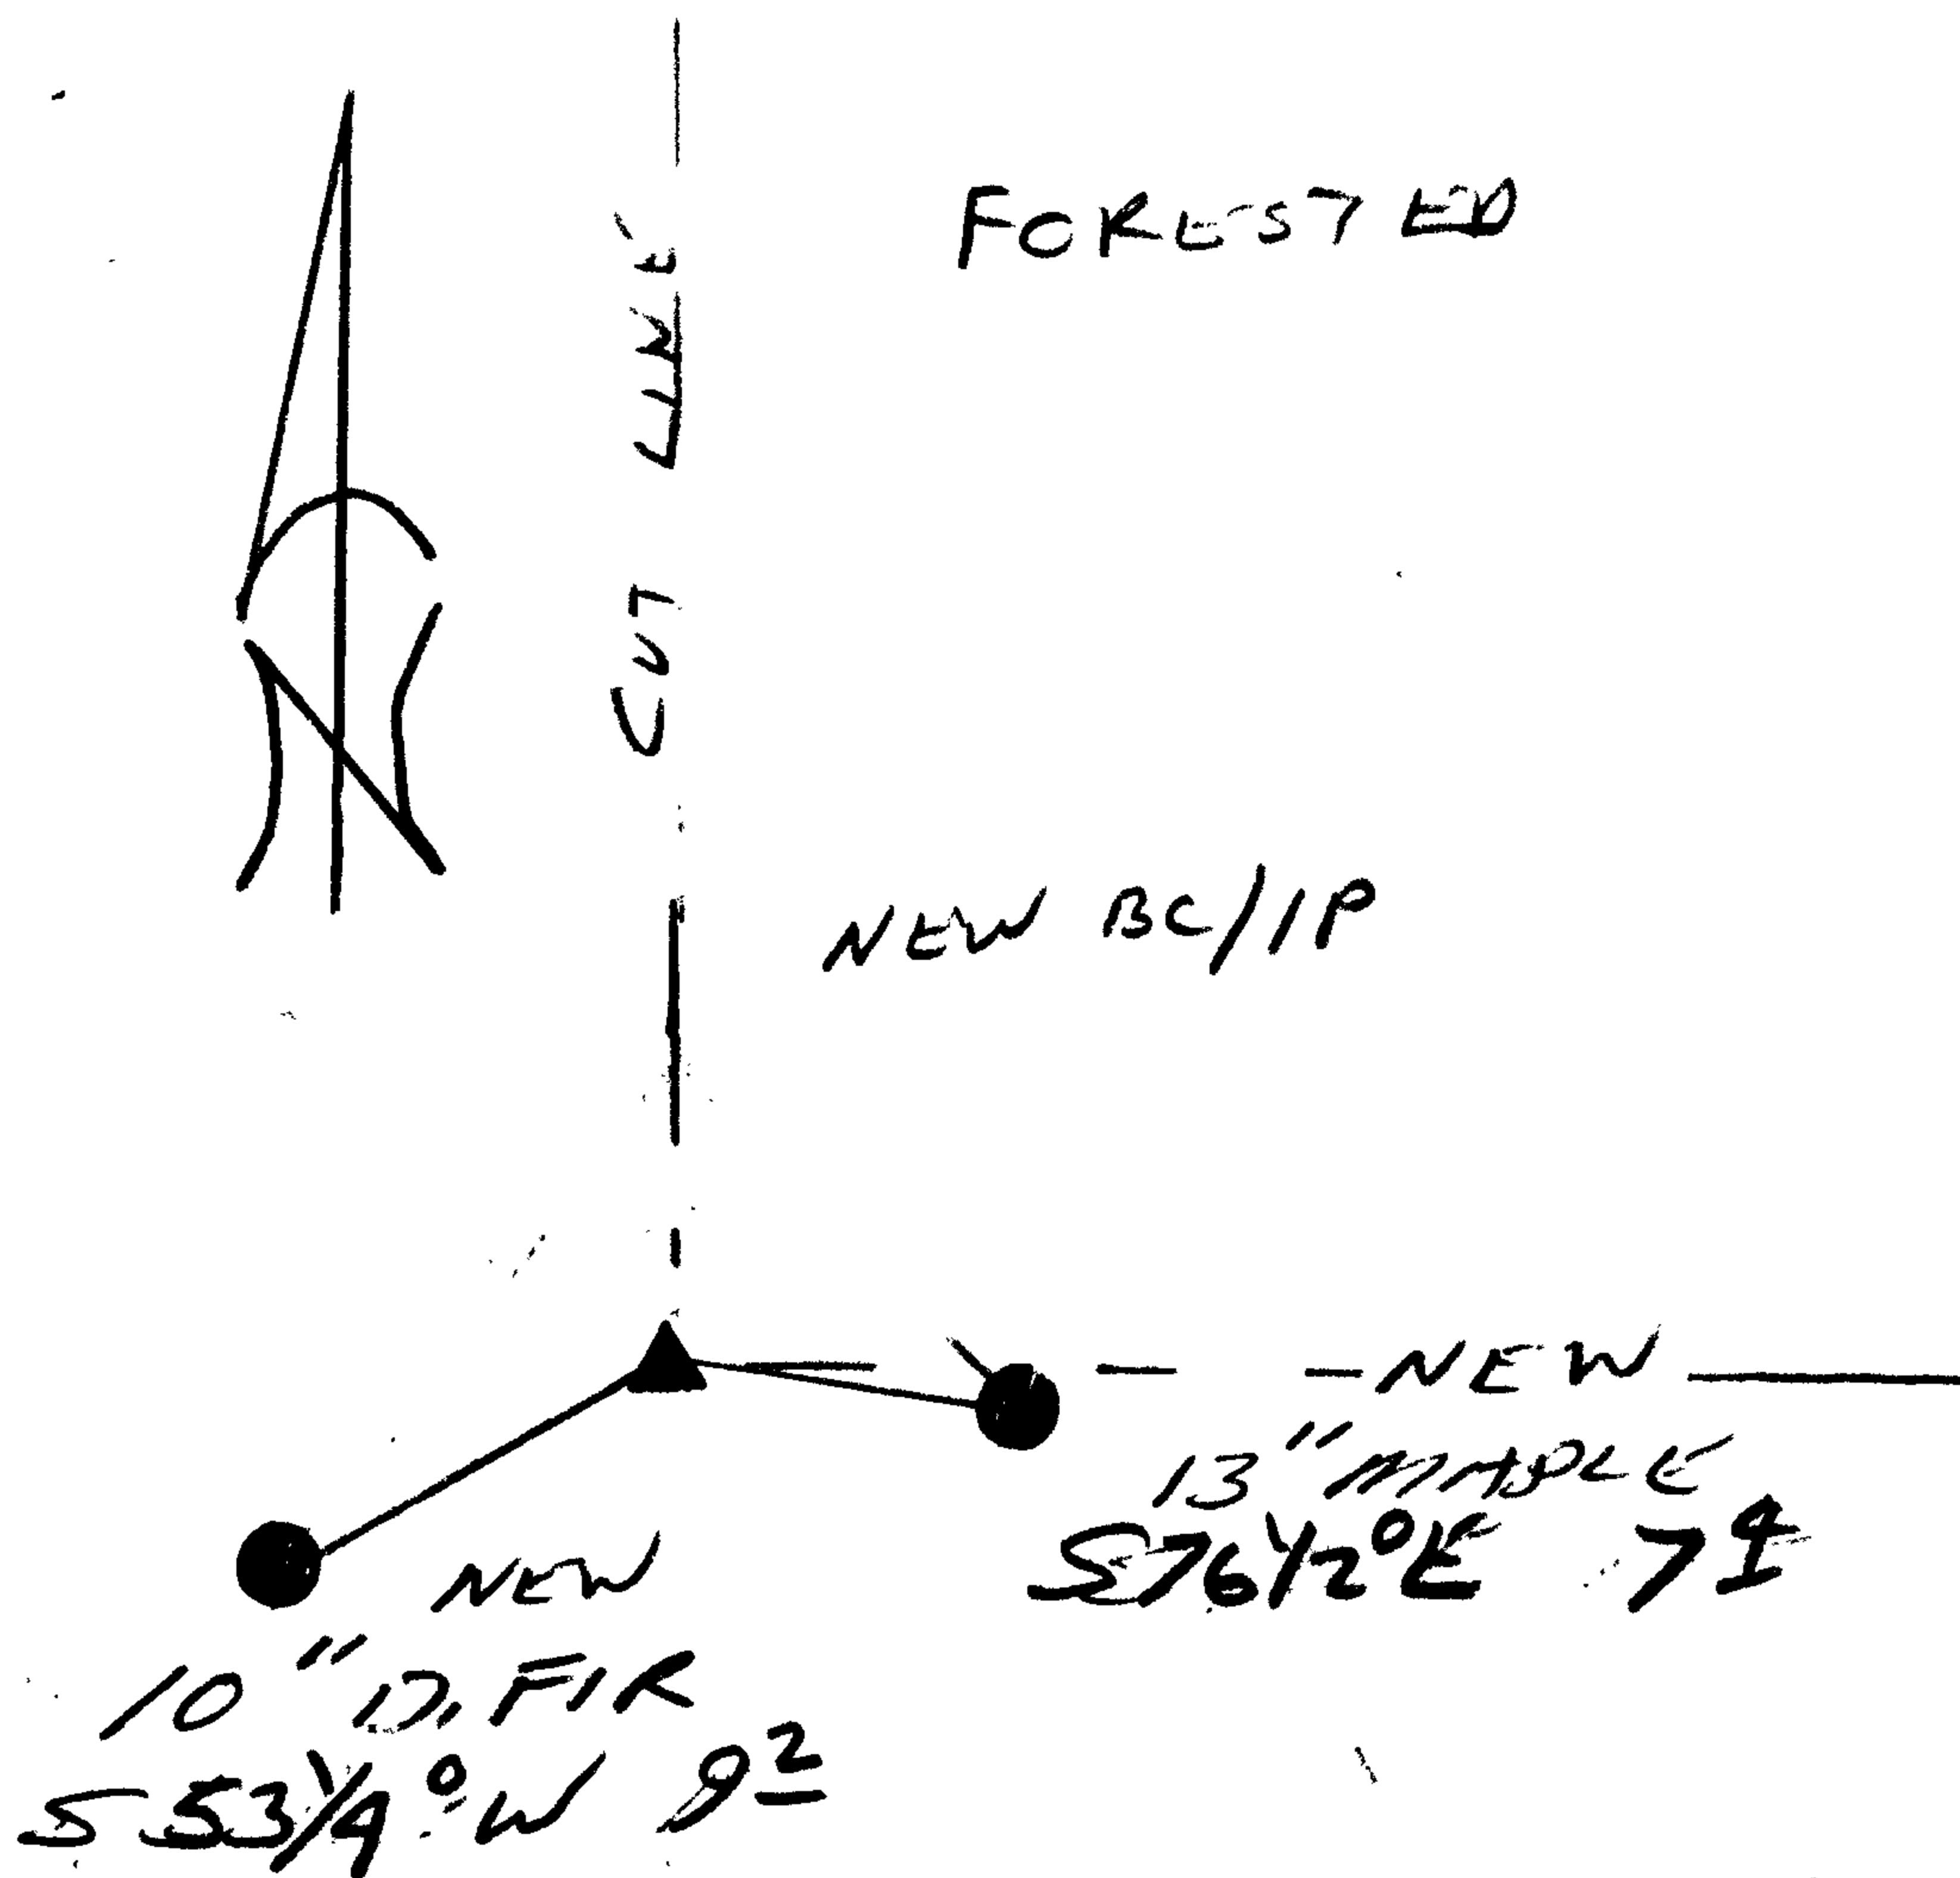

Location & Comments

CORNER LIES ON A STEEP SOUTH SLOPE

Comp. Declin. 17 3/4° E
Agency DCSO
Party Chief LARRY E. MANKREAN
Notekeeper [Signature]
Witnesses STEPHEN J. FLAISE
JOHN A. PIKE

Address

Surveyor's Seal

REGISTERED PROFESSIONAL LAND SURVEYOR

[Signature]
EXPIRES 6-30-98

OREGON
JULY 25, 1980
RANDALL W. SMITH
2489