

GOVERNMENT CORNER RESTORATION FORM

Date: 5-12-1998 By: JC

Township 27S Range R7W Sec. 36

County DOUGLAS

This survey consists of:

State OR

Date 5-5-98

No. _____

Map: _____

Narrative: _____

Corner Designation

Corner Rpt: 666 | 2-20

SOUTH 1/4 S36 ONLY

DOUGLAS COUNTY

Condition: Only

Not Found

Renewed

Unrecorded

Surveyed In

Referenced Out

MONUMENT DETAIL

Previous Renewals 1924 GLO + 1961 DCSO

Monument(s) Found: (Condition and Source)

2 1/2" DIA. BRASS CAP ON A 1" O.D. IRON PIPE PROTRUDES 5" ABOVE GROUND (1924 GLO)

U.S. GENERAL LAND

1/4 S36

1924

OFFICE SURVEY

Accessories Found:

- 15" NOW 19" DIA. ASH WITH A PARTIALLY HEALED DOUBLE BLAZE SCRIBING VISIBLE "36" BEARS S89°E, 21.3 FT (AGREES WITH REC.) 1961 DCSO
 - 18" NOW MULT. TRUNKED ASH WITH A PARTIALLY HEALED DOUBLE BLAZE ON EASTERLY 16" TRUNK SCRIBING VISIBLE "33" BEARS S77°W, 10.7 FT (REC. N86°W, 10.7 FT) 1961 DCSO
 - 6" NOW CLUSTER OF NEWER ASHES AT RECORD BEARING "N53°E, 7.3 FT" 1924 GLO
- 1924 NW BT IS GONE

RENEWAL

Monument Set (Procedure and Description)

NONE

Monument Detail


N/A

New Accessories

SOUTH WEST TREE OF A CLUSTER OF ASHES DOUBLE BLAZED AND SCRIBED "YAS 36 CS BT" ON 7" DIA TRUNK BEARS N 60° E, 7.3 FT TO CENTER OF BASE OF SCRIBED TRUNK.

5/8" BY 30" LONG IRON WITH ALUM. DCSO CAP STAMPED "BOI" IS SET IN EAST-WEST FENCE LINE, PROTRUDES 10" ABOVE GROUND BEARS SOUTH 3.5 FT

Sketch of Monument, Accessories, and General Area

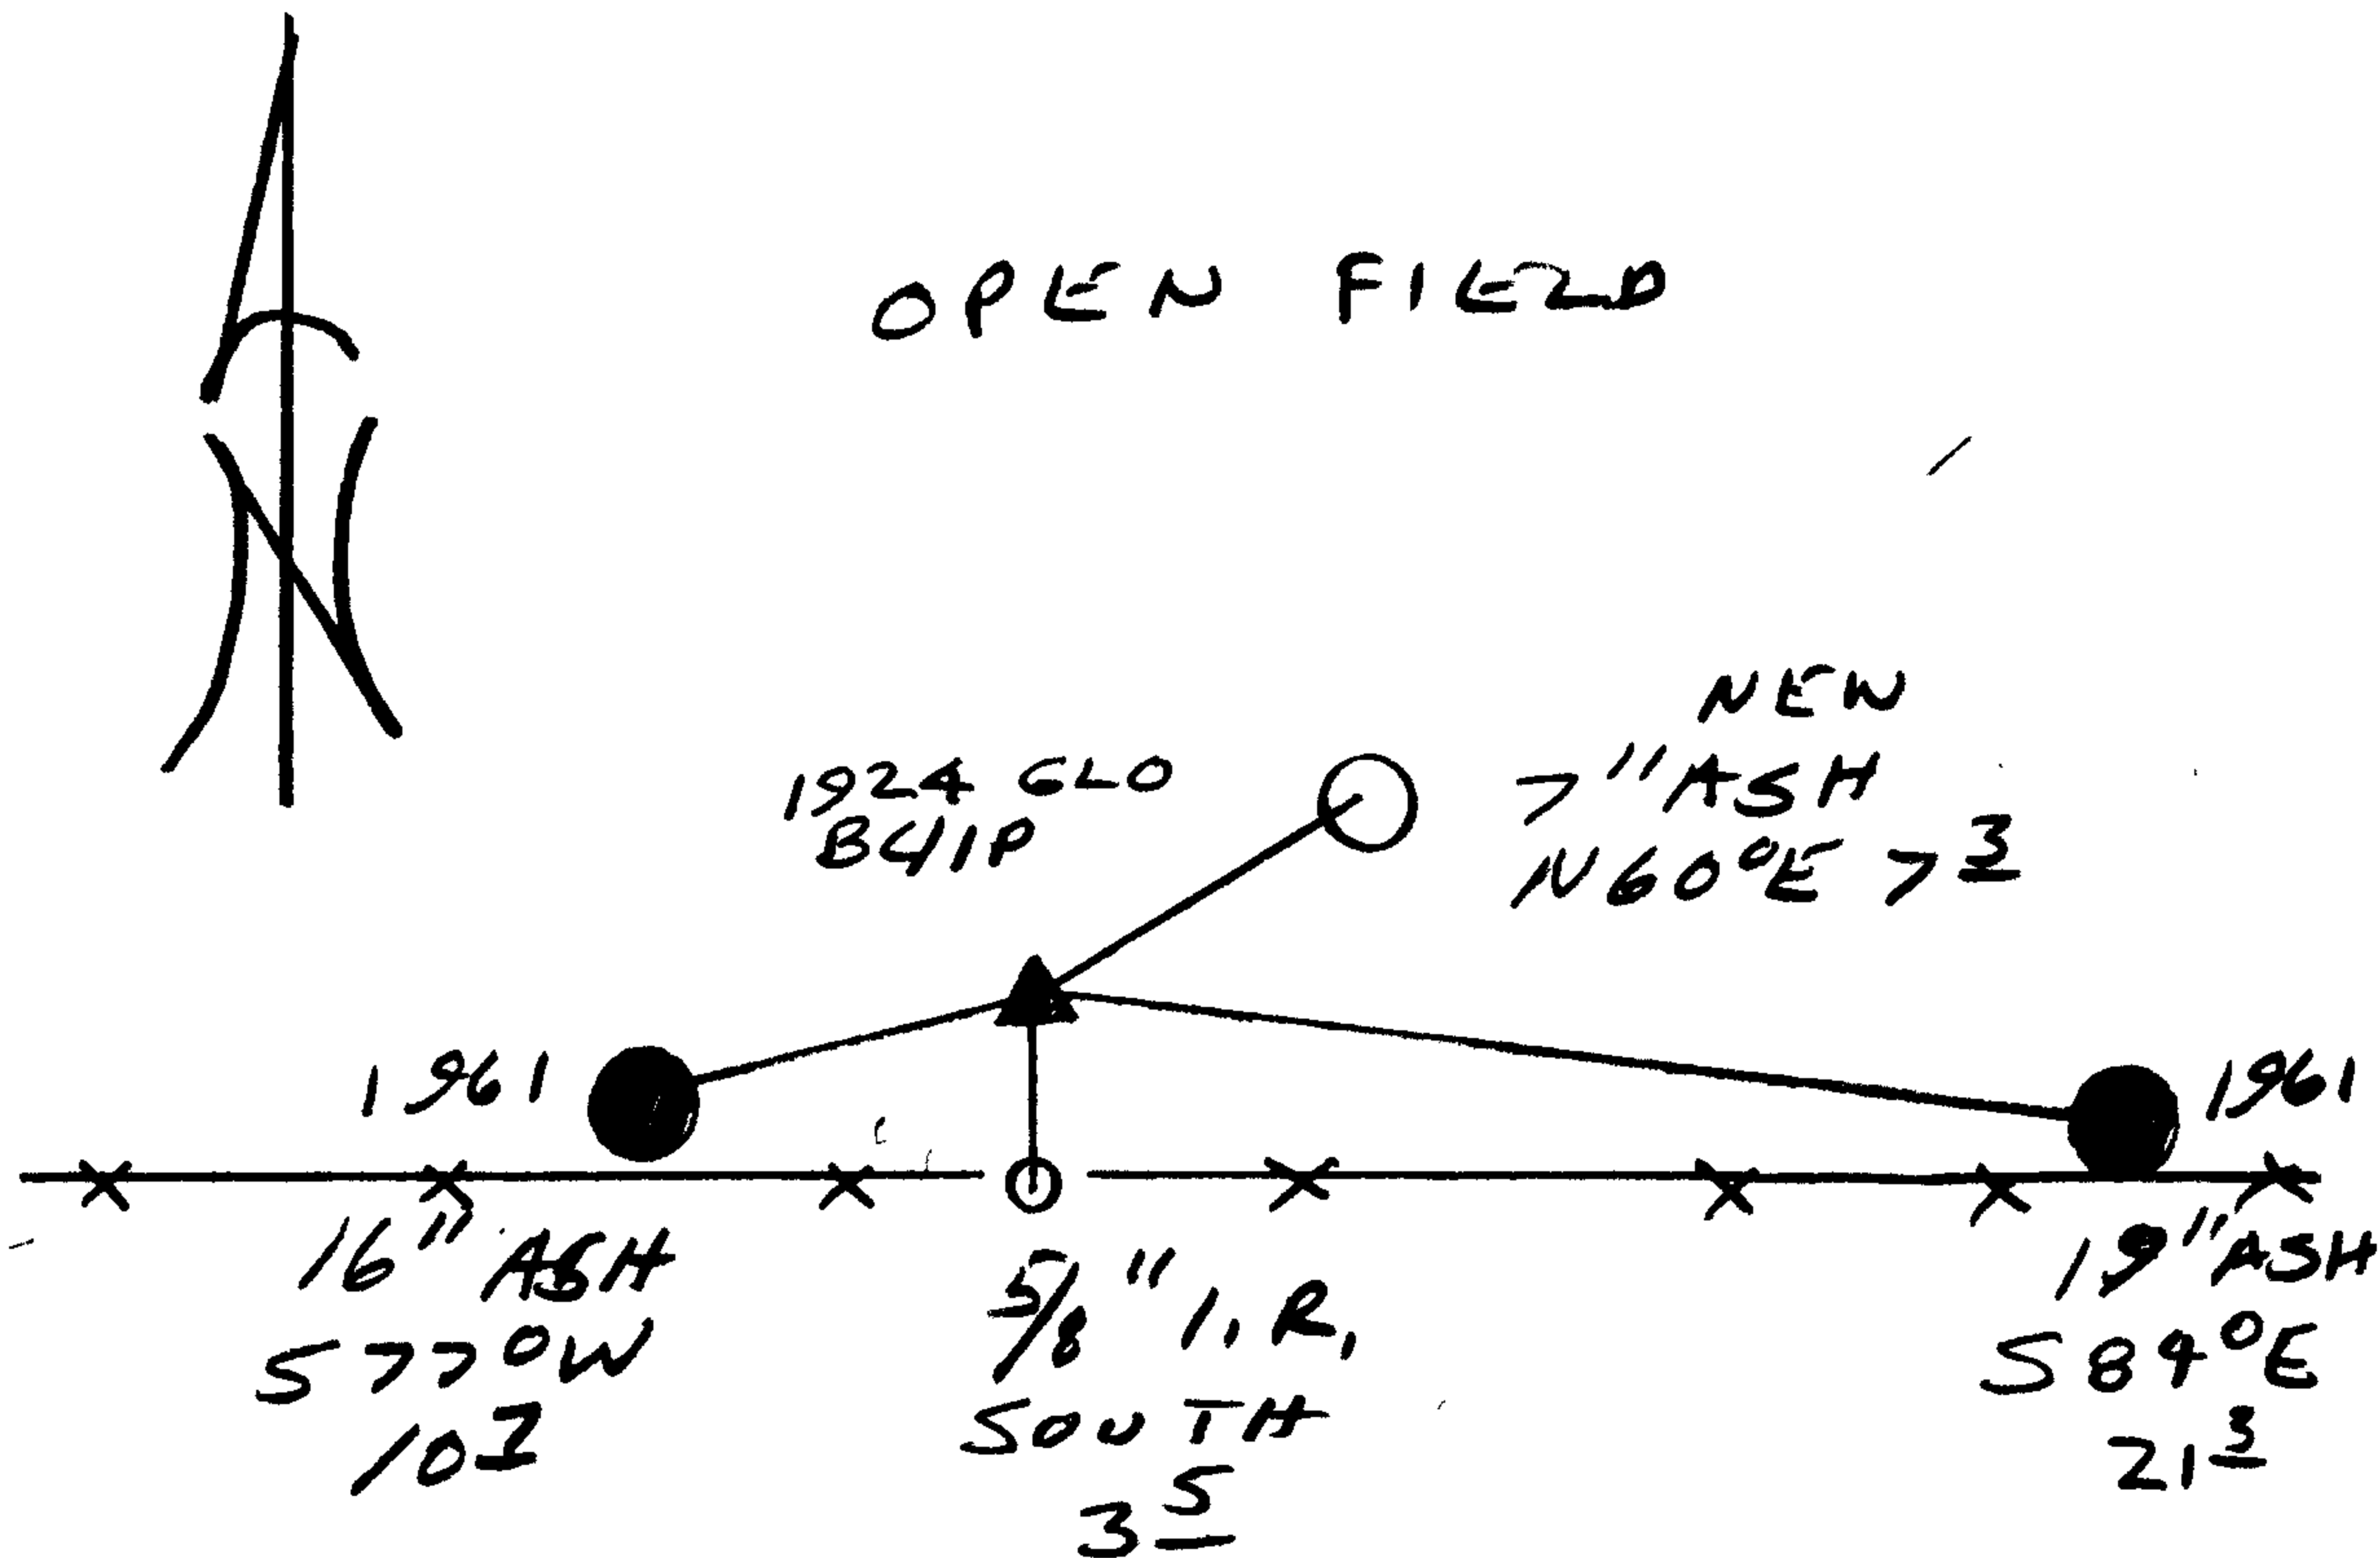

Location & Comments

Comp. Declin. 17 3/4° E
Agency DCSO
Party Chief RANDALL W. SMITH
Notekeeper [Signature]
Witnesses STEPHEN FLAISE

Address

Surveyor's Seal

REGISTERED PROFESSIONAL LAND SURVEYOR

[Signature]
EXPIRES 6-30-98

OREGON
JULY 25, 1990
RANDALL W. SMITH
2489