

FILED

GOVERNMENT CORNER RESTORATION FORM

Date: 5-12-99 By: SC

Township 28S Range 7W Sec. 1

County DOUGLAS

This survey consists of:

State OR

Date 5-5-99

No. _____

Narrative: _____

Corner Rpt: 166/2-21

Corner Designation

NORTH ONLY
1/4 S1

DOUGLAS COUNTY
SUPERVISOR

Condition: Only

Not Found

Renewed

Unrecorded

Surveyed In

Referenced Out

MONUMENT DETAIL

Previous Renewals 1924 GLO

Monument(s) Found: (Condition and Source)

2 1/2" DIA BRASS CAP ON A 1"
OD IRON PIPE PROTRUDS 10"
ABOVE GROUND (1924 GLO)

U.S. GENERAL LAND

1/4 S1

SC

1924

OFFICE SURVEY

Accessories Found:

10" NOW 12" DIA ASH WITH A PARTIALLY HEALED SINGLE
BLAZE, ILLEGIBLE SCRIBING VISIBLE, BEARS S64°W,
40.3 FT (AGREES WITH REC.) 1924 GLO

RENEWAL

Monument Set (Procedure and Description)

Monument Detail

NONE


N/A

New Accessories

10" DIA ASH DOUBLE BLAZED AND SCRIBED "Y9SICS BT"
BEARS S53°E, 2.0 FT.

6" DIA ASH SINGLE BLAZED LOW AND SCRIBED "XCS BT"
BEARS N6°W, 13.5 FT (NOTE TREE NOT IN SEC. 1)

Sketch of Monument, Accessories, and General Area

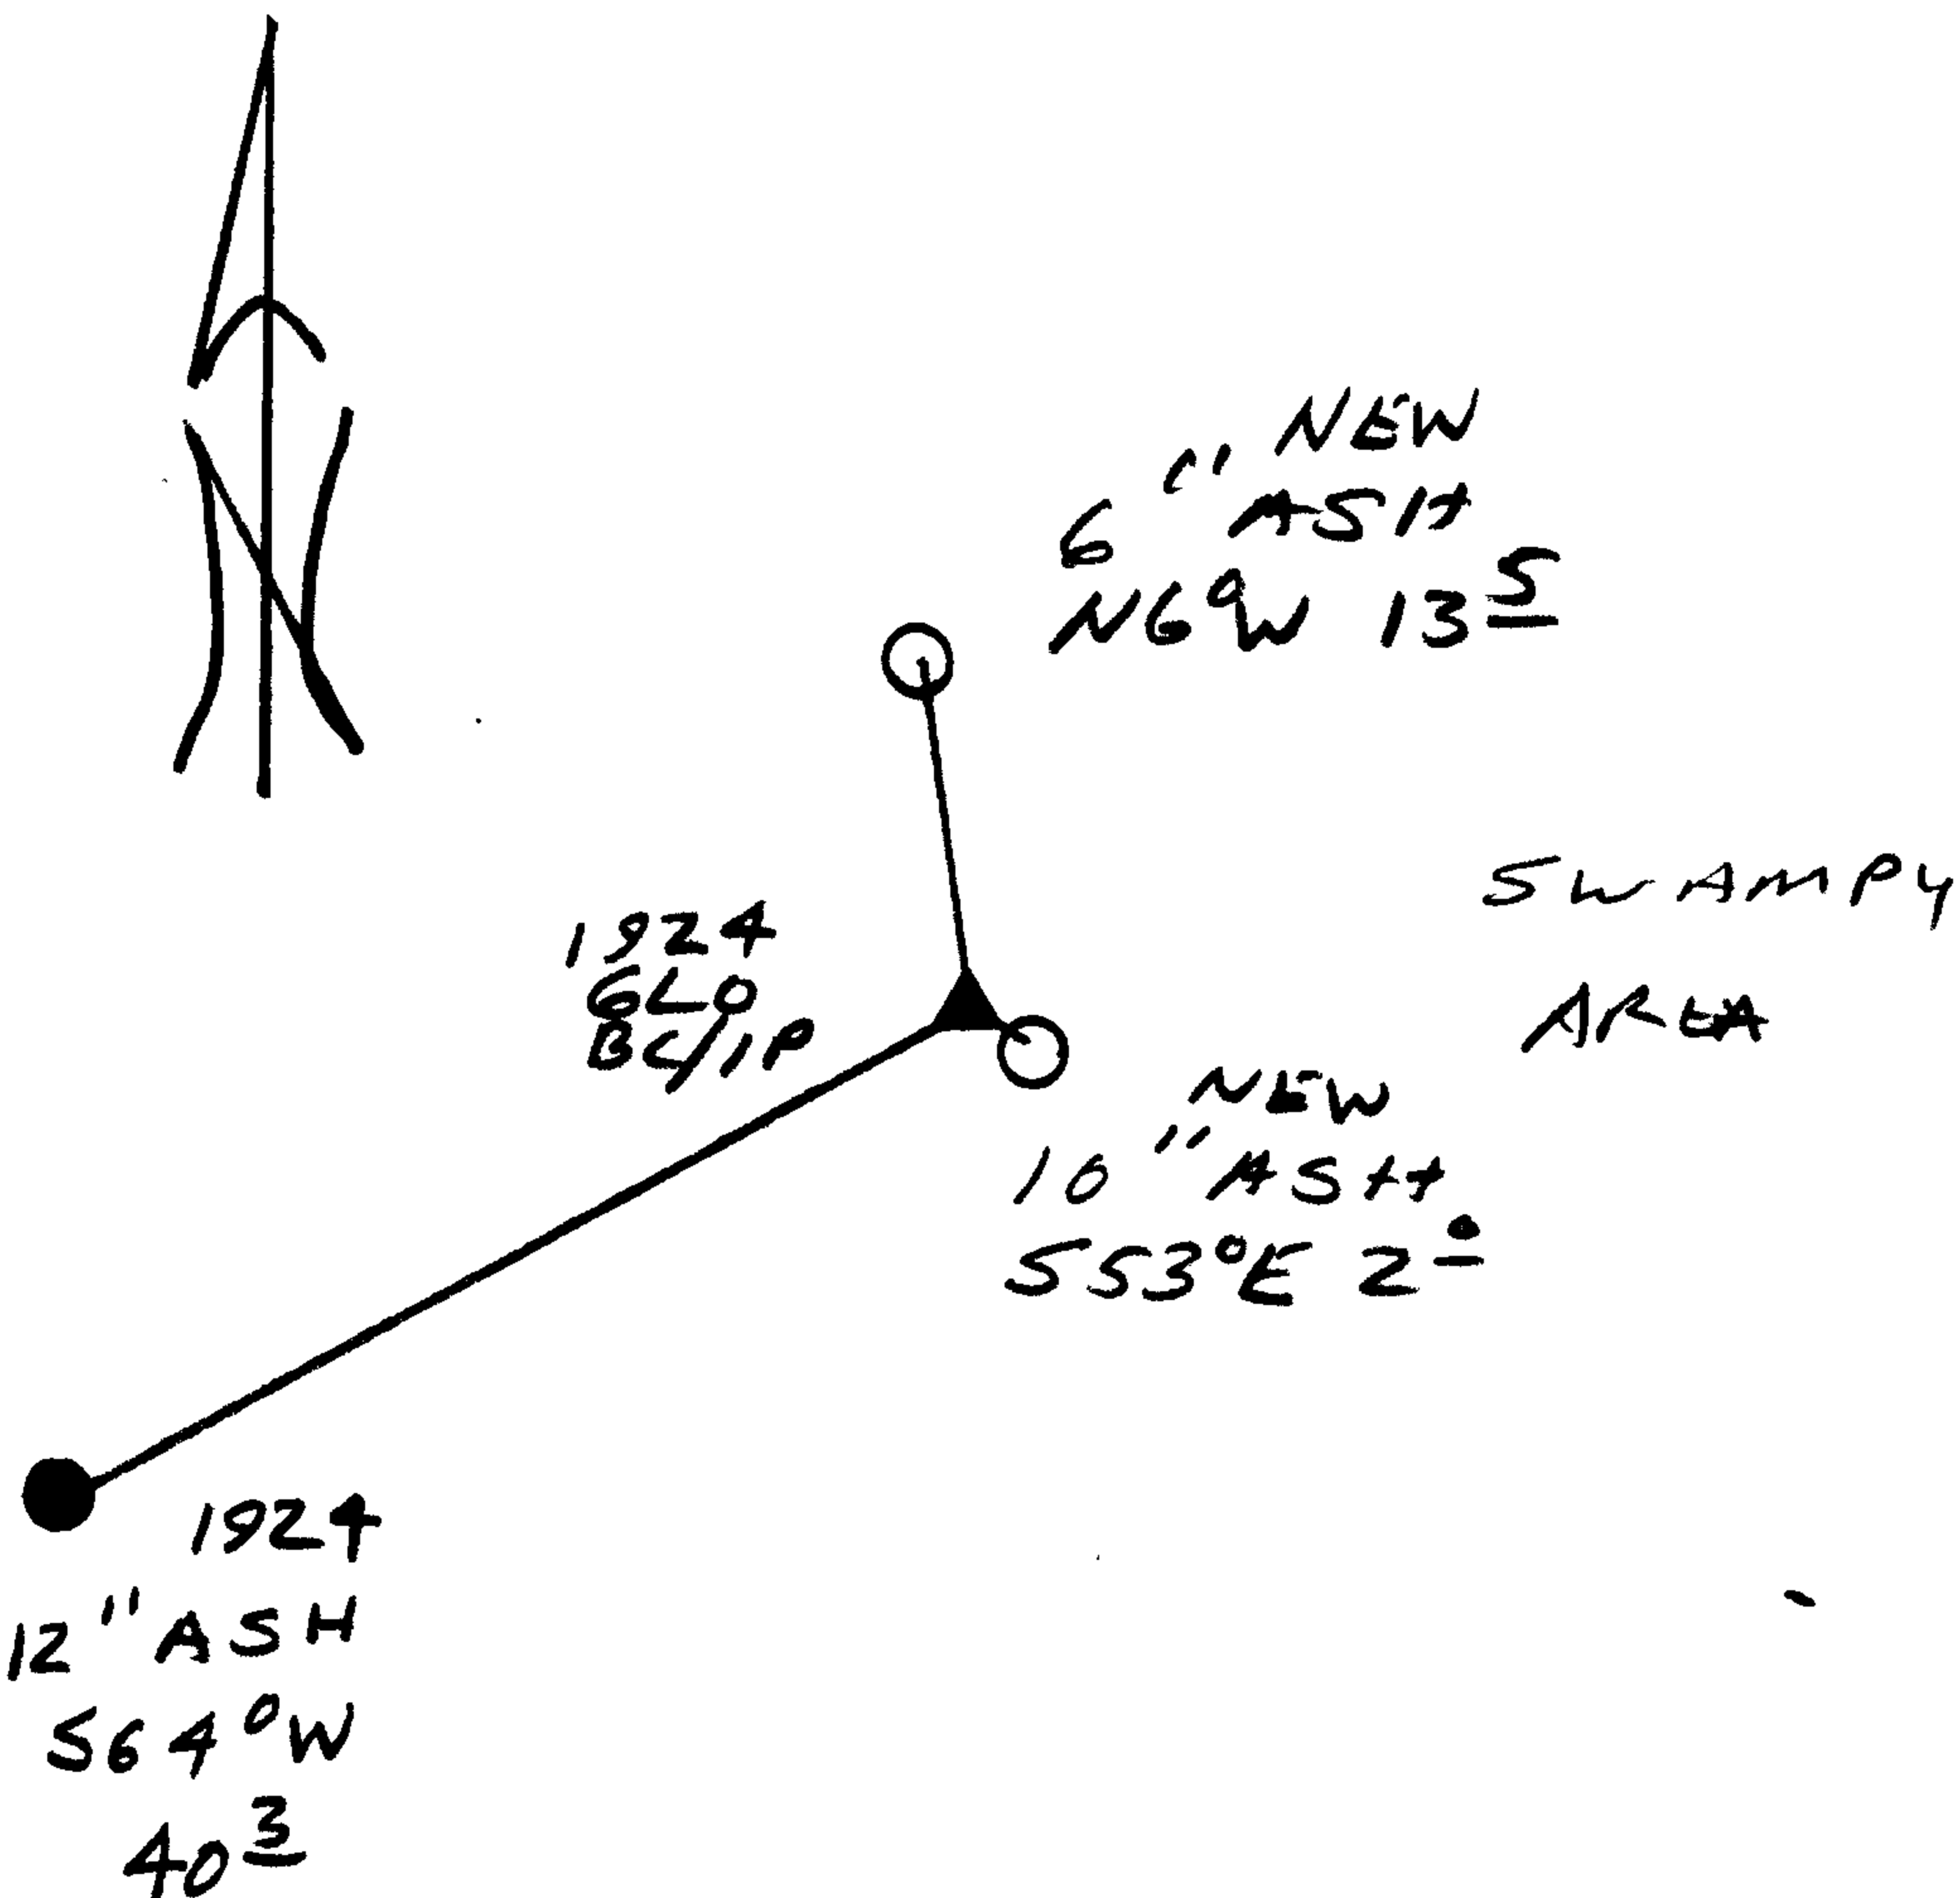

Location & Comments

Comp. Declin. 17 3/4° E
 Agency DLSG
 Party Chief RANDALL W. SMITH
 Notekeeper [Signature]
 Witnesses STEPHEN J. FLAUSK

Address

Surveyor's Seal

REGISTERED
PROFESSIONAL
LAND SURVEYOR

[Signature]
EXPIRES 6-30-98

OREGON
JULY 25, 1990
RANDALL W. SMITH
2469