

GOVERNMENT CORNER RESTORATION FORM

Date: 5-12-1998 By: JS

Township 28S Range 7W Sec. 5

County DOUGLAS

This survey consists of:

State OR Date 5-6-98

No. _____

Map: _____

Narrative: _____

Corner Rpt: 66/2-22

Corner Designation

A.P. WEST FROM N 1/4 SEC 5

DOUGLAS COUNTY

Condition RENEWED

Not Found

Renewed

Unrecorded

Surveyed In

Referenced Out

MONUMENT DETAIL

Previous Renewals 1924 GLO + 1961 DCS

Monument(s) Found: (Condition and Source)

2 1/2" DIA. GLO BRASS CAP ON A
1" DIA. IRON PIPE PROTRUDES
9" ABOVE GROUND, LEANS
0.5 FT SOUTH EASTERLY OF PLUMB
(1924 GLO)

U.S. GENERAL LAND OFFICE

AP

1924
SURVEY

Accessories Found:

20" NOW 30" DIA MADRINK WITH AN OPEN ROTTED BLAZE,
NO SCRIBING VISIBLE, AND A FULLY HEALED DOUBLE BLAZE,
BEARS S 40° E, 29.0 FT (AGREES WITH ORIG. REC.) 0BT

14" D. FIRM^{ish} ROTTED REMAINS WITH ILLEGIBLE SCRIBING FOUND,
BEARS N 35° W, 25.1 FT (AGREES WITH REC.) 1924

8" PINK NOW ROTTED REMAINS WITH SCRIBING FOUND "T"
BEARS N 14° E, 13.2 FT (REC. N 17° E, 13.2 FT) 1924

9" NOW 18" DIA. 1 FT HIGH D. FIR STUMP, NO MARKS
VISIBLE, BEARS N 29 1/2° E, 26.2 FT (AGREES WITH REC.)
1961 (NOTE STUMP IS SOLID)

RENEWAL

Monument Set (Procedure and Description)

BC/IP RETURNED TO PLUMB POSITION,
PROTRUDS 4" ABOVE GROUND

Monument Detail


N/A

New Accessories

9" DIA D.FIR DOUBLE BLAZED AND SCRIBED "APCS BT"
BEARS N 2° W, 15.3 FT

5" DIA. D.FIR DOUBLE BLAZED AND SCRIBED "APCS BT"
BEARS S 1 1/2° W, 8.2 FT

Sketch of Monument, Accessories, and General Area

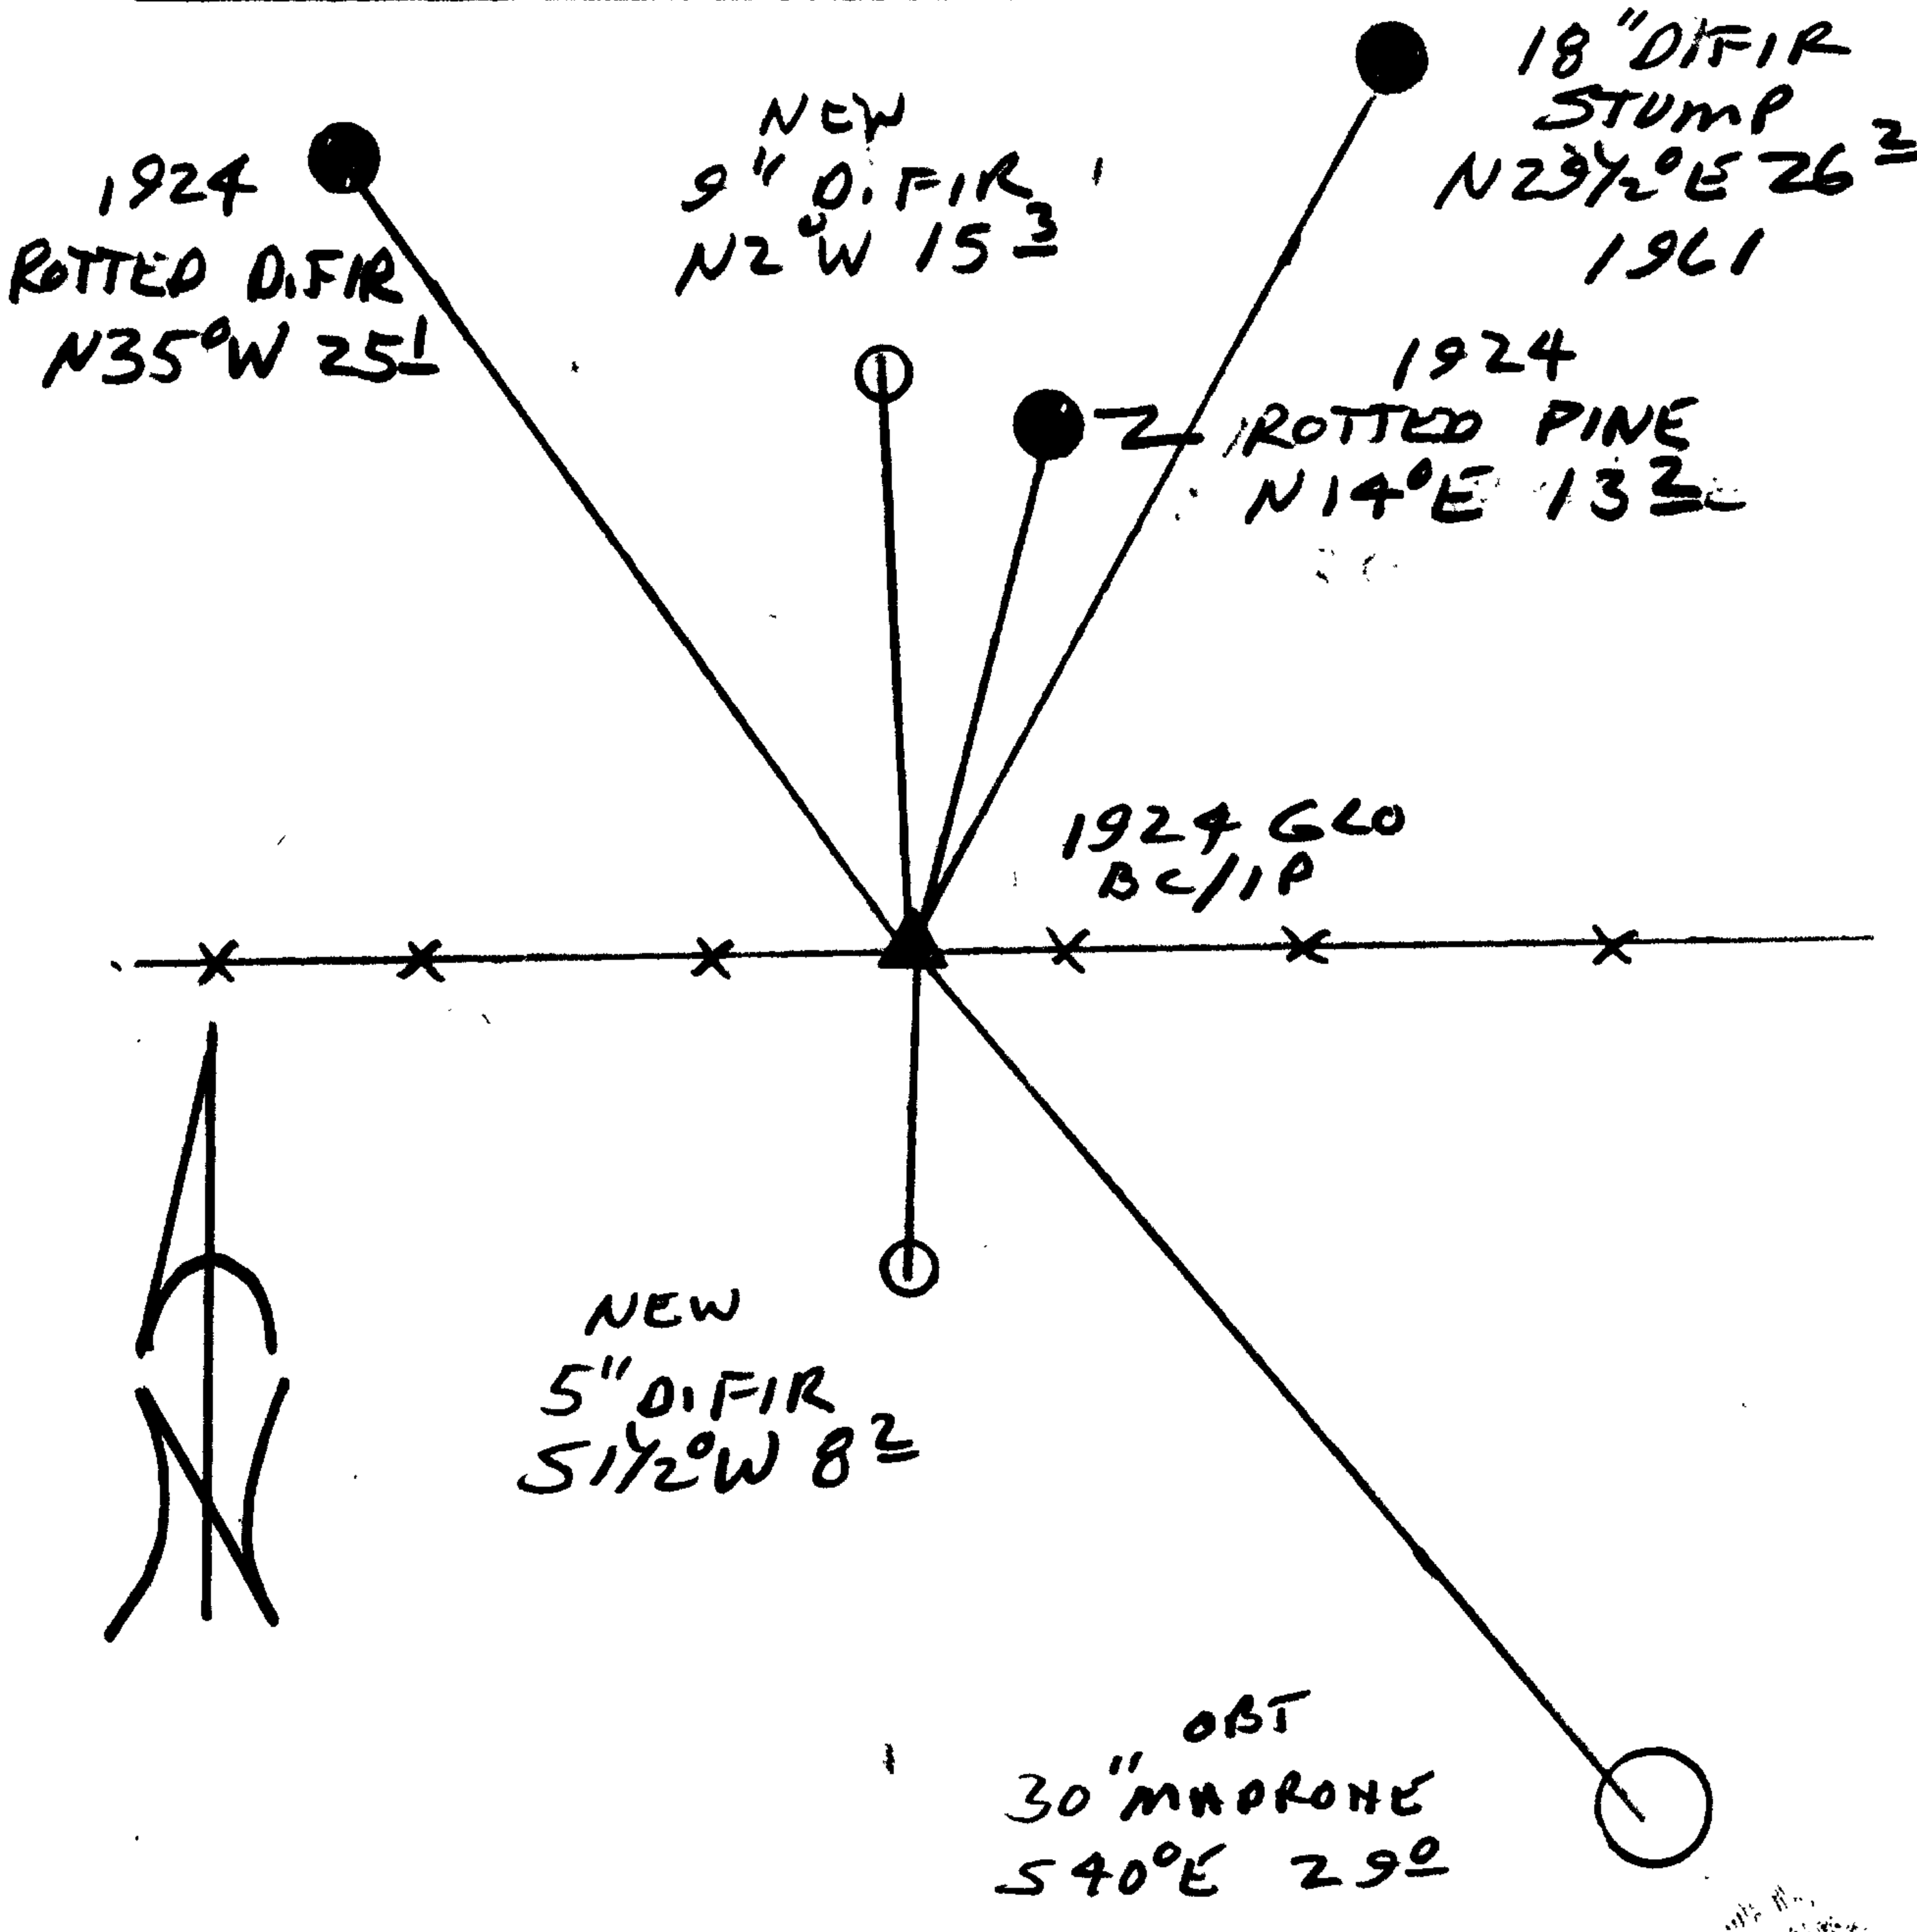

Location & Comments

CORNER LIES IN AN
E-W FENCE LINE

Comp. Declin. 17 3/4° E
 Agency DCSO
 Party Chief RANDALL W. SMITH
 Notekeeper [Signature]
 Witnesses STEPHEN J. FLAHERTY

Address

Surveyor's Seal

REGISTERED
 PROFESSIONAL
 LAND SURVEYOR

[Signature]
 EXPIRES 6-30-99

OREGON
 JULY 26, 1980
 RANDALL W. SMITH
 2469