

FILED

GOVERNMENT CORNER RESTORATION FORM

Date: 5/19/1998 By: J
This survey consists of:

Township 28S Range 7W Sec. 7 1/2 County DOUGLAS

State OR Date 5-13-98 No. _____

Narrative: _____
Corner Rpt: 66/2-30

Corner Designation

S 12 | 57
S 13 | 58

DOUGLAS COUNTY

SURVEYOR

Condition Report Only

Not Found

Renewed

Unrecorded

Surveyed In

Referenced Out

MONUMENT DETAIL

Previous Renewals 1924 620, 1961 DCSO

Monument(s) Found: (Condition and Source)

2 1/2" DIA BRASS CAP ON A 2"
ODD IRON PIPE, PREVIOUS
8" ABOVE GROUND, (1924)

U.S. GENERAL LAND OFFICE
T28S

R8W

R7 1/2 W

S 12 | 57
S 13 | 58

1924
SURVEY

Accessories Found:

FOUND A 4 1/2" DIA D.F.I.R WITH HEADED BLAZES
BEARS S 80° W, 6.6 FT (AGREES WITH RECORD) DIST

18" NOW 22" DIA 10 FT HIGH ROTTED D.F.I.R SNAG
WITH A PARTIALLY HEADED BLAZE, SCRIBING
VISIBLE "T28S R8W S12 CS BT" BEARS N 54 1/2° W,
77.0 FT (AGREES WITH REC.) 1961

RENEWAL

Monument Set (Procedure and Description)

NONE

Monument Detail


N/A

New Accessories

11" DIA. CEDAR DOUBLE BLAZED AND SCRIBED "T285 R8W S12CS BT"
 BEARS N57°W, 43.2 FT

5" DIA. D. FIR DOUBLE BLAZED AND SCRIBED "X CS BT"
 BEARS N64½°E, 8.4 FT

Sketch of Monument, Accessories, and General Area

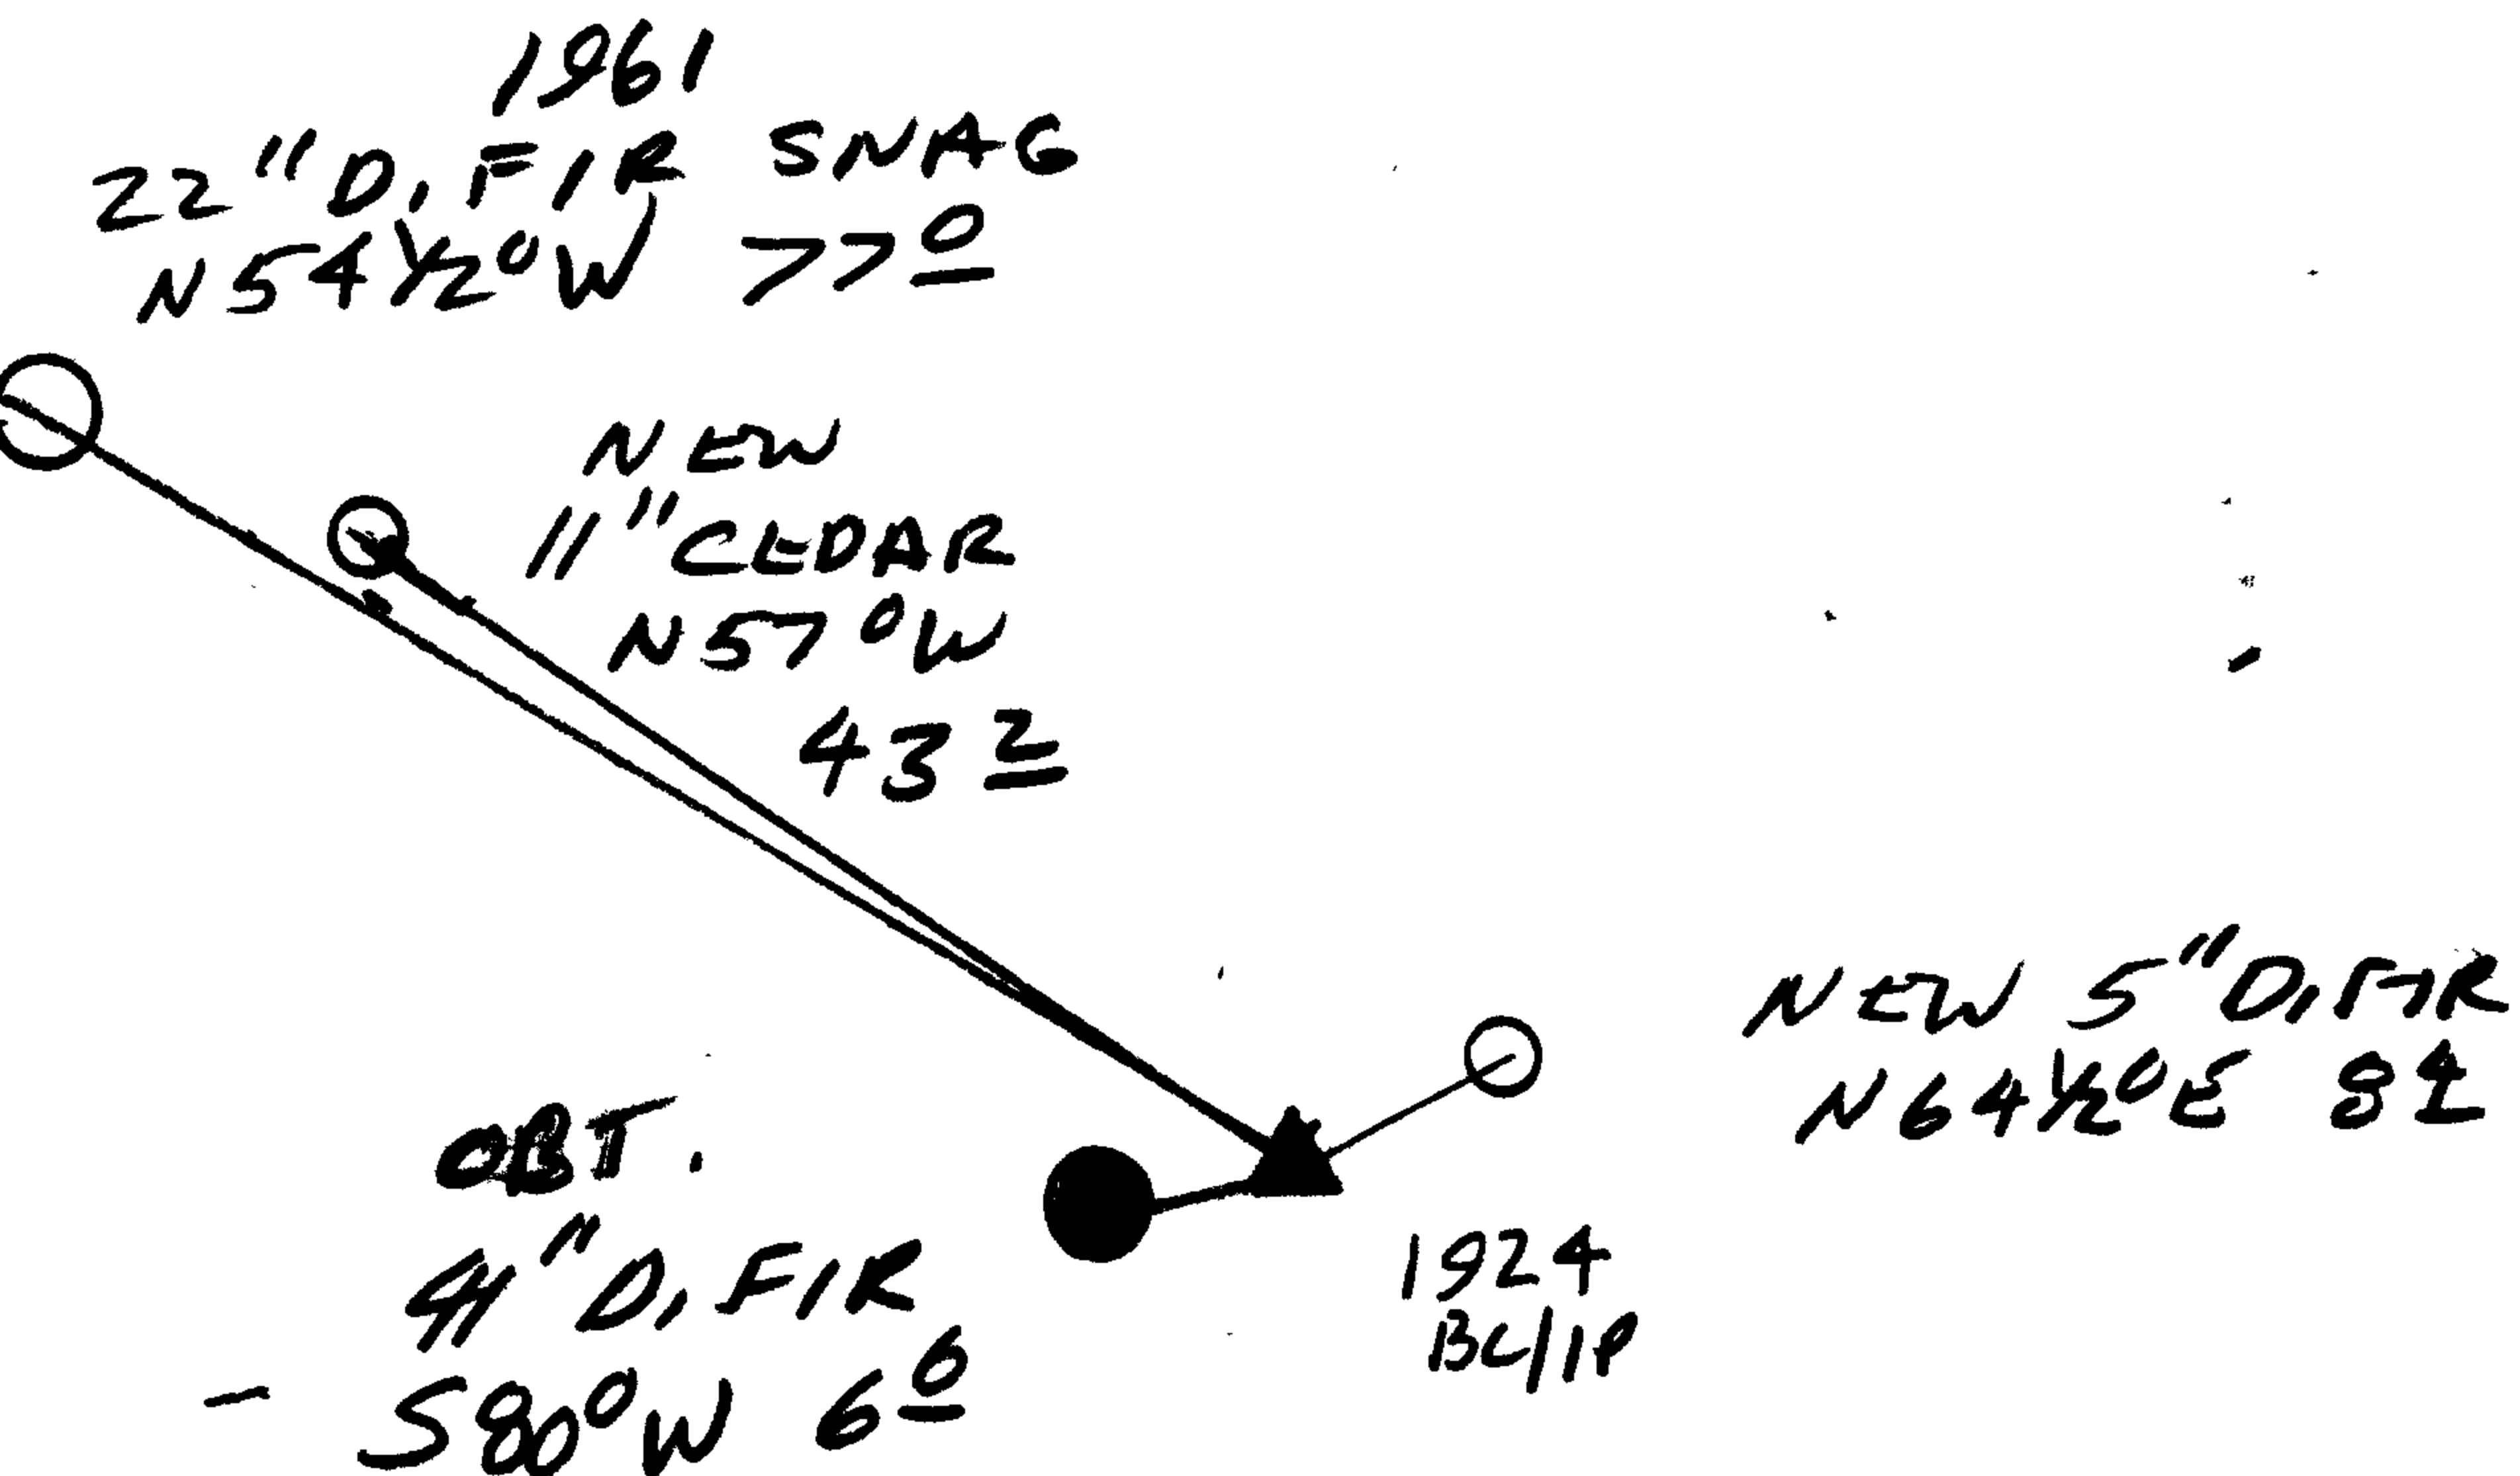

Location & Comments

Comp. Declin. 17 3/4° E
 Agency DESO
 Party Chief RANDALL W. SMITH
 Notekeeper [Signature]
 Witnesses STEPHEN J. FLAISE

Address

Surveyor's Seal

REGISTERED
 PROFESSIONAL
 LAND SURVEYOR

[Signature]
 EXPIRES 6-30-98

OREGON
 JULY 25, 1990
 RANDALL W. SMITH
 2469