

GOVERNMENT CORNER RESTORATION FORM

Date: 5-19-1998 By: JC

Township 28S Range 7 1/2 W Sec. 18

County DOUGLAS Map: _____

State OR Date 5-14-98

No. _____ Narrative: _____

Corner Rpt: 66/2-32

Corner Designation

1/4
S13 | S18

DOUGLAS COUNTY

~~Condition Report Only~~

~~Not Found~~

Renewed

~~Unrecorded~~

~~Surveyed In~~

~~Referenced Out~~

MONUMENT DETAIL

Previous Renewals 1924 620, 1961 DC50

Monument(s) Found: (Condition and Source)

2 1/2" DIA BRASS CAP ON A
1" O.D. IRON PIPE, PROTRUDS
5" ABOVE GROUND, 1924

U.S. GENERAL LAND OFFICE

NOTE BRASS CAP ORIENTATED
SOUTH EAST

1/4

S13 | S18

R 7 1/2

1924

Survey

Accessories Found:

ORIG. NE BT NOW GONE

6" ~~BRASS~~ ROTTED TO GROUND STUMP SCRIBING FOUND
"4 S13 BT" BEARS N 31° W / 26.4 FT
(AGREES WITH REN. RECORDS) 0BT

1961 DC50 BT NOW ROTTED FIR REMAINS NEAR
RECORD "S 5° E, 13.5 FT" NO SCRIBING FOUND.

RENEWAL

Monument Set (Procedure and Description)

NONE

Monument Detail

N/A


New Accessories

6" DIA. D. FIR DOUBLE BLAZED AND SCRIBED "Y4S18CSBT"
 BEARS S61°E 4.8 FT

10" DIA. G. FIR DOUBLE BLAZED AND SCRIBED "Y4S13CSBT"
 BEARS N41Y2°W 21.0 FT

8" DIA. G. FIR DOUBLE BLAZED AND SCRIBED "Y4S13CSBT"
 BEARS S87°W 28.5 FT

Sketch of Monument, Accessories, and General Area

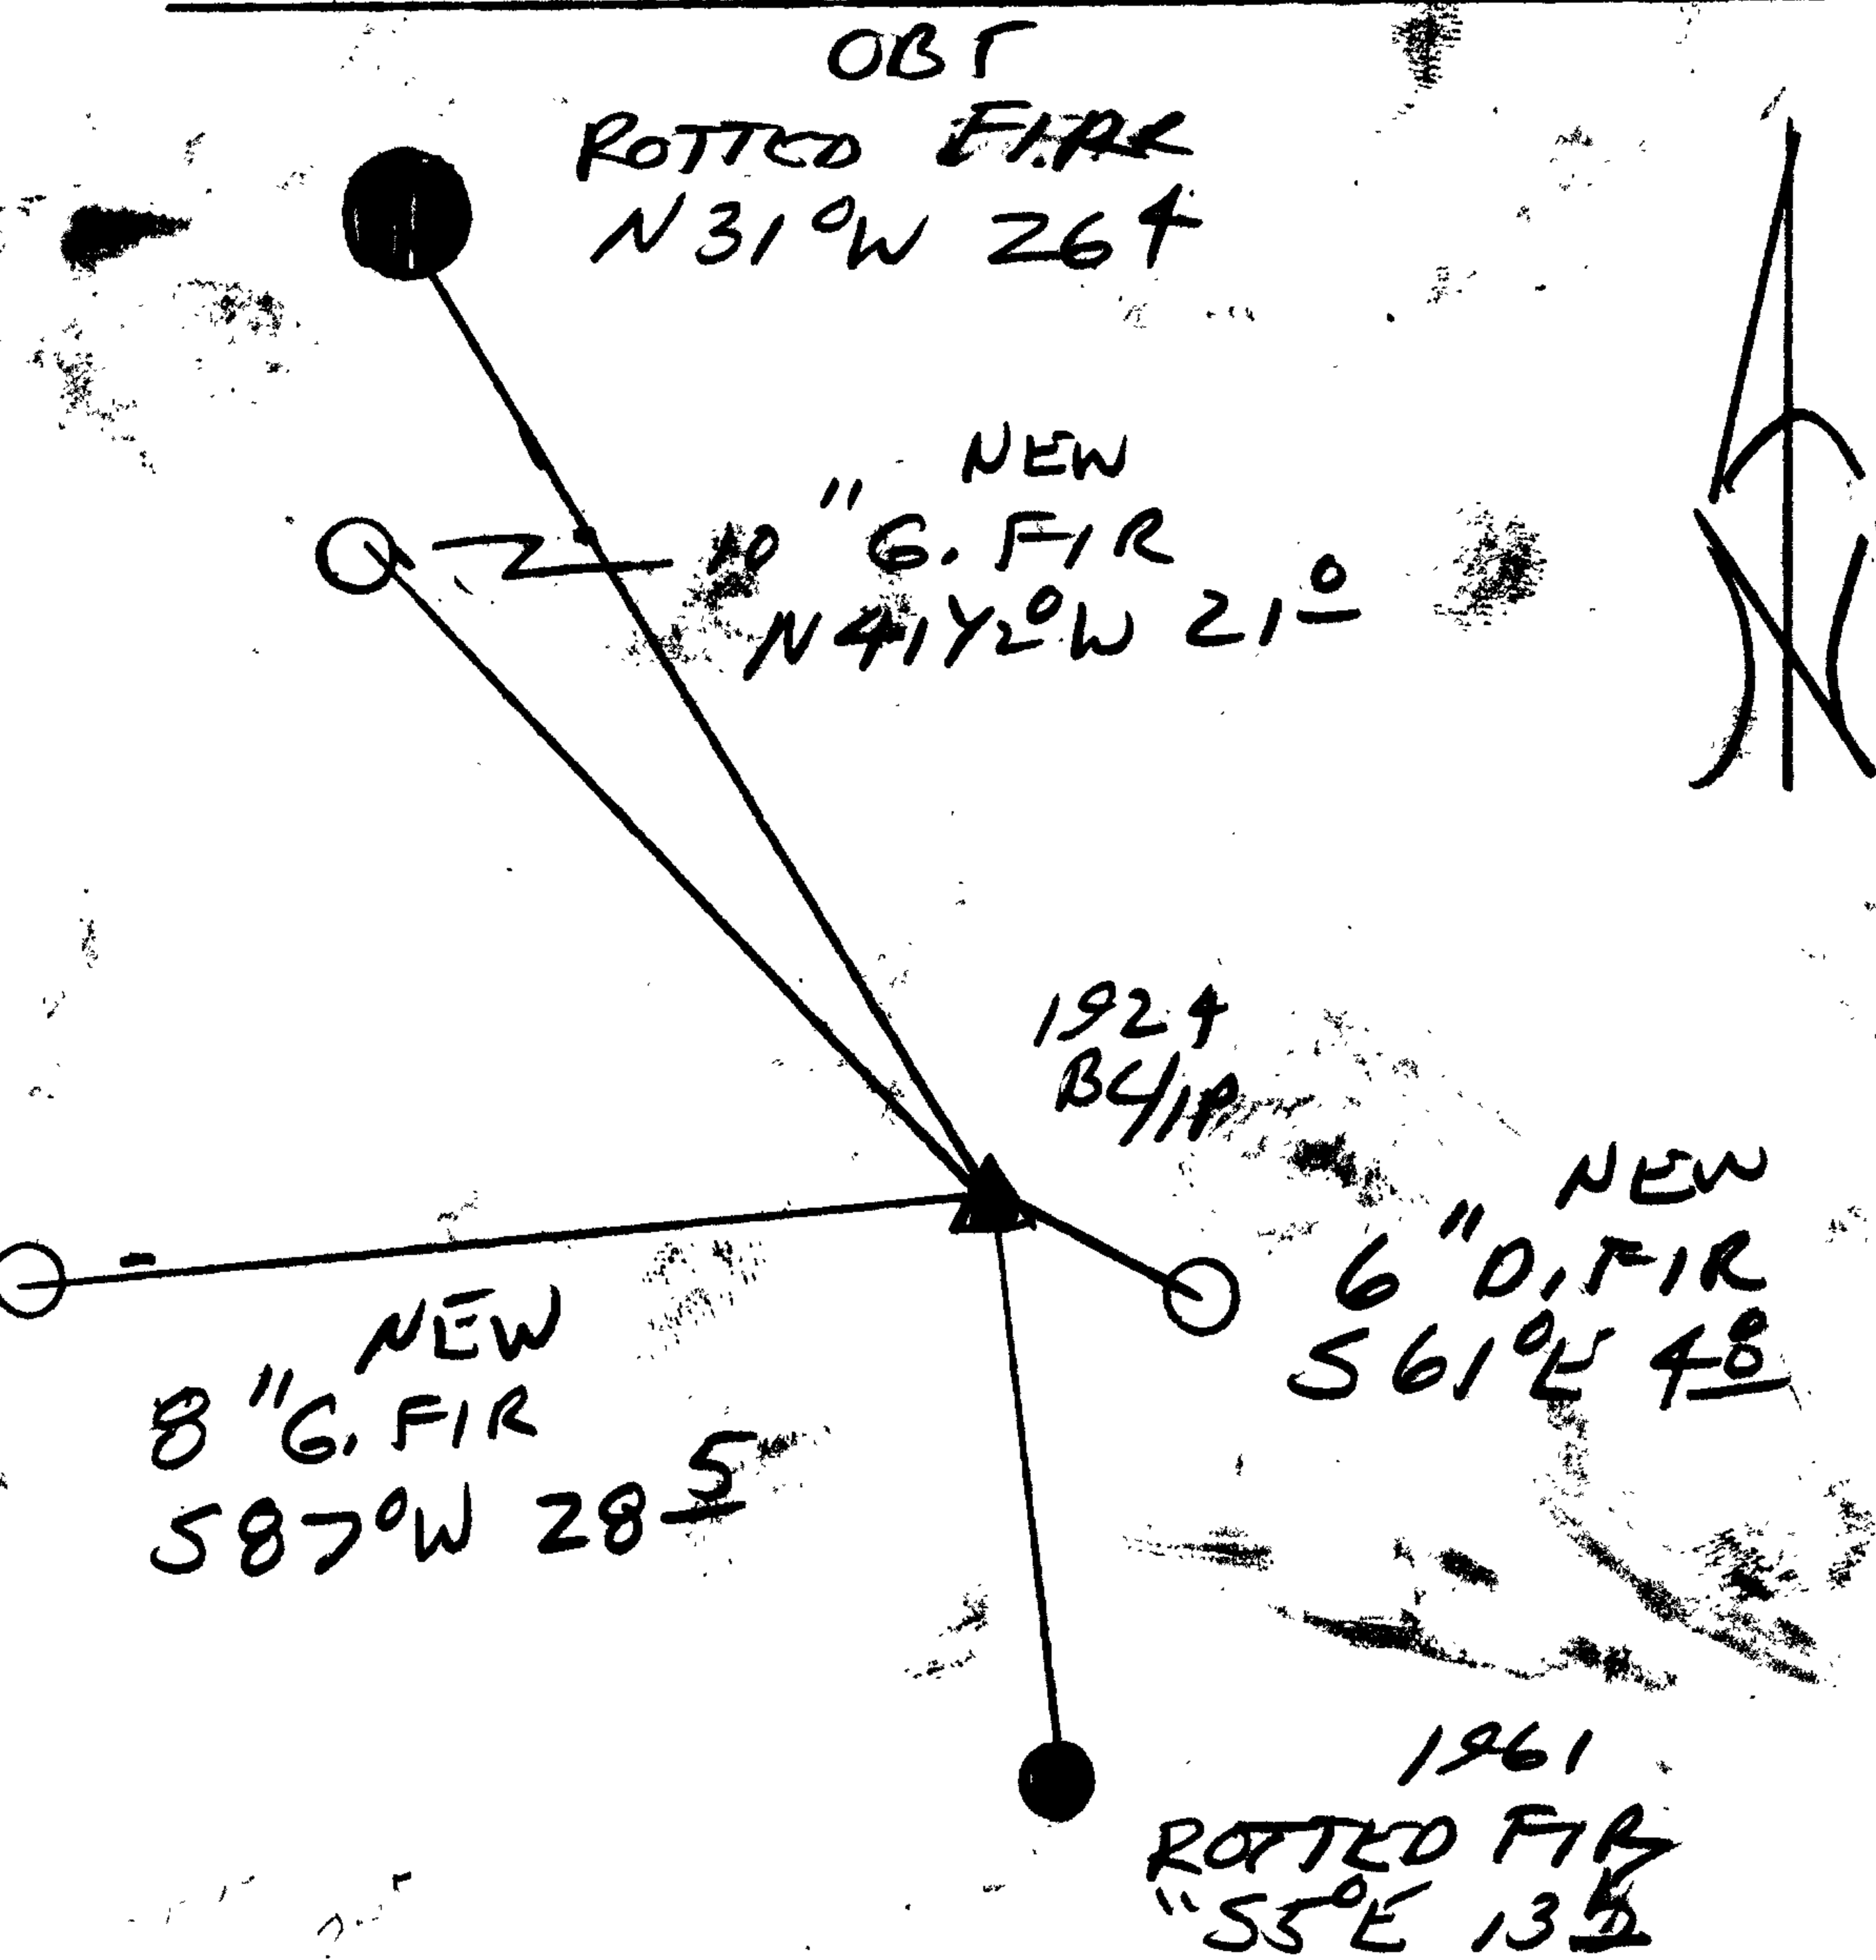

Location & Comments

CORNER LIES APPROX
 S45°W 100 FT
 FROM END OF ROAD

Comp. Declin. 179°E
 Agency
 Party Chief RANDALL W. SMITH
 Notekeeper
 Witnesses STEVEN J. FINE

Address

Surveyor's Seal

REGISTERED PROFESSIONAL LAND SURVEYOR

OREGON
 JULY 25, 1980
 RANDALL W. SMITH
 2489