



RENEWAL

Monument Detail

Monument Set (Procedure and Description)

NONE

BC/IP NOT SET, HILL SIDE IS STEEP & FEEL THAT BC/IP WOULD NOT HOLD


N/A

New Accessories

22" DIA. HEMLOCK DOUBLE BLAZED AND SCRIBED "1/4 SICS BT" BEARS 565°E, 4.8 FT.

8" DIA DIFIR DOUBLE BLAZED AND SCRIBED "1/4 S2 CSBT" BEARS N10°W, 16.8 FT

Sketch of Monument, Accessories, and General Area

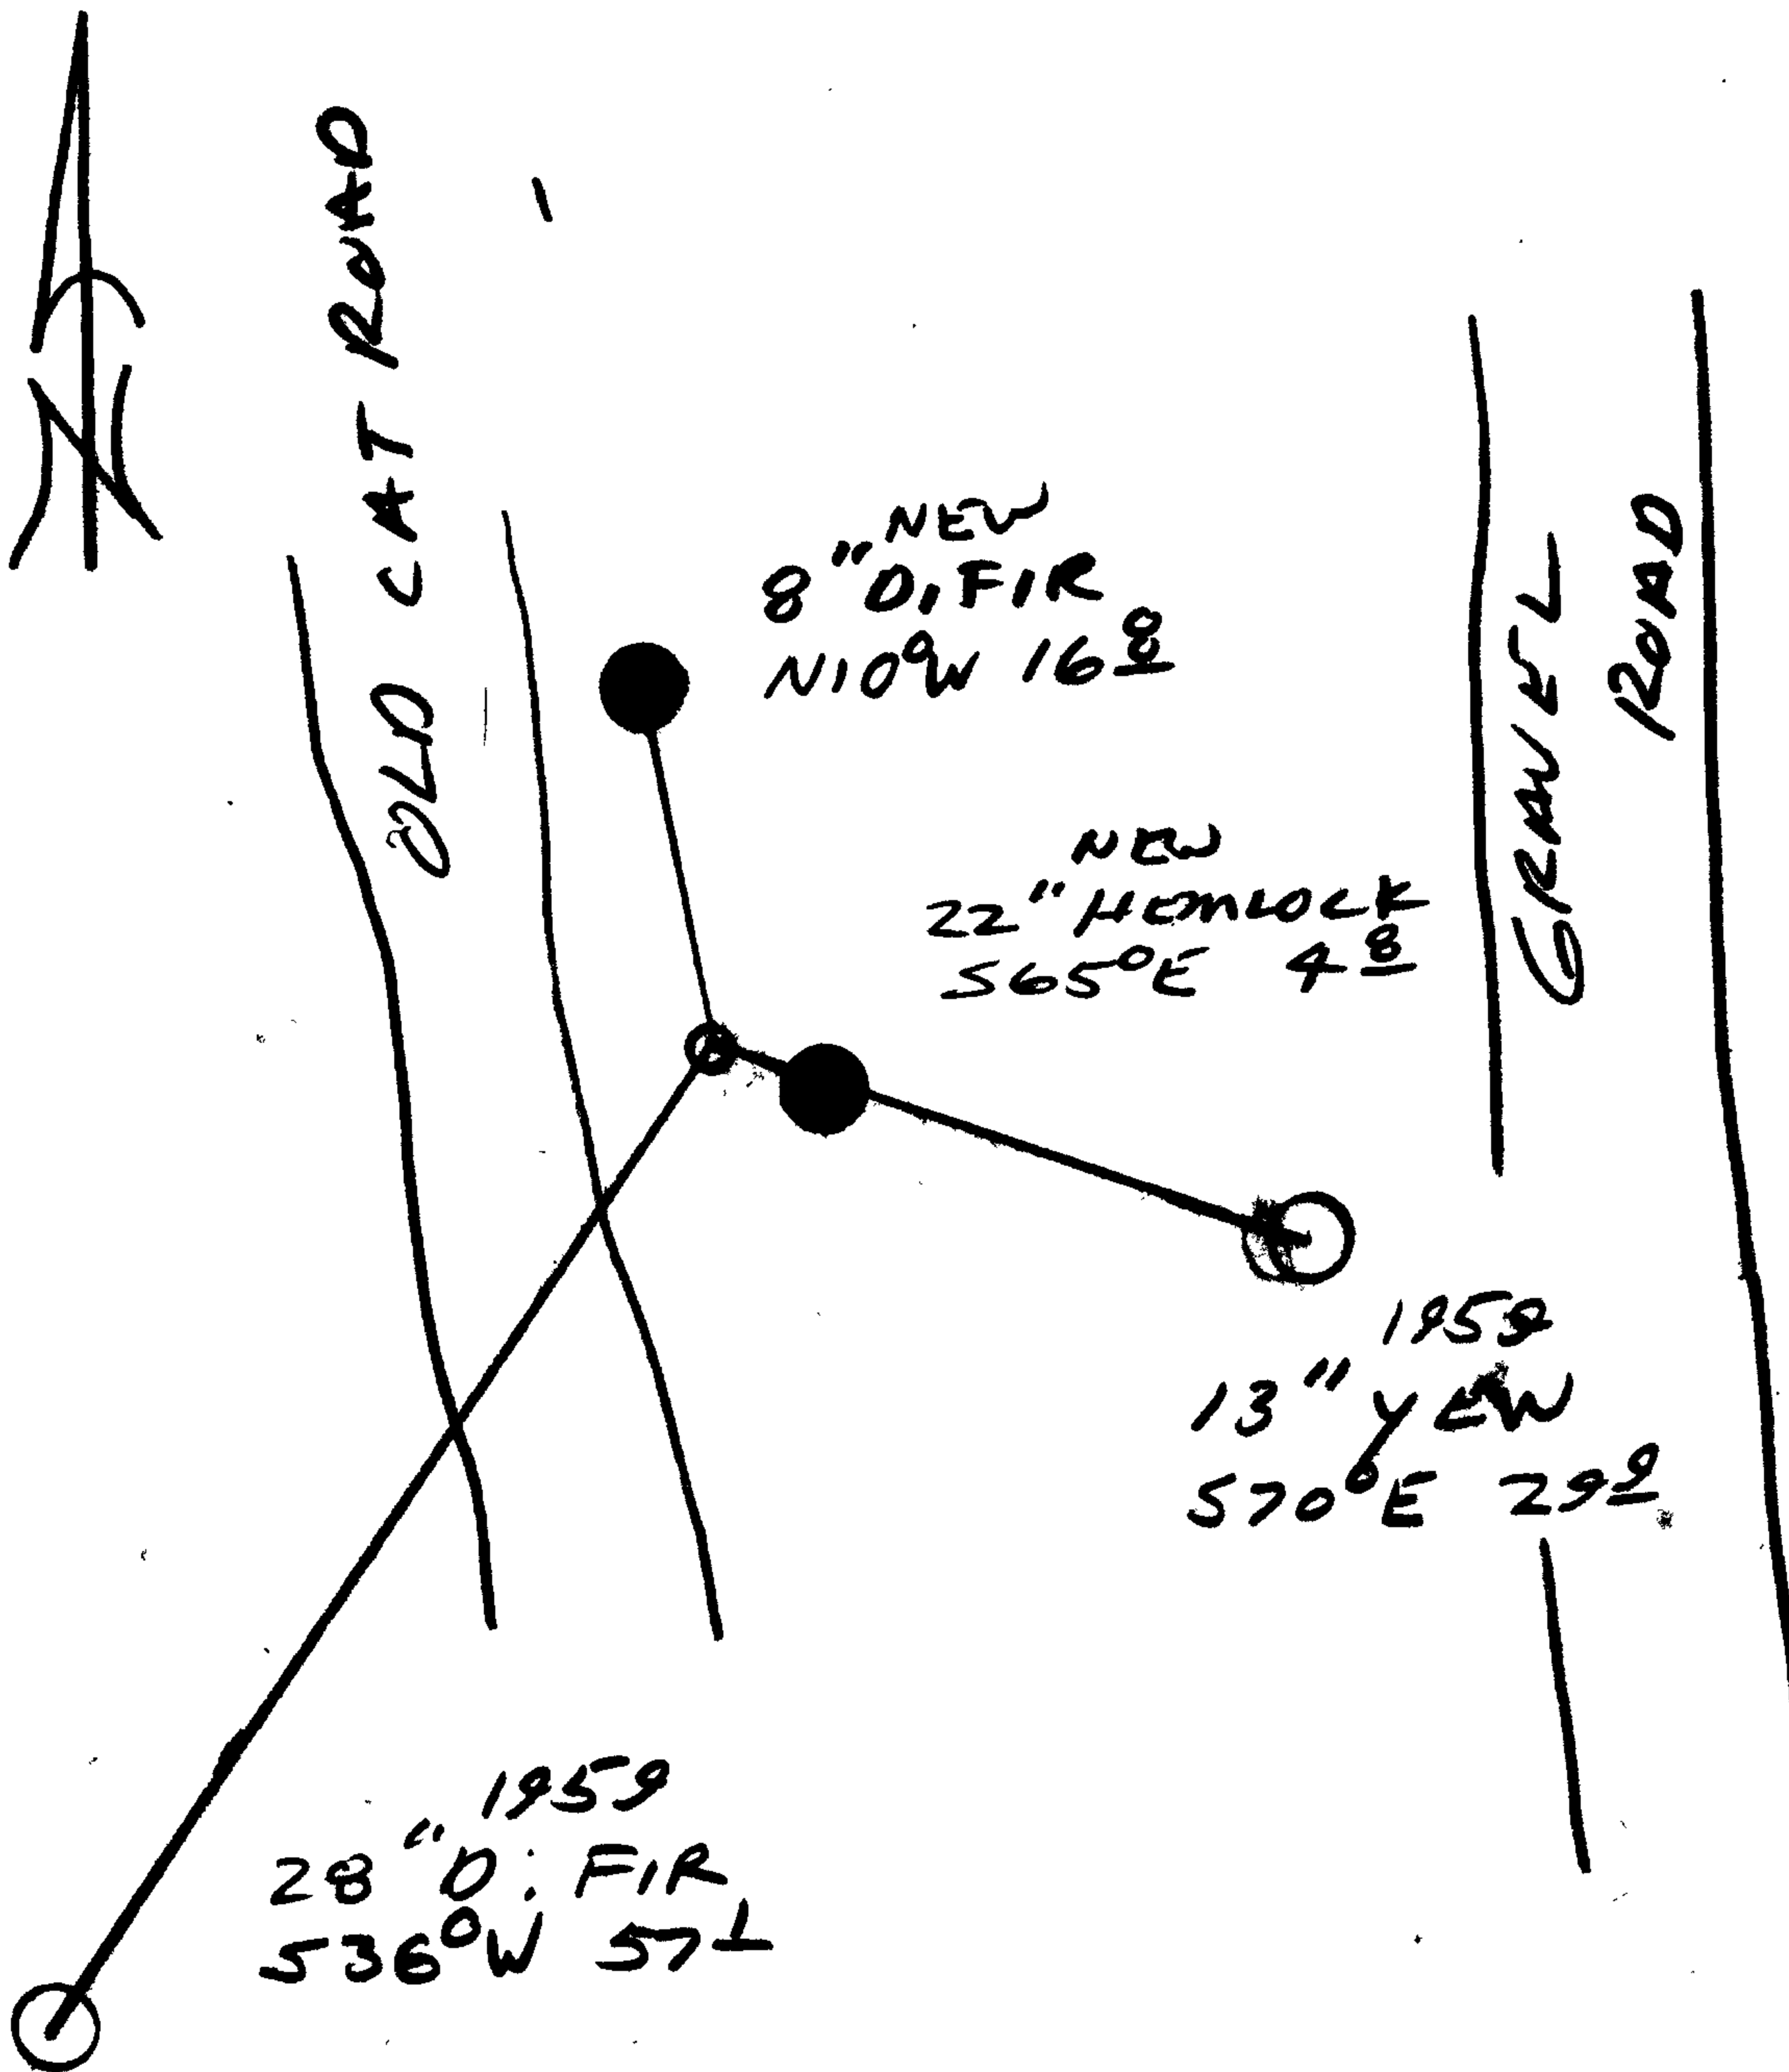

Location & Comments

CORNER LIES ON A STEEP WEST SLOPE APPROX 35 FT WEST OF A GRAVEL ROAD

Comp. Declin. 17 3/4°E  
 Agency DCSO  
 Party Chief RANDALL SMITH  
 Notekeeper [unclear]  
 Witnesses STEPHEN J. [unclear]

Address

Surveyor's Seal

