

GOVERNMENT CORNER RESTORATION FORM

Date: 5/21/98 By: X

Township 31S Range 4W Sec. 35 County DOUGLAS

This survey consists of:

State OR Date 5-20-98 No. _____

Map: _____

Corner Designation AS DETERMINED BY M 41-5

Narrative: _____

Corner Rpt: 66/2-37

$\frac{1}{4}$ $\frac{S35}{SR}$

DOUGLAS COUNTY

- Condition Surveyor Only
- Not Found
- Renewed
- Unrecorded
- Surveyed In
- Referenced Out

Previous Renewals M 41-5 1970

MONUMENT DETAIL

Monument(s) Found: (Condition and Source)

5/8" IRON ROD PROTRUDES
3" ABOVE GROUND (41-5)

N/A

Accessories Found:

8" DIA MADRONE WITH A PARTIALLY HEALED SINGLE
BLAZE SCRIBING VISIBLE "S 1/4 S1 35 T
BEARS N 68° W, 19.5 FT (AGREES WITH RT TAG
DATED 5-70 BY MARTIN). (M 41-5)

16" DIA MADRONE WITH A PARTIALLY HEALED SINGLE
BLAZE SCRIBING VISIBLE "N 1/4 S2 BT" BEARS
S 44 1/2° W, 33.7 FT (REC PER RT TAGS S 40 1/4° W
33.7 FT / DATED 5-70 BY DRM) (M 41-5)

RENEWAL

Monument Set (Procedure and Description)

NONE

Monument Detail


N/A

New Accessories

18" DIA D. FIR DOUBLE BLAZED AND SCRIBED "Y4 S² CS BT"
BEARS S 73° W, 7.1 FT

15" DIA D. FIR DOUBLE BLAZED AND SCRIBED "Y4 S³⁵ CS BT"
BEARS N 14° E, 23.6 FT

Sketch of Monument, Accessories, and General Area

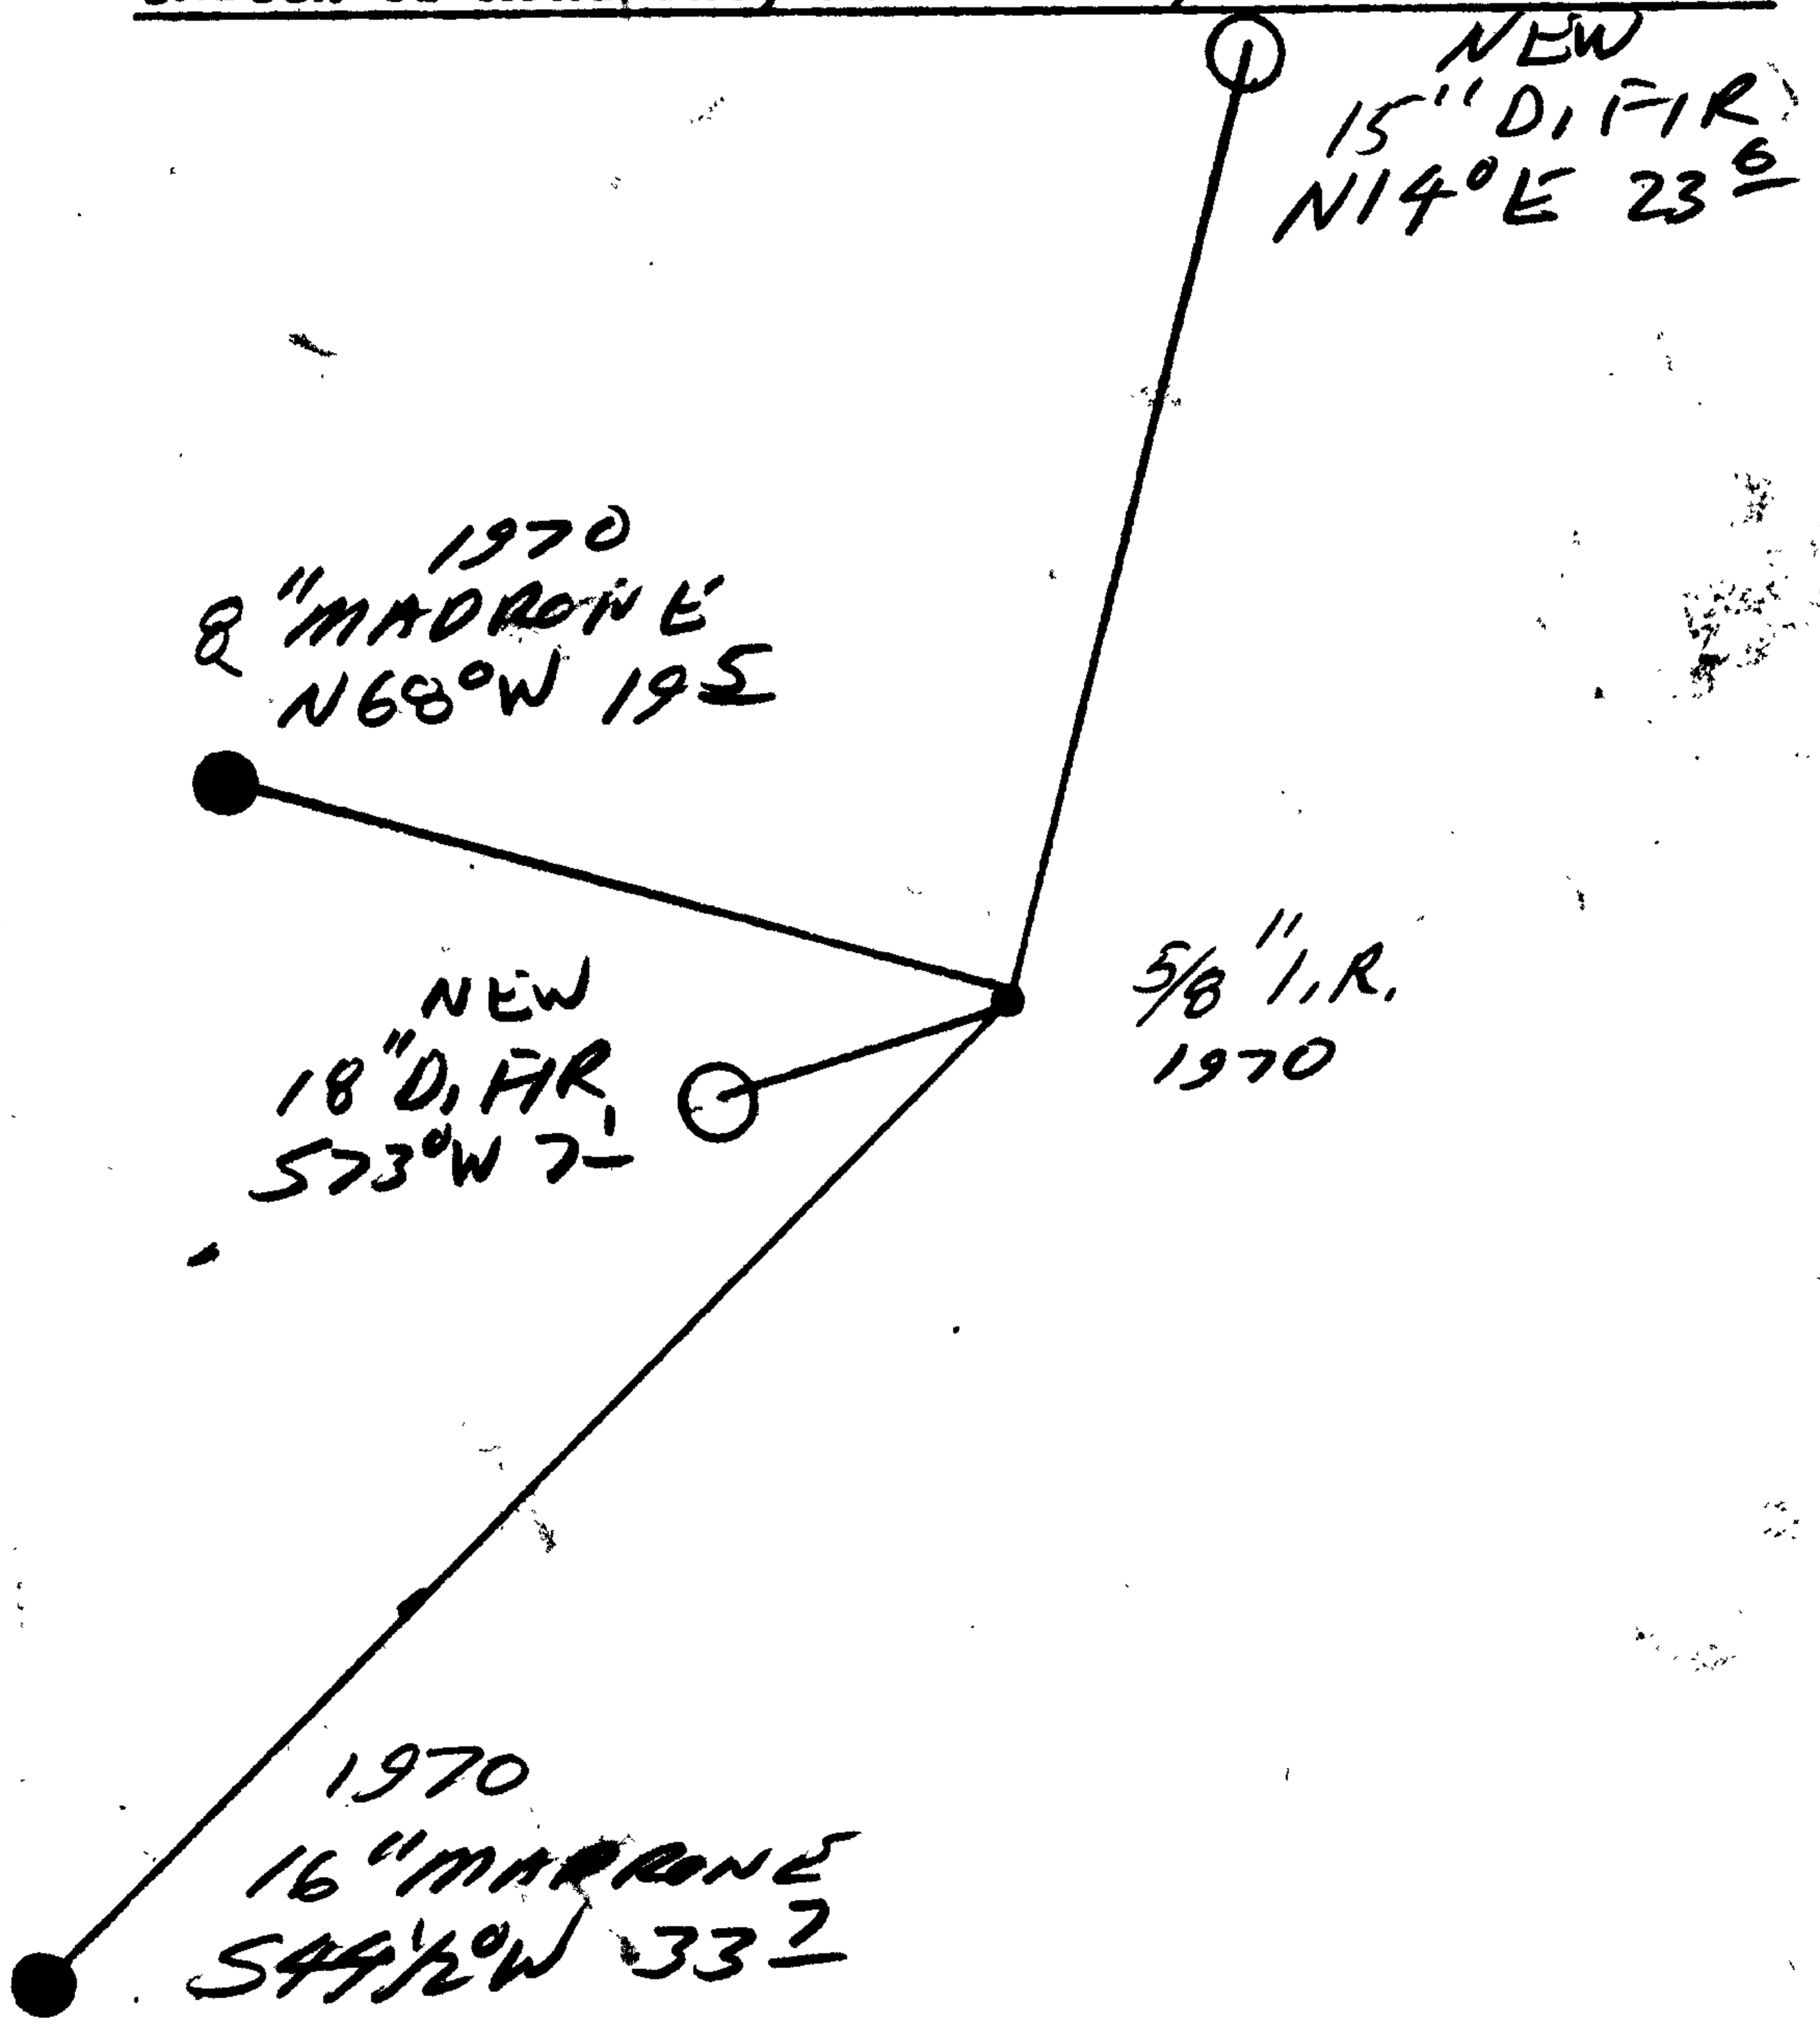

Location & Comments

NEW BLAZED LINES RUN SOUTH AND EAST FROM FD L.R.

Comp. Declin. 17 3/4° E
 Agency DCS
 Party Chief RANDALL W. SMITH
 Notekeeper [Signature]
 Witnesses STEPHEN J. FLAUSK

Address

Surveyor's Seal

REGISTERED
PROFESSIONAL
LAND SURVEYOR

[Signature]

EXPIRES 6-30-98

OREGON
JULY 25, 1990
RANDALL W. SMITH
2489