

GOVERNMENT CORNER RESTORATION FORM

Township 32S Range 4W Sec. 3

County DOUGLAS

Date: 5/29/1998 By: X

This survey consists of:

State OK

Date 5-21-98

No. \_\_\_\_\_

Map: \_\_\_\_\_

Narrative: \_\_\_\_\_

Corner Rpt: 66/2-39

Corner Designation

CC  $\frac{S3}{S10}$  | S11

- Condition Report Only
- Not Found
- Renewed
- Unrecorded
- Surveyed In
- Referenced Out

MONUMENT DETAIL

Previous Renewals 1959 BLM

Monument(s) Found: (Condition and Source)

3 1/2" DIA BRASS ON AN IRON PIPE IS FOUND UNDER A LARGE ROTTEN DOWN D. FIR BRASS CAP IS FLUSH WITH GROUND. 1959

U.S. CADASTRAL SURVEY

T32S 124W

CC  $\frac{S3}{S10}$  | S11

1959

BUREAU OF LAND MANAGEMENT

Accessories Found:

7" NOW 19" DIA. D. FIR WITH A FULLY HEALED SINGLE BLAZE BEARS N 63 1/2° W, 125.7 FT (AGREES WITH REC.) 1959

5" NOW 10" DIA. D. FIR WITH A FULLY HEALED SINGLE BLAZE BEARS S 55° W, 4.6 FT (REC. S 45° W, 4.6 FT) 1959

RENEWAL

Monument Set (Procedure and Description)

NONE


Monument Detail

N/A

New Accessories

NONE

Sketch of Monument, Accessories, and General Area

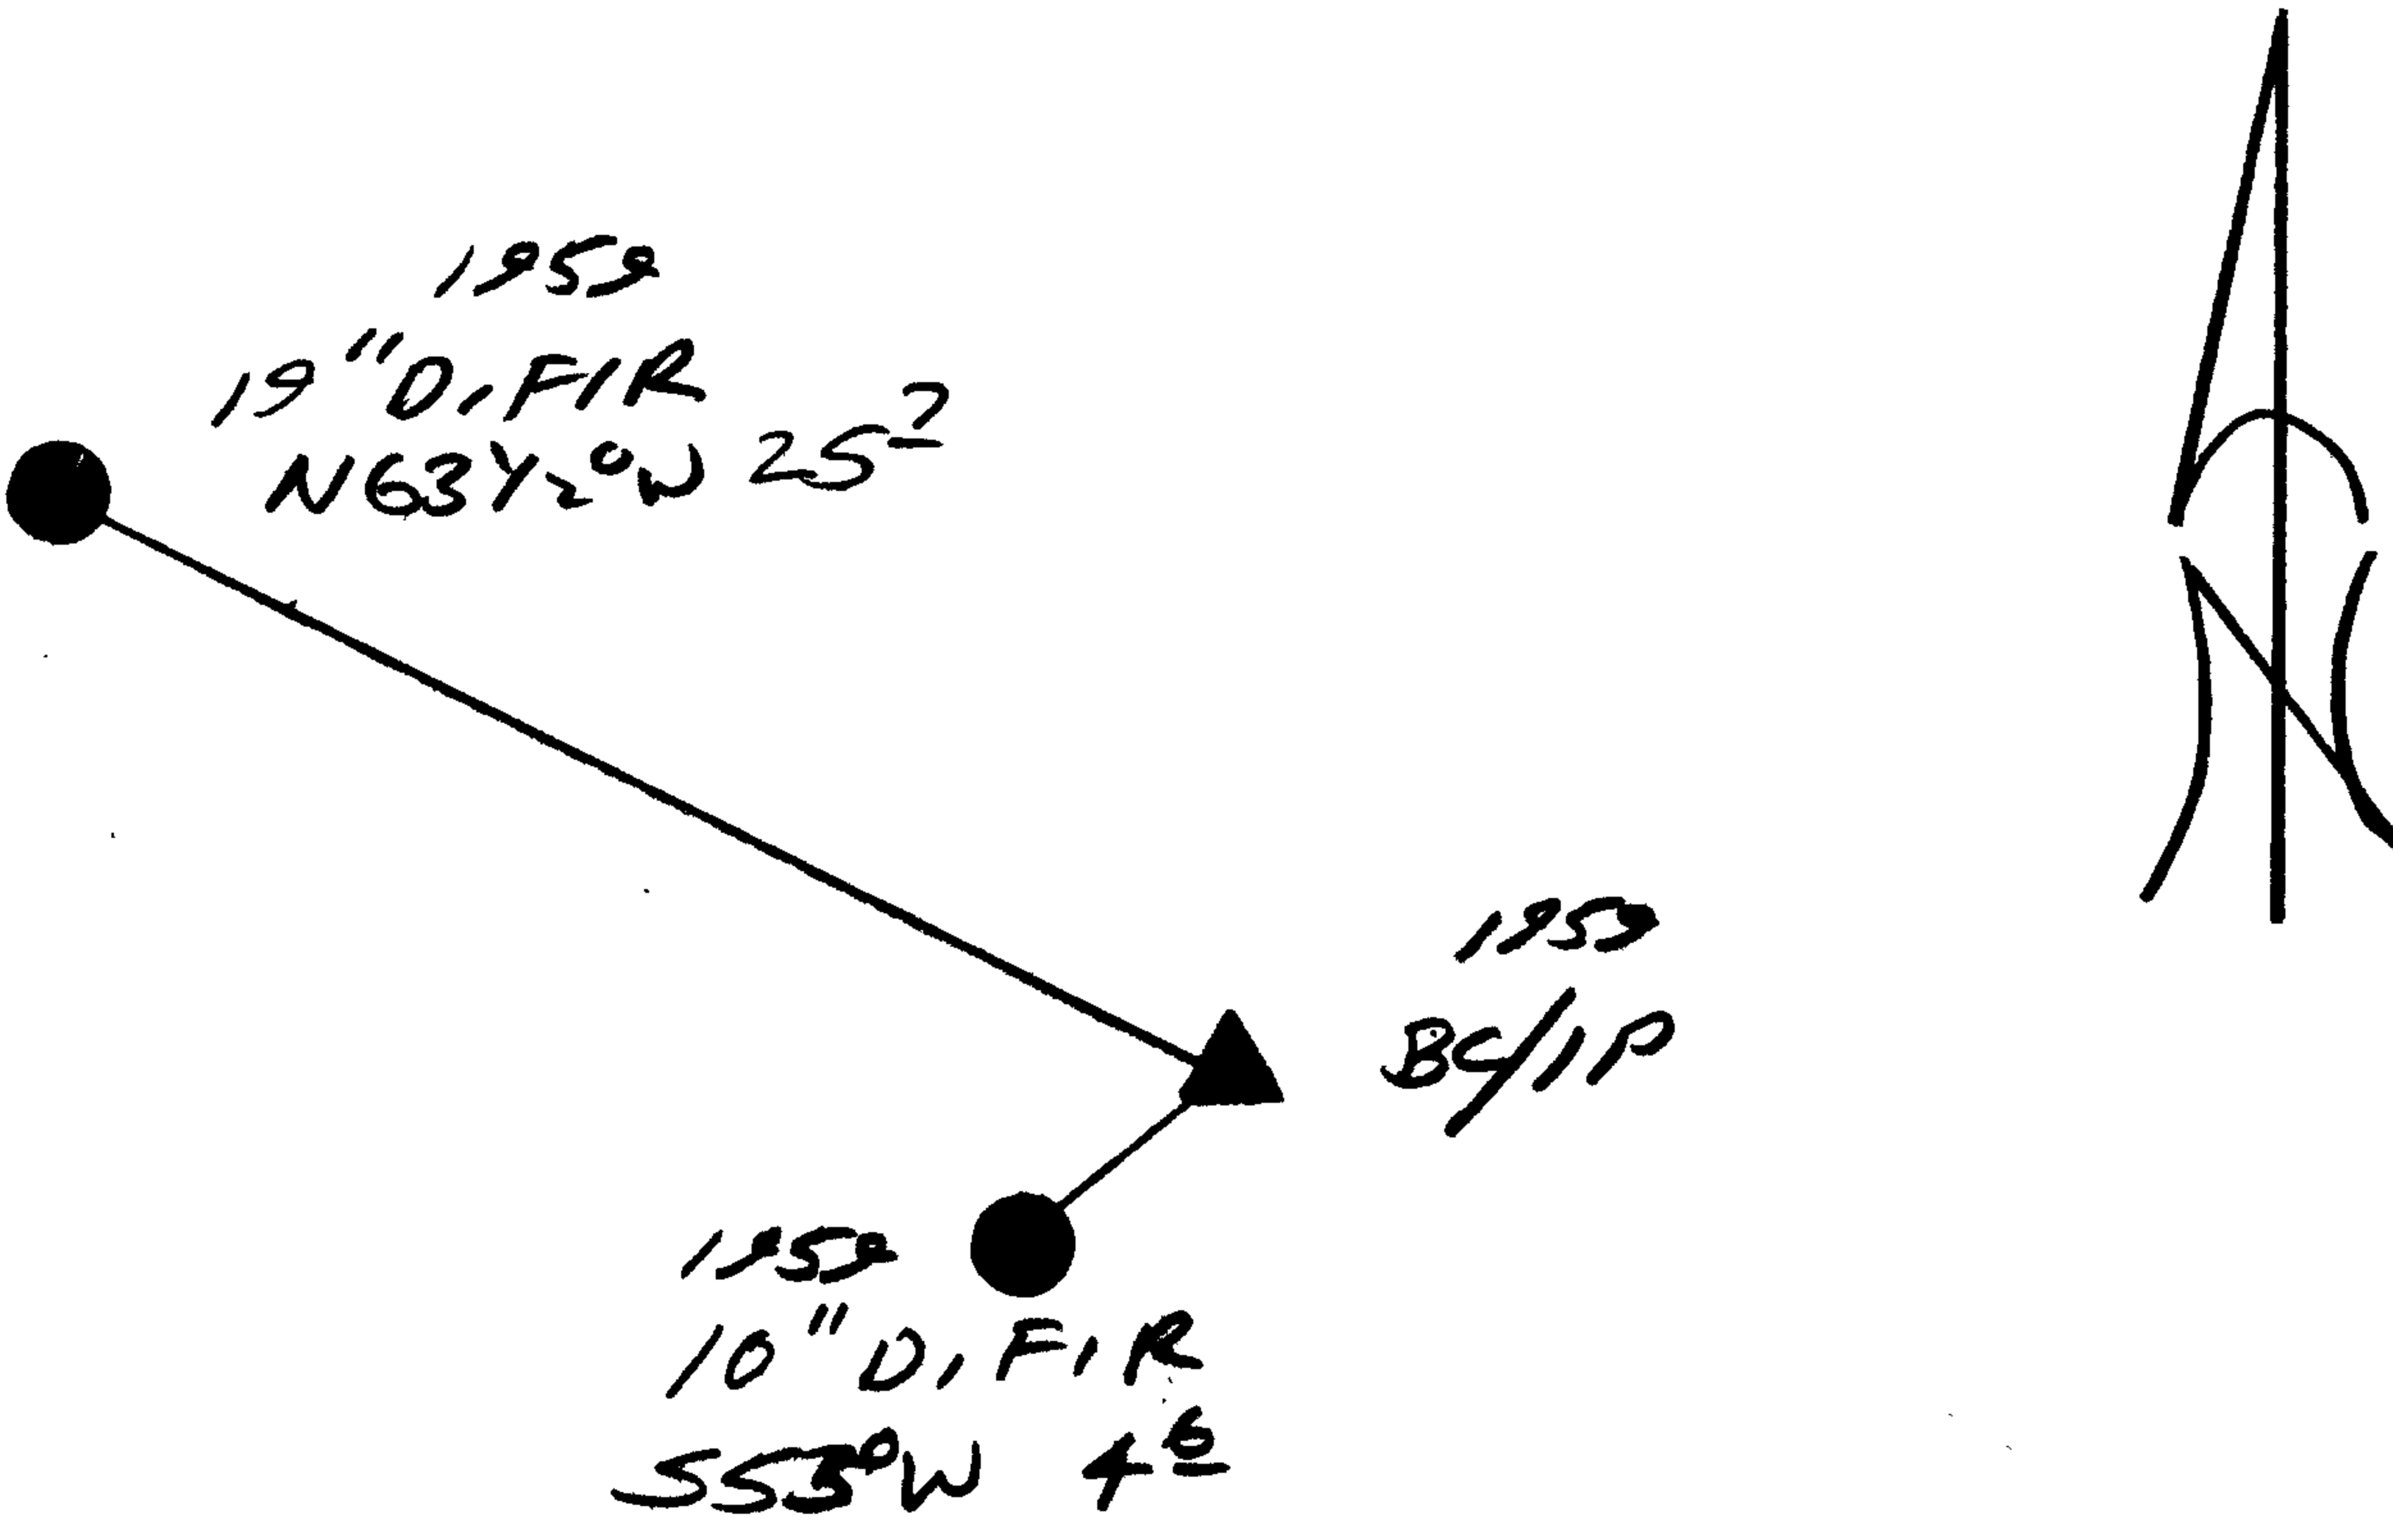

Location & Comments

Comp. Declin. 17 3/4° E  
 Agency DCSO  
 Party Chief RANDALL W. SMITH  
 Notekeeper [Signature]  
 Witnesses STEPHEN J. FLANSK

Address

Surveyor's Seal

REGISTERED  
 PROFESSIONAL  
 LAND SURVEYOR

*[Signature]*  
 6-30-99

OREGON  
 JULY 25, 1980  
 RANDALL W. SMITH  
 2469