

GOVERNMENT CORNER RESTORATION FORM

Township 32S Range 4W Sec. 11

Date: 6-2-1998 By: JC  
County DOUGLAS This survey consists of:

State OR Date 5-27-98 No. \_\_\_\_\_

Map: \_\_\_\_\_  
Narrative: \_\_\_\_\_  
Corner Rpt: 166/2-40

Corner Designation

511

Condition Report Only  
Not Found  
 Renewed  
Unrecorded  
Surveyed In  
Referenced Out

MONUMENT DETAIL

Previous Renewals 1959 BLM

Monument(s) Found: (Condition and Source)

3 1/4" DIA BRASS CAP ON A 2 1/2" O.D. IRON PIPE IS FOUND 1" BELOW GROUND

BC/IP LEANS APPROX. 12" NORTHERLY OF PLUMB.

U.S. DEPT. OF THE INTERIOR  
T32S R4W

S3

511

1959

BUREAU OF LAND MANAGEMENT

Accessories Found:

36" NOW 37" DIA 4 1/2 FT HIGH D.FIR STUMP WITH A FULLY HEALED SINGLE BLAZE BEARS S153/4E, 40.3 FT (AGREES WITH REC.) 1959

STUMP IS SOLID

RENEWAL

Monument Set (Procedure and Description)

Monument Detail

FOUND BCIIP RETURNED TO PLUMB POSITION, NOW PROTRUDES 4" ABOVE GROUND.

N/A

New Accessories

5" DIA D. FIR DOUBLE BLAZED AND SCRIBED "X CS BT" BEARS S29Y2°E, 15.4 FT

DOUBLE TRUNKED D. FIR DOUBLE BLAZED AND SCRIBED "X CS BT" ON 5" DIA WESTERLY TRUNK, ROOT CROWN BEARS S81°W 2.5 FT


Sketch of Monument, Accessories, and General Area

Location & Comments

GRAVEL ROAD

STEEL CUT BANK

CORNER LIES 6 FT SOUTH OF THE TOP OF STEEL ROAD CUT BANK ON A STEEP NORTH SLOPE

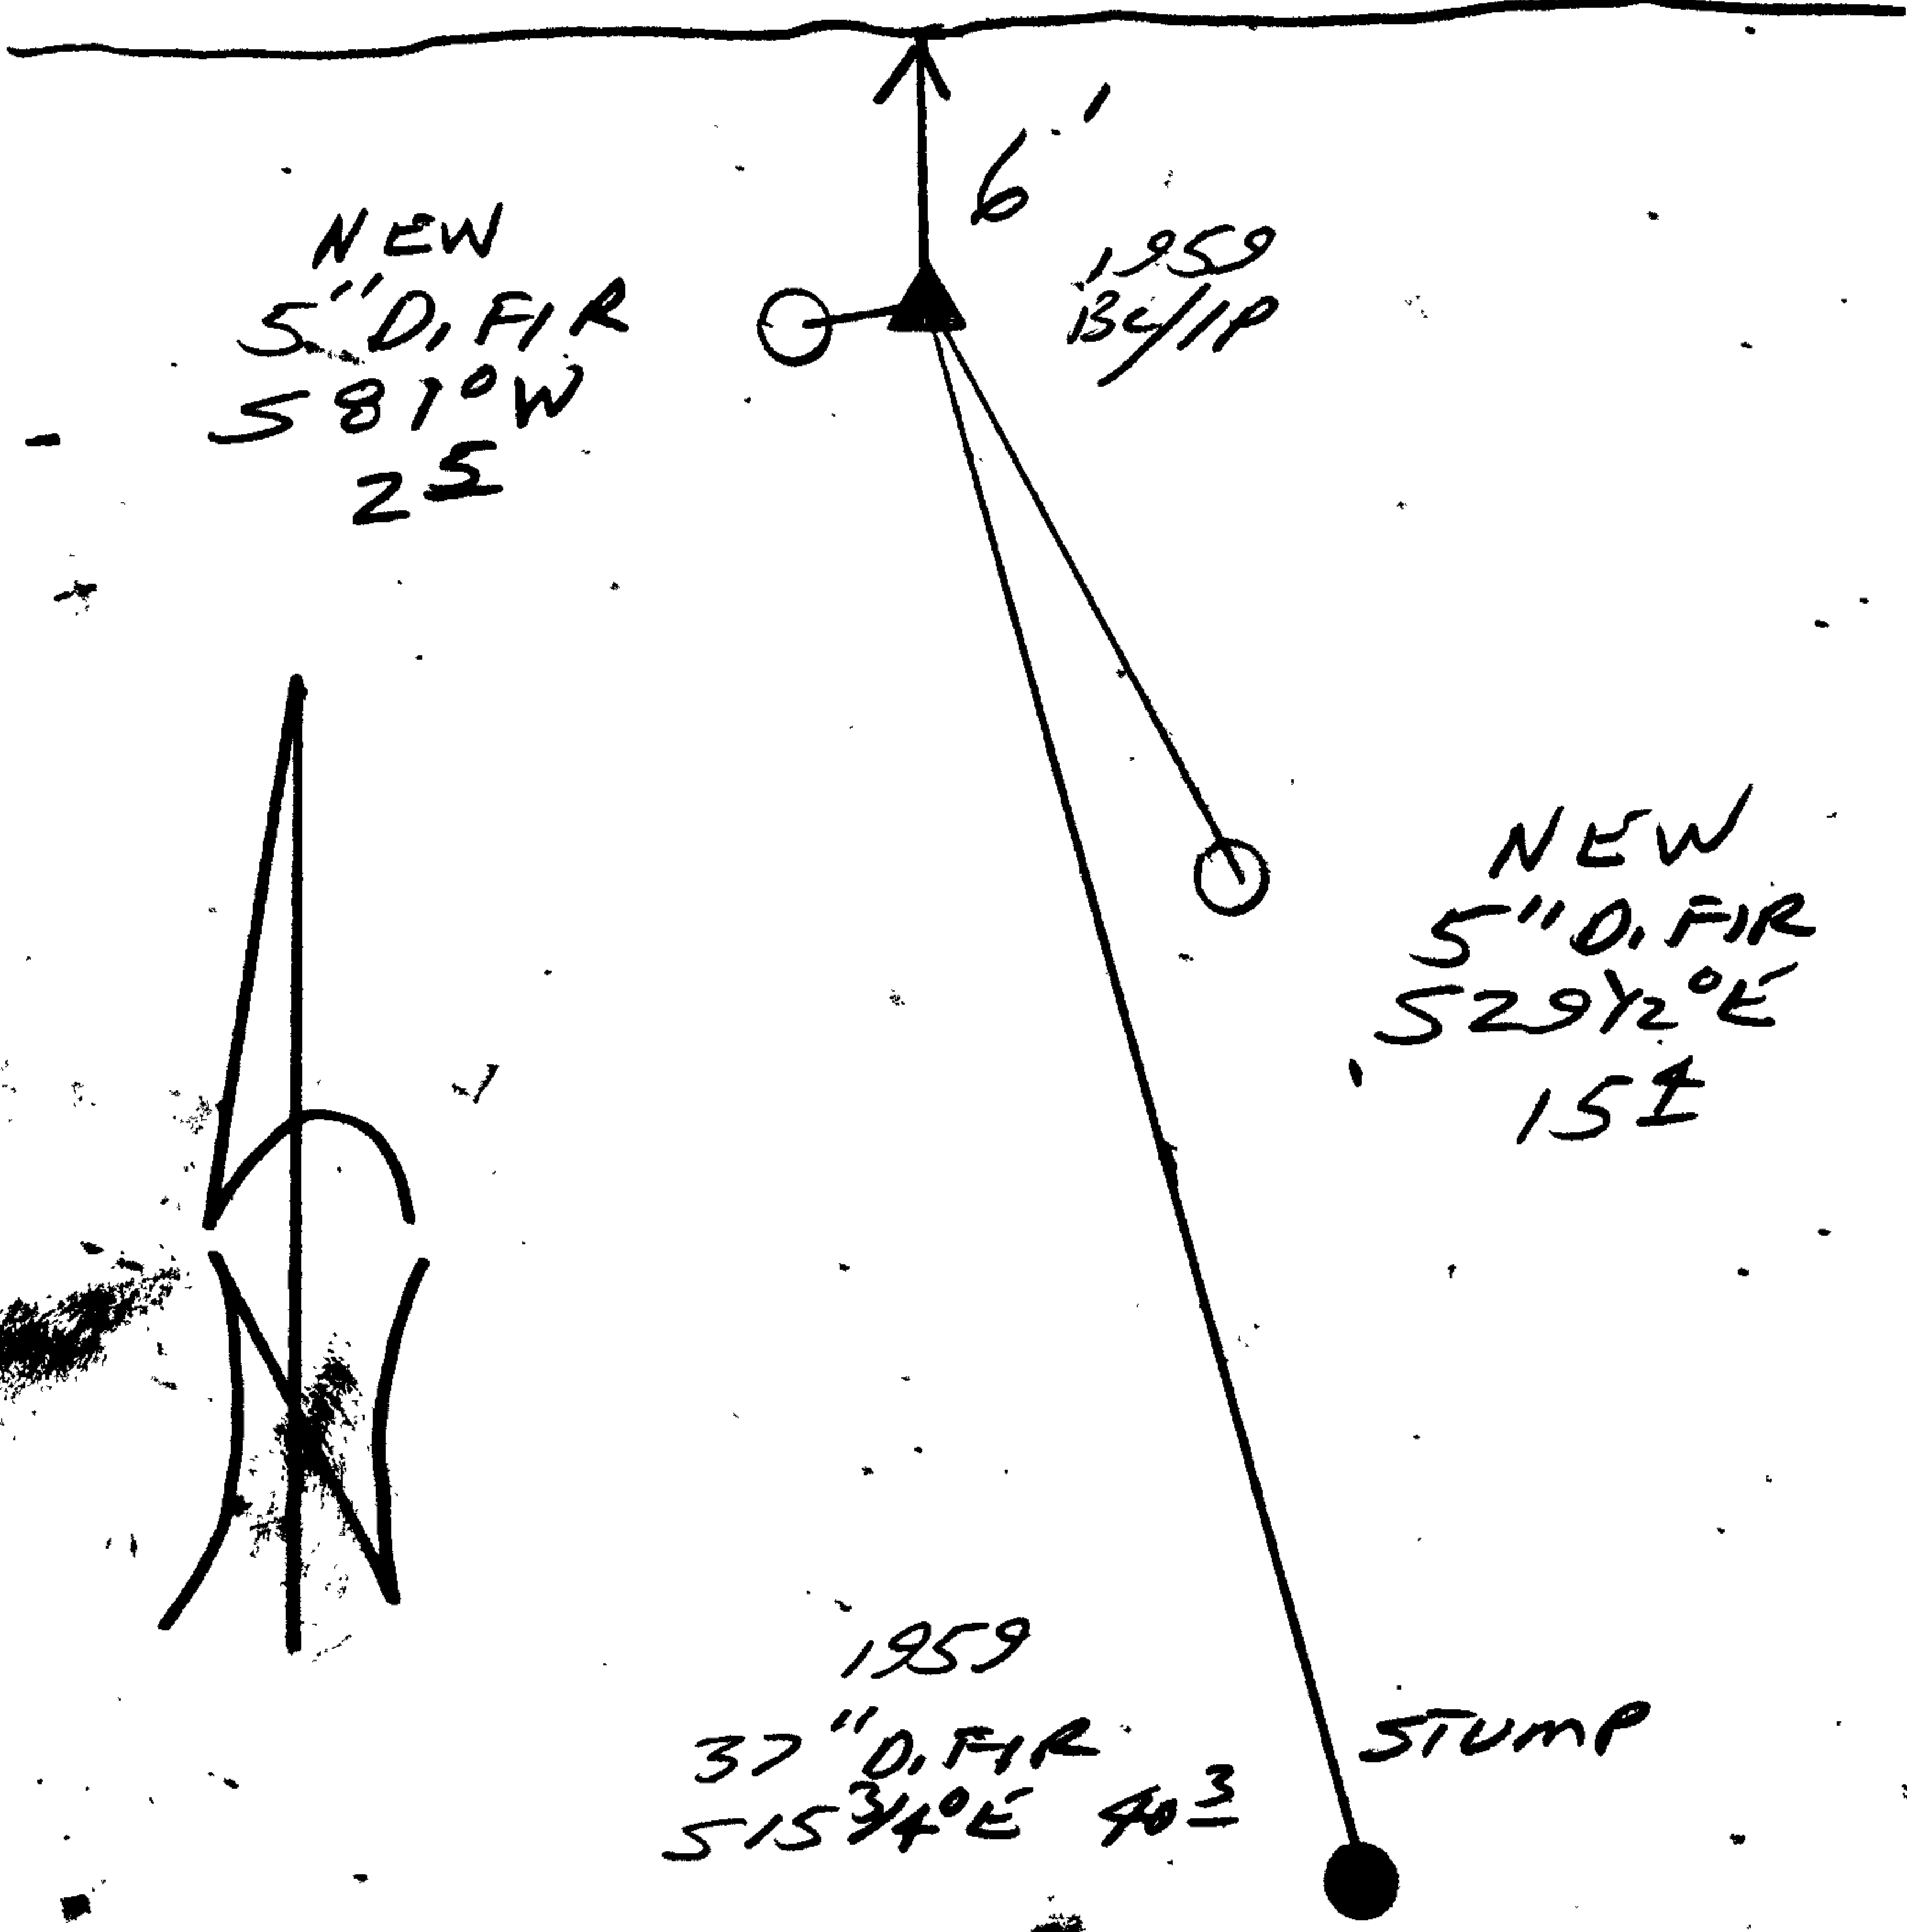

Comp. Declin. 17 3/4° E  
Agency DC50  
Party Chief RANDALL W. SMITH  
Notekeeper  
Witnesses STEPHEN J. FLAKE

Address

Surveyor's Seal

REGISTERED PROFESSIONAL LAND SURVEYOR

Expires 6-30-99

OREGON JULY 25, 1890 RANDALL W. SMITH 2469