

GOVERNMENT CORNER RESTORATION FORM

Date: 6-2-1998 By: J

Township 28S Range 7W Sec. 32 County DOUGLAS

This survey consists of:

State OK Date 5-28-98 No. \_\_\_\_\_

Map: \_\_\_\_\_

Narrative: \_\_\_\_\_

Corner Rpt: 66/2-41

Corner Designation

S 32

AP

DOUGLAS COUNTY  
 Condition:  Repair Only  
 Not Found  
 Renewed  
 Unrecorded  
 Surveyed In  
 Referenced Out

Previous Renewals 1924 GLO 1961 DCSC

MONUMENT DETAIL

Monument(s) Found: (Condition and Source)

2 1/2" DIA BRASS CAP ON A 1"  
O.D. IRON PIPE PROTRUDES  
6" ABOVE GROUND. 1924

U.S. GENERAL LAND

AP

1924

OFFICE SURVEY

Accessories Found:

12" NOW ROTTED MAPLE FOUND AT RECORD BEARING  
"S44°E 27.7 FT" NOTE SMALLER MAPLES ARE  
GROWING FROM THIS OBT

6" NOW BADLY ROTTED W. FIRE STUMP WITH AXE MARK  
NO SCRIBING VISIBLE, NEAR RECORD "N55°12'W, 42.6 FT"  
1961

20" NOW 22" DIA MYRTLE WITH A FULLY HEALED DOUBLE  
BLAZE, BEARS N63°12'E, 40.0 FT (AGREES  
WITH REC.) 1961

36" NOW 32" DIA SET HILL O. FIRE STUMP WITH  
A FULLY HEALED SINGLE BLAZE, BEARS  
S96°W 47.5 FT (AGREES WITH REC. DISTANCE  
15 TO BLAZE.) 1924

U.S. File No. 66/2-41

RENEWAL

Monument Set (Procedure and Description)

Monument Detail

NONE


N/A

New Accessories

12" DIA MAPLE DOUBLE BLAZED AND SCRIBED "APS32CSBT"  
BEARS S44°E, 66.1 FT.

6" DIA MAPLE DOUBLE BLAZED AND SCRIBED "APS32CSBT"  
BEARS N32 1/2°W, 71.2 FT

Sketch of Monument, Accessories, and General Area

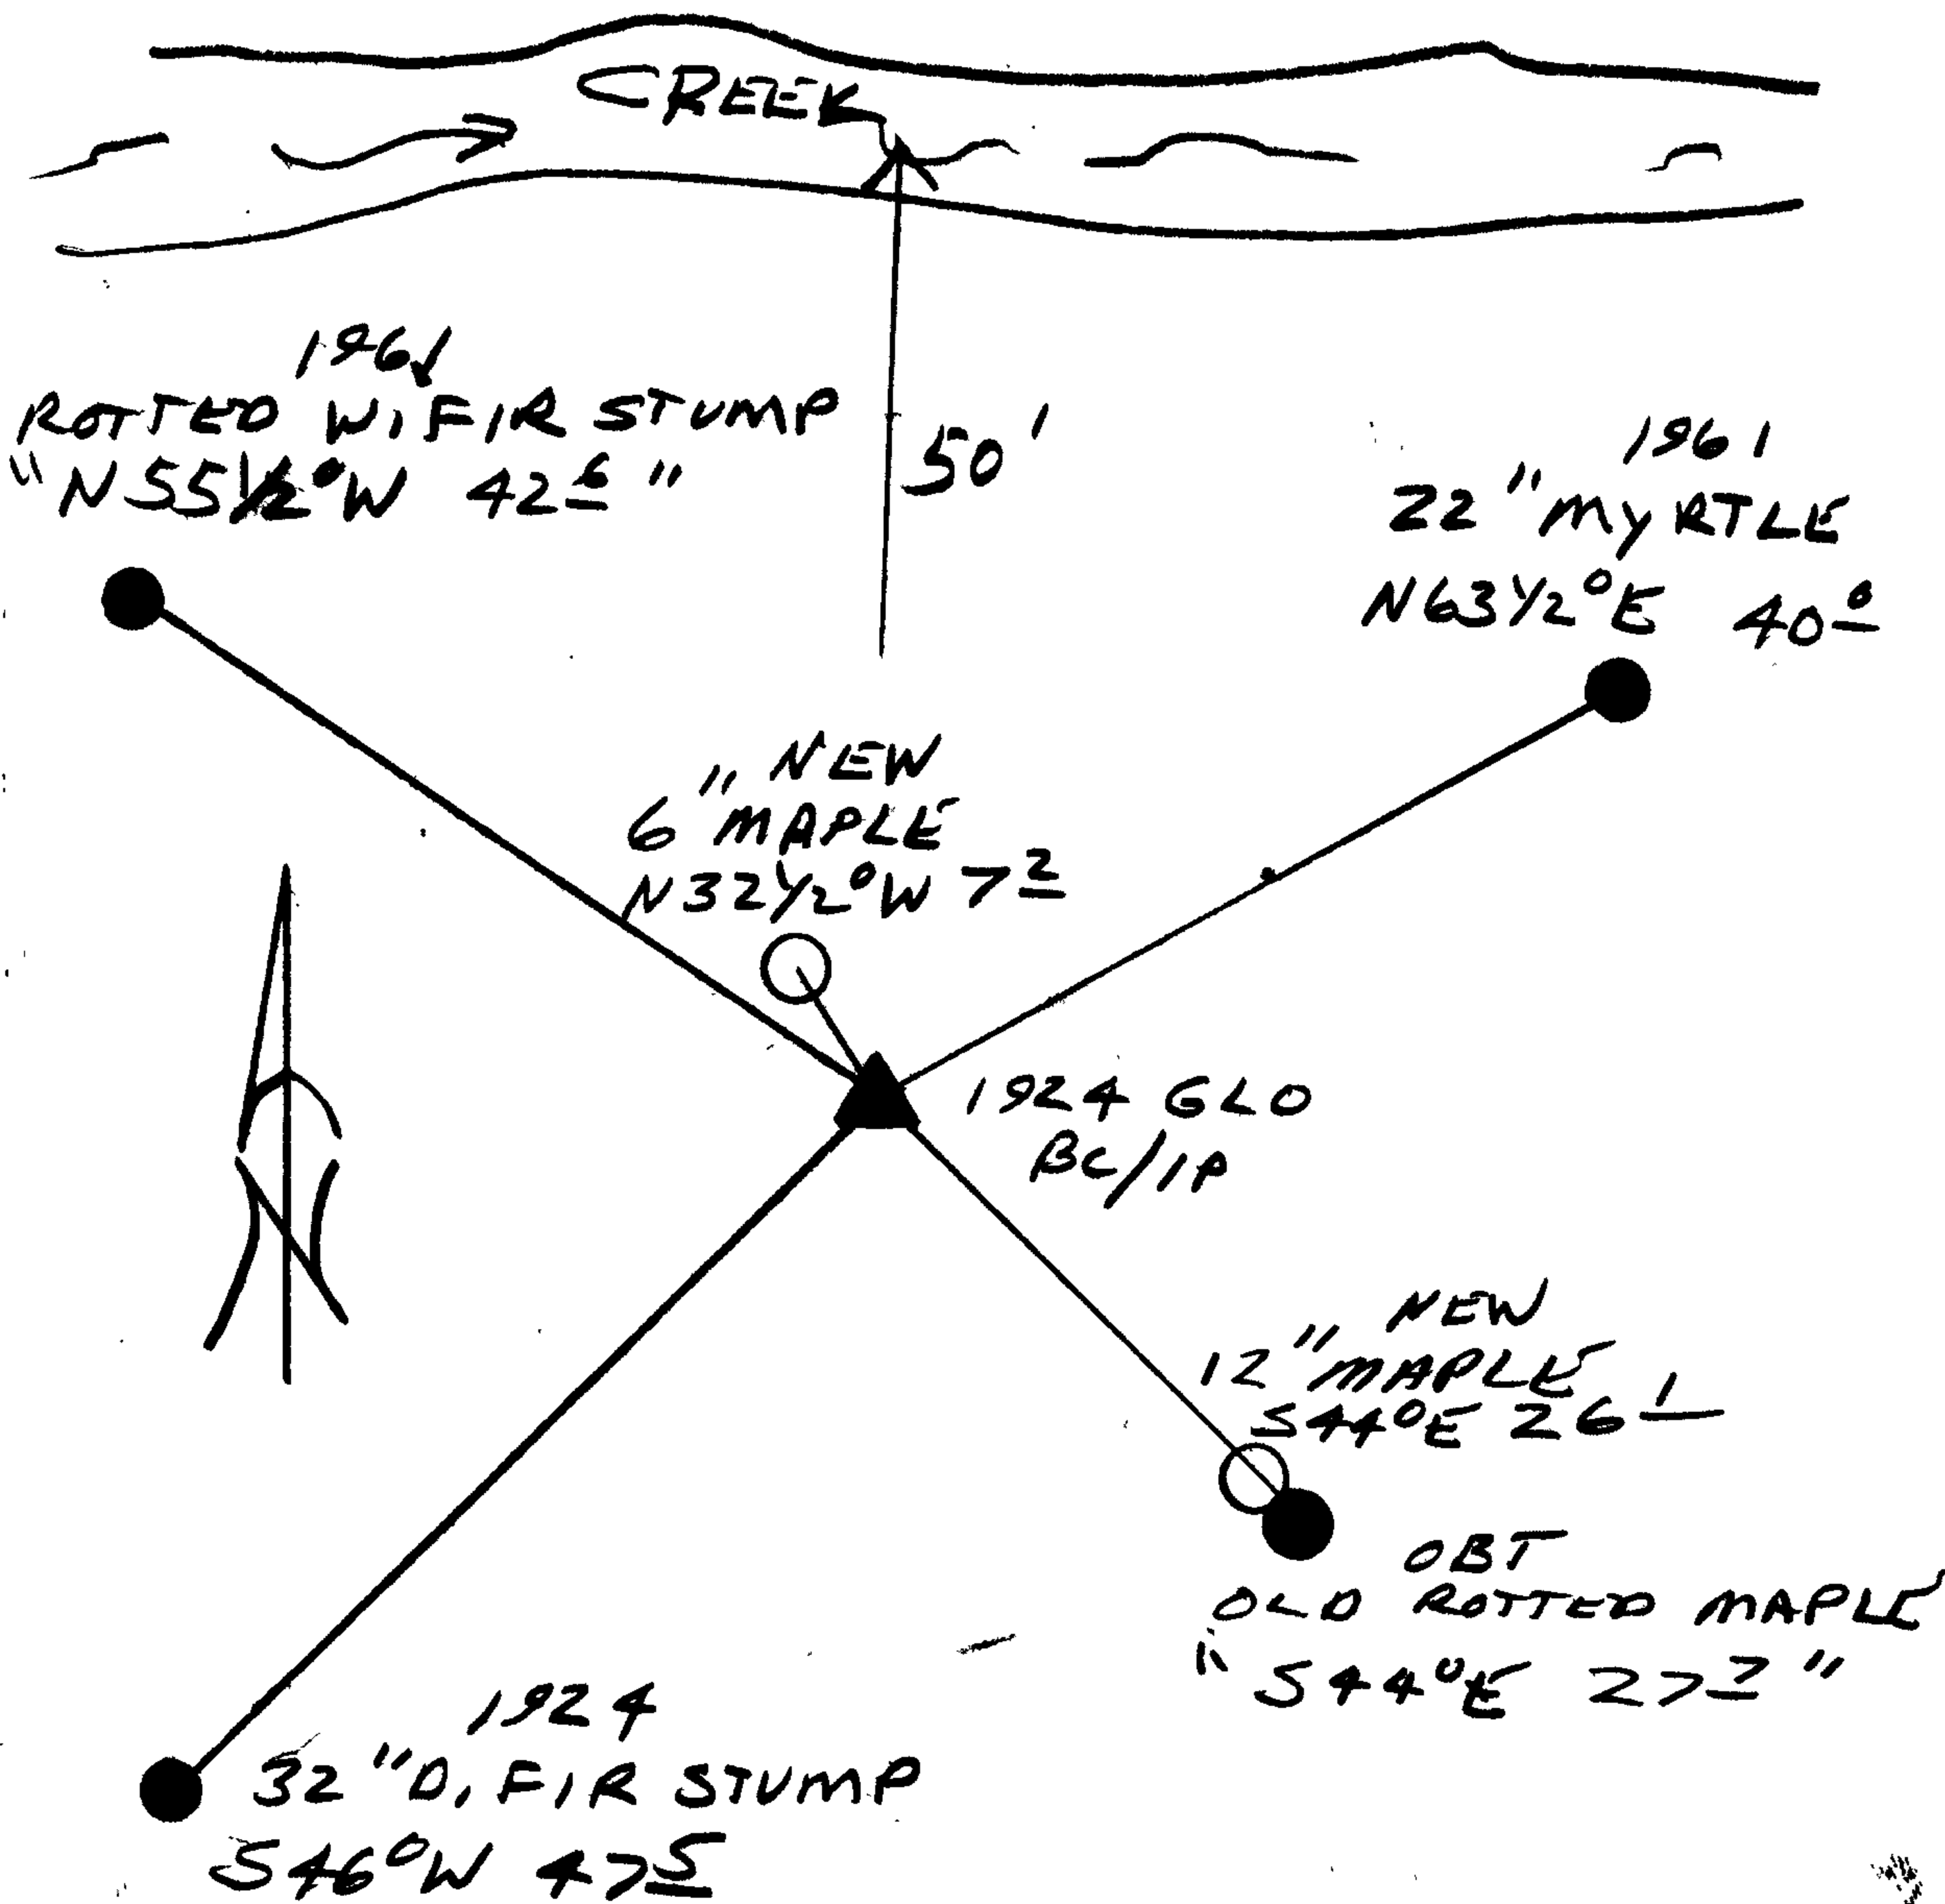

Location & Comments

CORNER LIES APPROX.  
50 FT SOUTH OF  
ACREEK ON A STEEP  
NORTH SLOPE

Comp. Declin. 17 3/4°E  
Agency DCS  
Party Chief RANDALL W. SMITH  
Notekeeper [Signature]  
Witnesses [Signature]

Address

Surveyor's Seal

REGISTERED  
PROFESSIONAL  
LAND SURVEYOR

[Signature]  
EXPIRES 6-30-98

OREGON  
JULY 25, 1990  
RANDALL W. SMITH  
2469