

RENEWAL

Monument Set (Procedure and Description)

Monument Detail

NONE

N/A

New Accessories


8" DIA LODGE POLE PINE DOUBLE BLAZED AND SCRIBED
"Y4S33 CS BT" BEARS S34°E, 13.4 FT

7" DIA LODGE POLE PINE DOUBLE BLAZED AND SCRIBED
"Y4S33 CS BT" BEARS N71°E, 30.4 FT

4" DIA LODGE POLE PINE DOUBLE BLAZED AND SCRIBED "X BT"
BEARS N50°W, 19.1 FT

Sketch of Monument, Accessories, and General Area

Location & Comments

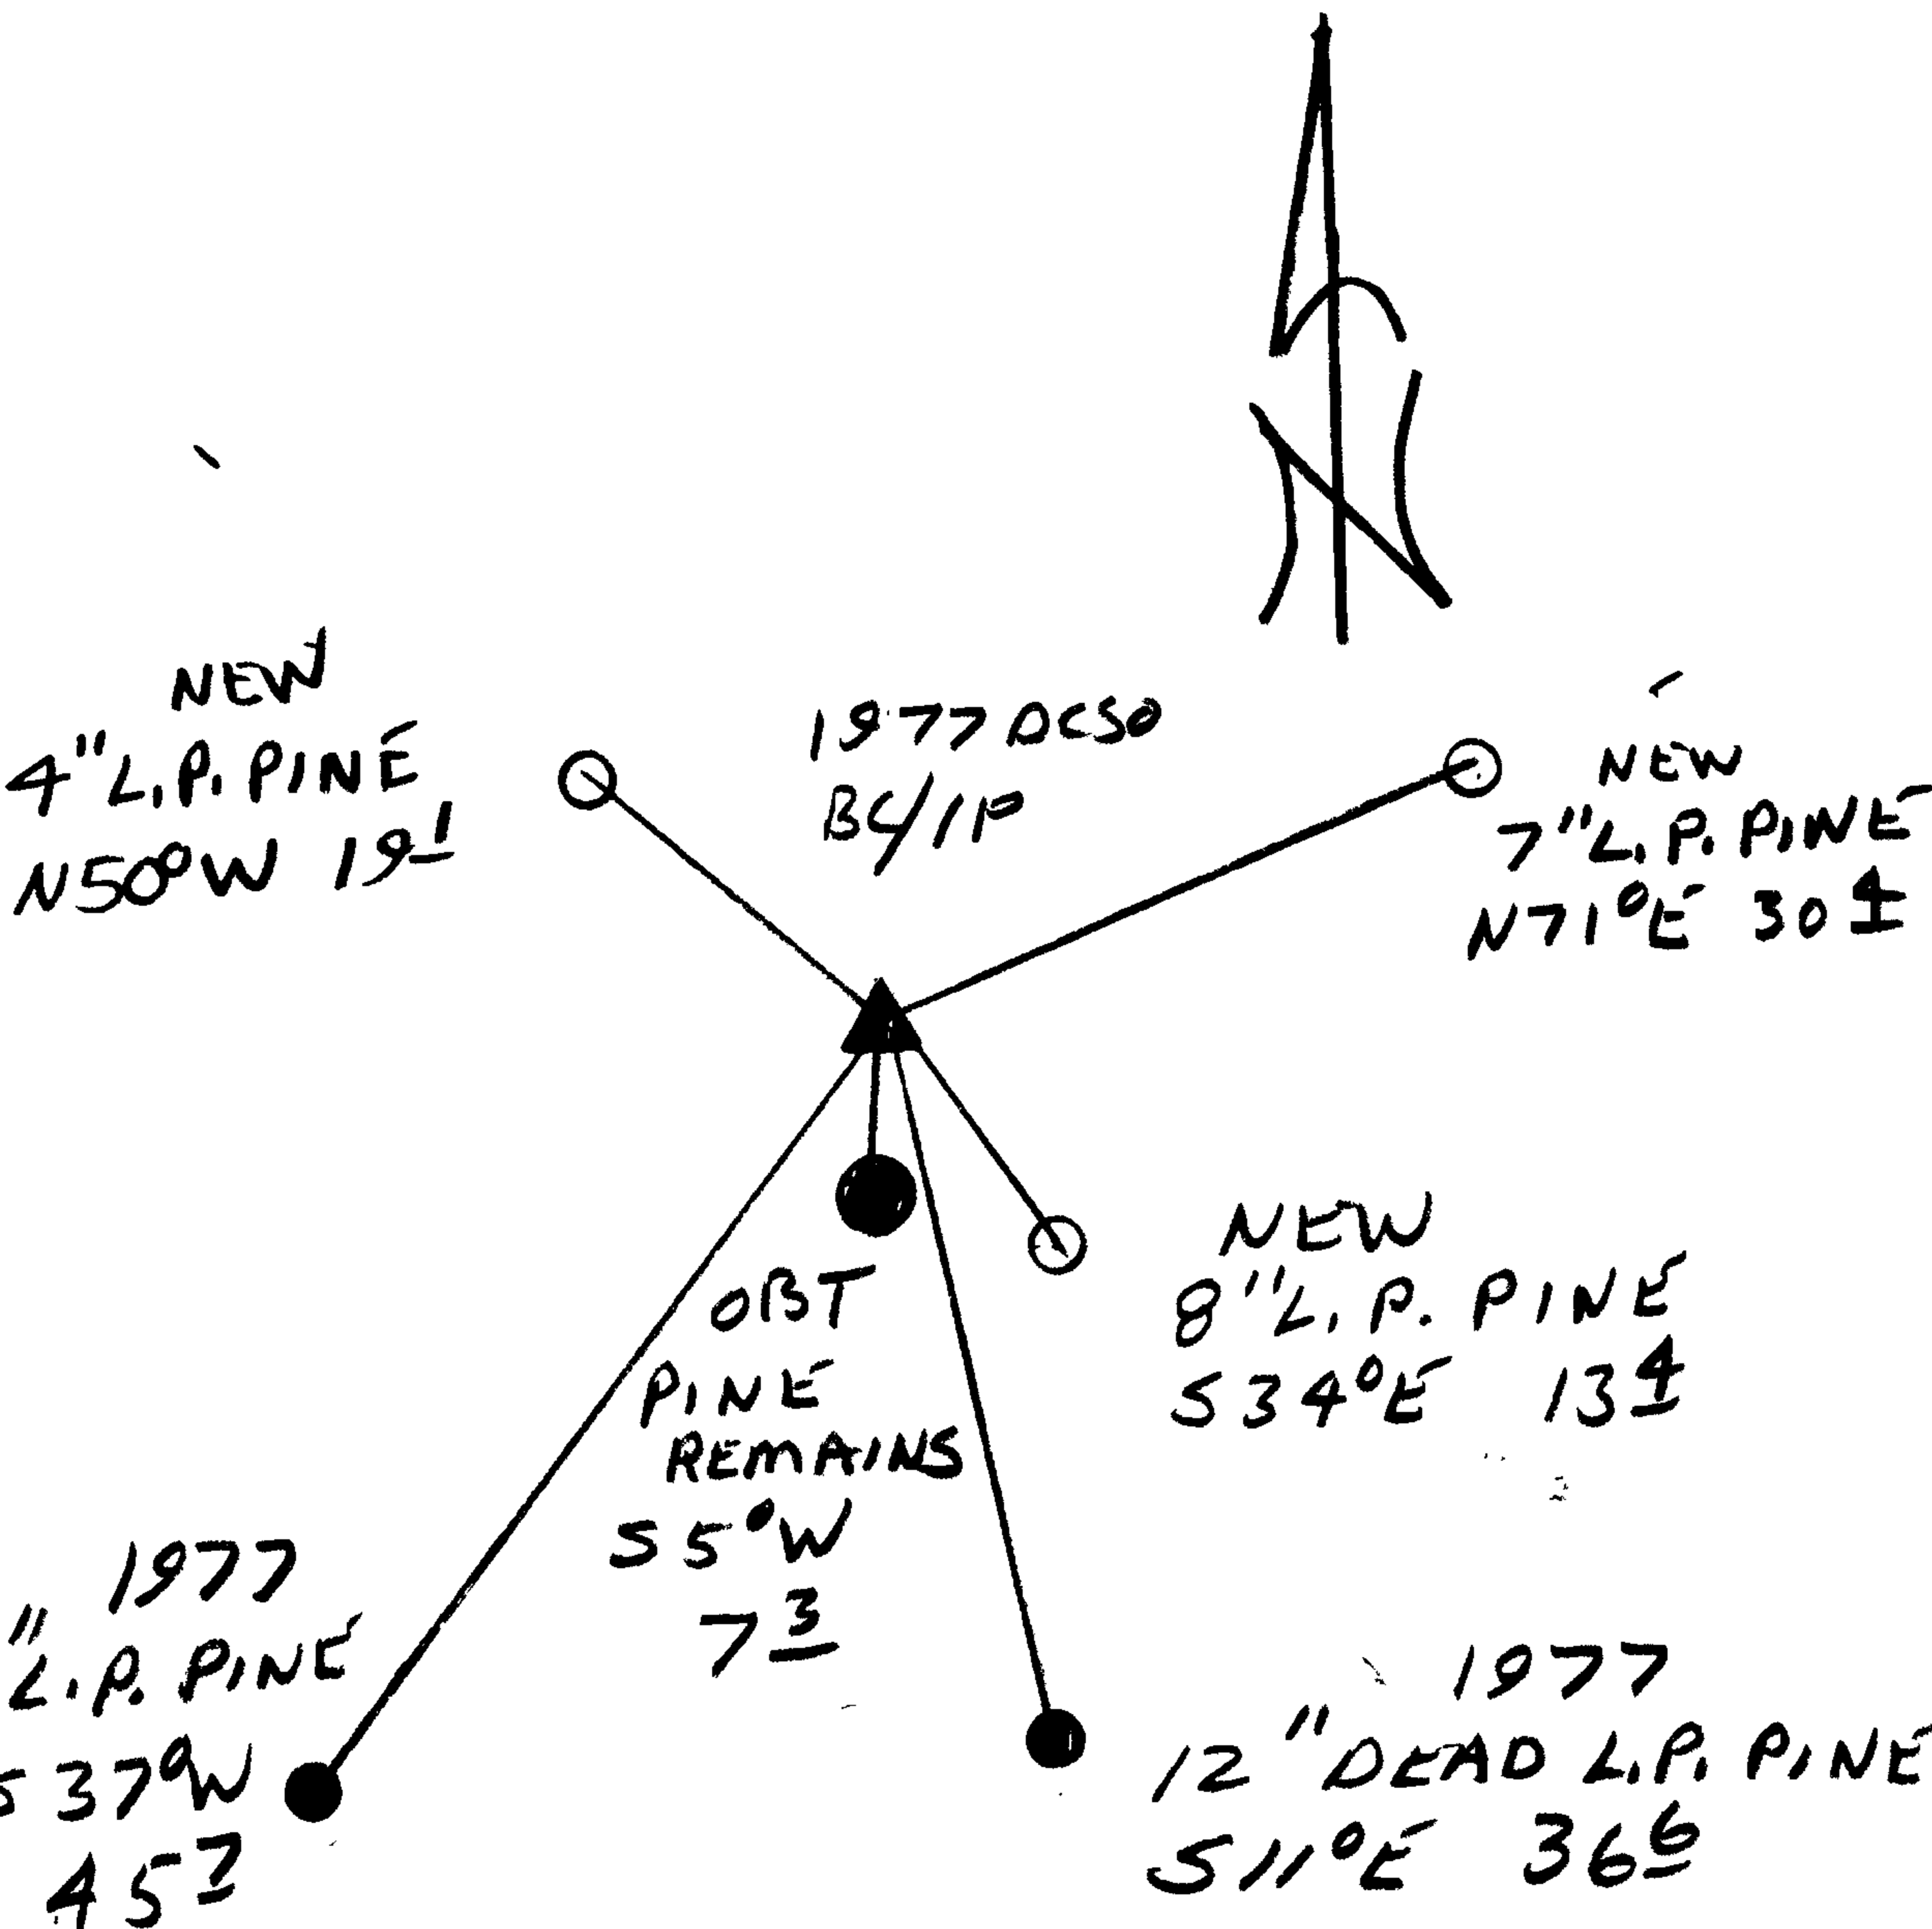

Comp. Declin. 17 3/4° E
 Agency DCSO
 Party Chief RANDALL W. SMITH
 Notekeeper RANDALL W. SMITH
 Witnesses STEPHEN J. FLAUS

Address

Surveyor's Seal

REGISTERED
 PROFESSIONAL
 LAND SURVEYOR

Randall W. Smith

EXPIRES 6-30-2000

OREGON
 JULY 25, 1990
 RANDALL W. SMITH
 2499