

GOVERNMENT CORNER RESTORATION FORM

Date: 11-5-1998 By: JC

This survey consists of:

Township 30S Range 4W Sec. 15 County DOUGLAS Map: _____

State OK Date 11-29-98 No. _____ Narrative: _____

Corner Rpt: 66/4-9

Corner Designation WC

1/4 S16 | S15

DOUGLAS COUNTY SURVEYOR

- Condition Report Only
- Not Found
- Renewed
- Unrecorded
- Surveyed In
- Referenced Out

MONUMENT DETAIL

Previous Renewals 1889 GLO, 1940 + 1963 DCSO

Monument(s) Found: (Condition and Source)

2 1/2" DIA BRASS CAP ON A 1 1/2" O.D. IRON PIPE PROTRUDING 20" ABOVE GROUND. (1963)

1" I.D. IRON PIPE PROTRUDING 9" ABOVE GROUND ON NORTH EDGE OF BC/IP. BOTH IP'S WIRED TOGETHER. (SOURCE UNKNOWN)

COUNTY SURVEYORS OFFICE

T 30 S

W C

1/4 S16 | S15

R
4
W

1963

Accessories Found:

NO EVIDENCE OF BT'S FOUND.

RENEWAL

Monument Detail

Monument Set (Procedure and Description)


IRON PIPES ARE SURROUNDED BY
 A MOUND OF STONE. BRASS
 CAP PROTRUDES 10" ABOVE
 MOUND.

- 5" DIA ASH DOUBLE BLAZED AND
 SCRIBED "X BT"
 BEARS S36 1/2° W, 20.1 FT

New Accessories

- MULTI TRUNKED ASH BLAZED AND SCRIBED "WC 1/4 S15CS BT"
 ON 6" DIA SOUTHERLY TRUNK CENTER OF SOUTHERLY TRUNK
 BEARS S76° E, 8.4 FT
- MULTI TRUNKED MAPLE BLAZED AND SCRIBED "WC 1/4 S15CS BT"
 ON 10" DIA NORTHERLY TRUNK, CENTER OF ROOT CROWN
 BEARS S8° E, 26.7 FT
- 3" DIA. W. OAK DOUBLE BLAZED AND SCRIBED "XBT" BEARS N39° E, 12.1 FT

Sketch of Monument, Accessories, and General Area

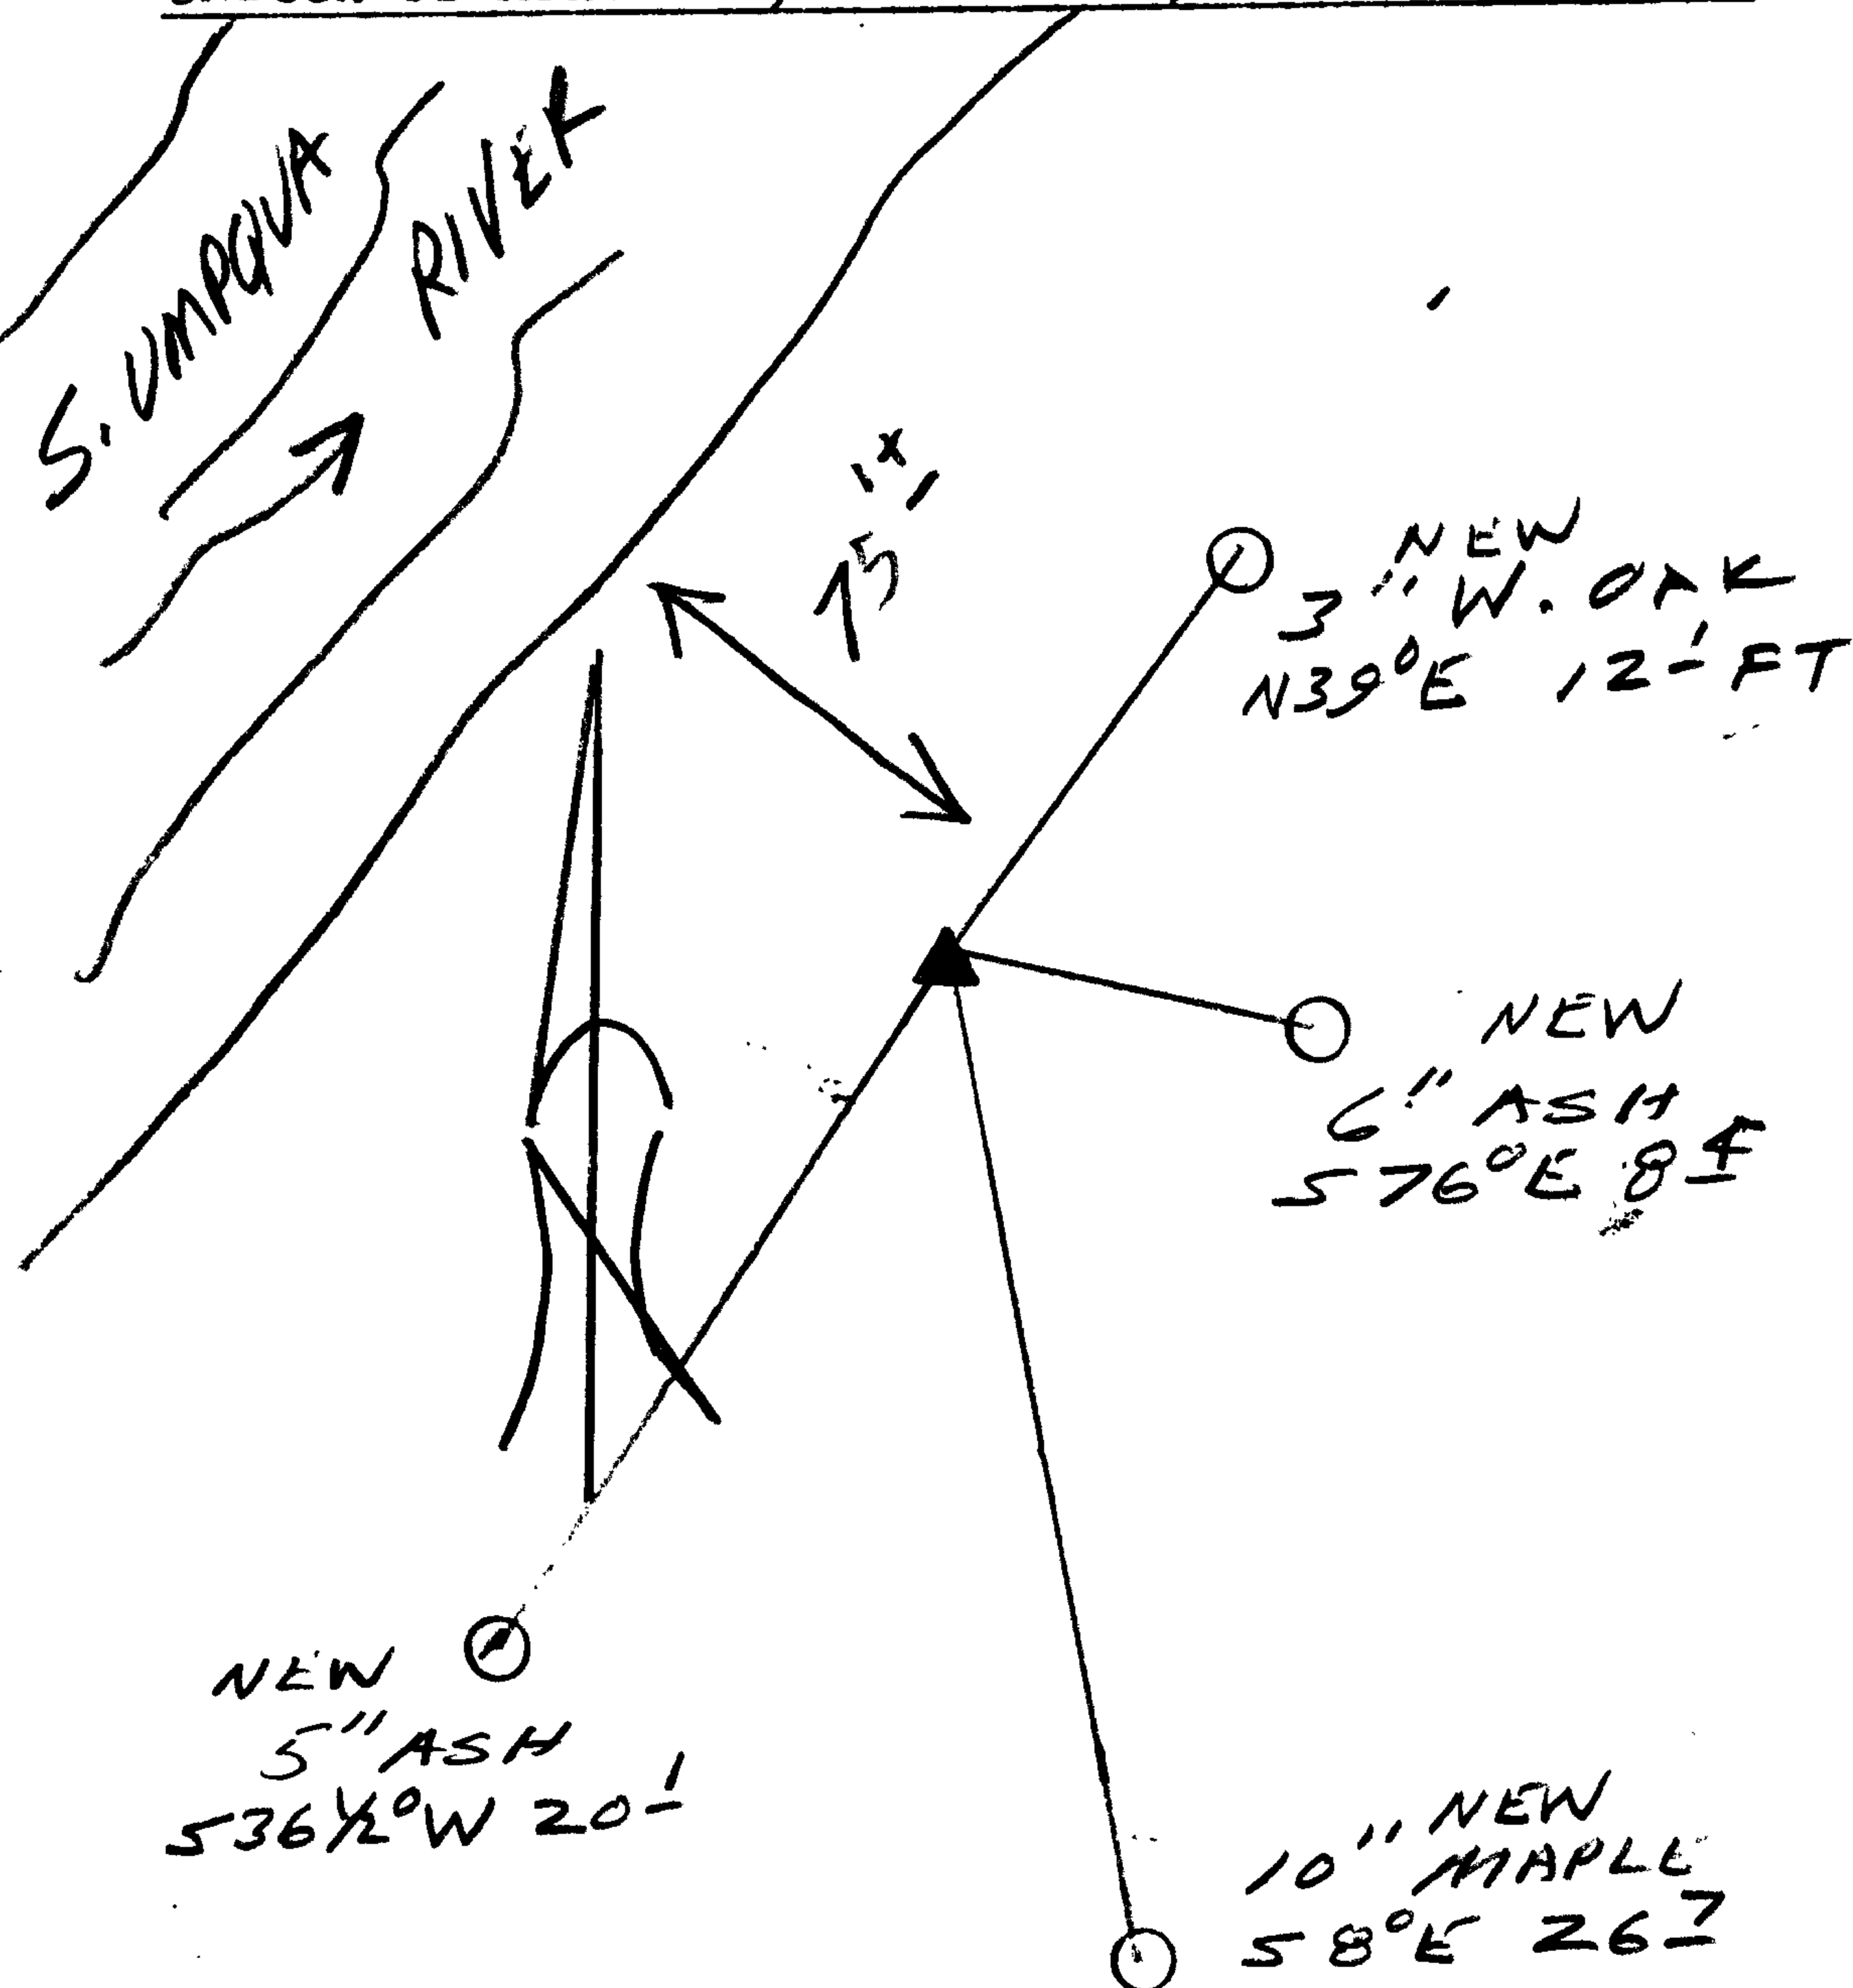

Location & Comments

Comp. Declin. 17 3/4° E
 Agency UCSO
 Party Chief RANDALL W. SMITH
 Notekeeper J. W. L. W. W.
 Witnesses STEPHAN J. FLAISE

Address _____

Surveyor's Seal

REGISTERED
 PROFESSIONAL
 LAND SURVEYOR

Randall W. Smith
 BEARS 6-30-2000

OREGON
 JULY 25, 1990
 RANDALL W. SMITH
 2489