

RENEWAL

Monument Set (Procedure and Description)

Monument Detail

NONE


N/A

New Accessories

10" B. OAK DOUBLE BLAZED AND SCRIBED "NW DLC 53
CS BT BEARS N 59° W 23.2 FT

11" DIA. MADRONE DOUBLE BLAZED AND SCRIBED "NW DLC 53
CS BT BEARS S 18 1/2° W 15.7 FT

Sketch of Monument, Accessories, and General Area

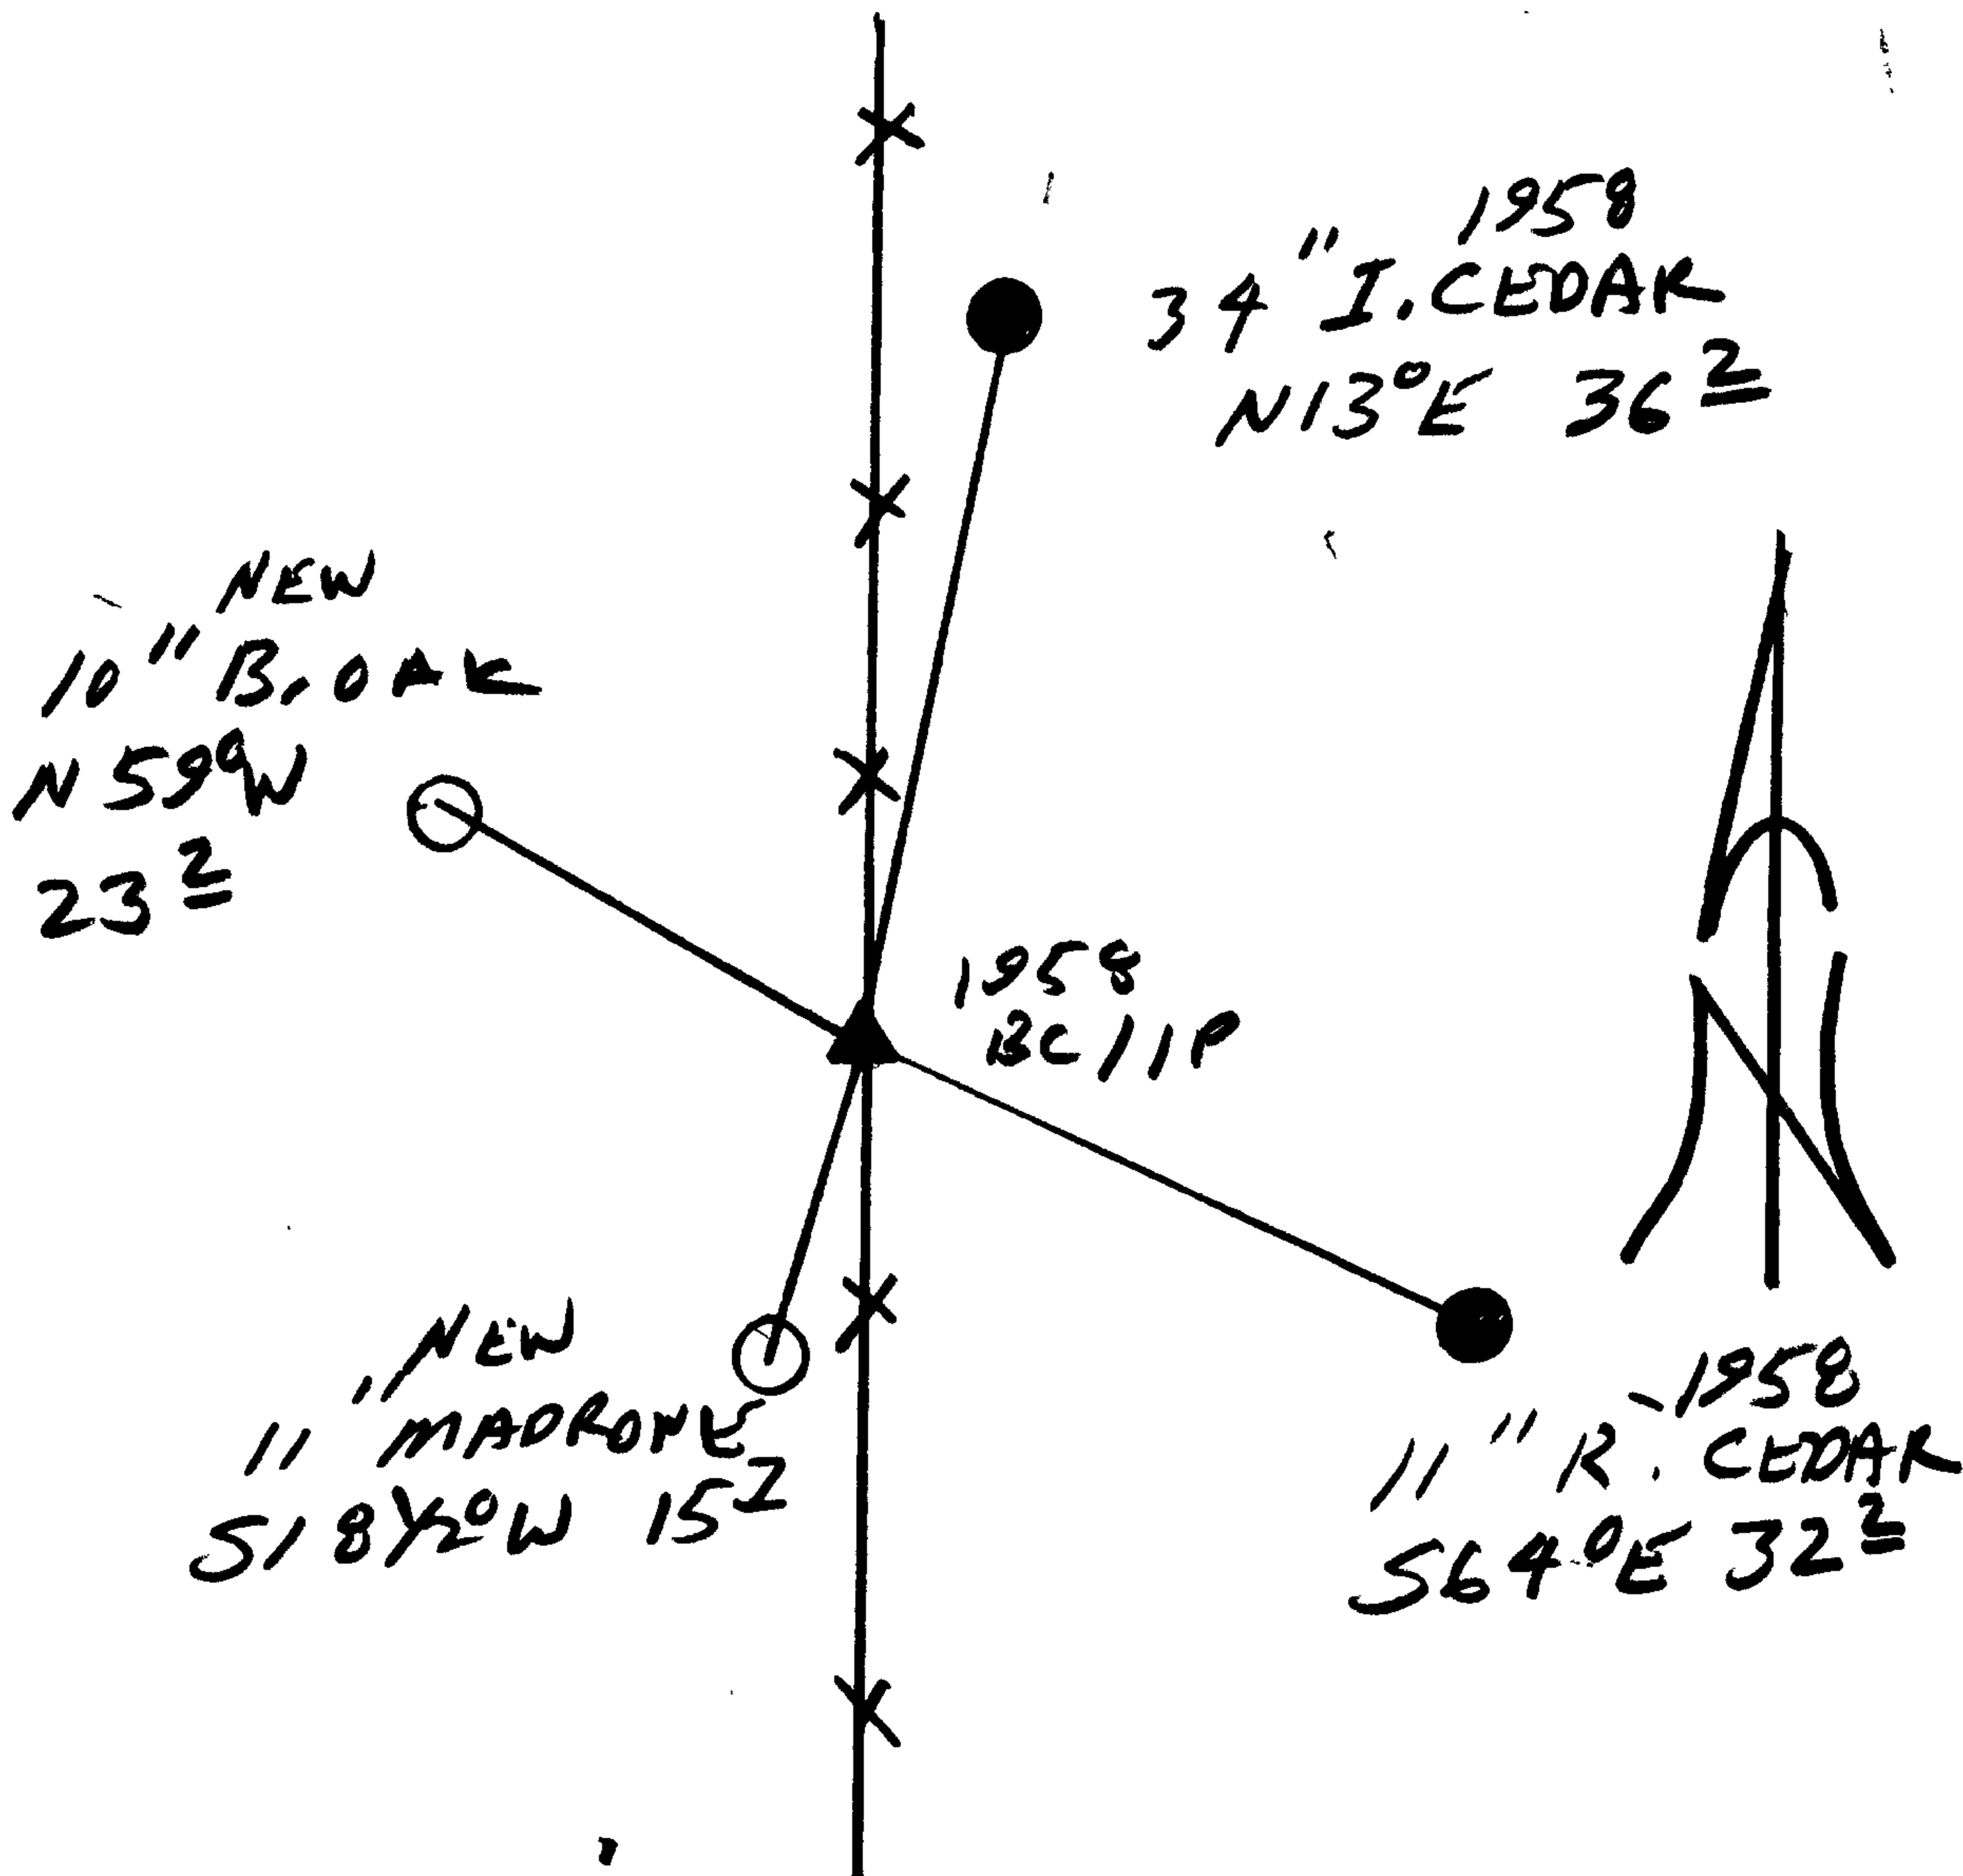

Location & Comments

COR. LINES IN N-S
FENCE LINE

Comp. Declin. 17 3/4° E
Agency DCSO
Party Chief RANDALL W. SMITH
Notekeeper [Signature]
Witnesses STEPHEN FRAUSE

Address

Surveyor's Seal

REGISTERED
PROFESSIONAL
LAND SURVEYOR

[Signature]
EXPIRES 6-30-2001

OREGON
JULY 25, 1980
RANDALL W. SMITH
2409