

GOVERNMENT CORNER RESTORATION FORM

Date: 4-23-1999 By: SC

This survey consists of:

Township 27S Range 7W Sec. 29

County DOUGLAS Map: \_\_\_\_\_

State OR

Date 1-26-1999

No. 200240.012 Corner Rpt: 66/8-8

Corner Designation

1/4 S30/S29

DOUGLAS COUNTY SURVEYOR

- \_\_\_\_ Condition Report Only
- \_\_\_\_ Not Found
- Renewed
- \_\_\_\_ Unrecorded
- \_\_\_\_ Surveyed In
- \_\_\_\_ Referenced Out

Previous Renewals 1958 DC50

Monument(s) Found: (Condition and Source)

2 1/2" DIA DC50 BRASS  
CAP ON A 1 1/2" O.D IRON  
PIPE PROTRUDS 12" ABOVE  
GROUND (1958)

COUNTY SURVEYORS  
+ 27S

1/4 S30/S29

R7W

OFFICE

Accessories Found:

- 10" NOW 14" DIA DEAD W/OAK WITH A PREVIOUSLY  
OPENED ROTTED BLAZE, BEARS N50°E, 36.3 FT  
(AGREES WITH REC.) / OBT
- 14" NOW 20" DIA O/E LK WITH A FULLY HEALED  
DOUBLE BLAZE, BEARS N45°E, 64.2 FT / (AGREES  
WITH REC.) / 1958
- 18" NOW 21" DIA B/OAK WITH A FULLY HEALED  
BLAZE, BEARS S32°20'E, 33.4 FT / (AGREES  
WITH REC.) / 1958

CV

RENEWAL

Monument Set (Procedure and Description)

NONE

Monument Detail


N/A

New Accessories

9" DIA D. FIR DOUBLE BLAZED AND SCRIBED "Y4530 CS BT"  
BEARS N 40° W, 6.0 FT

5" DIA MADRONE BARK SCRIBED "Y4530 CS BT"  
BEARS S 39° W, 25.1 FT

Sketch of Monument, Accessories, and General Area

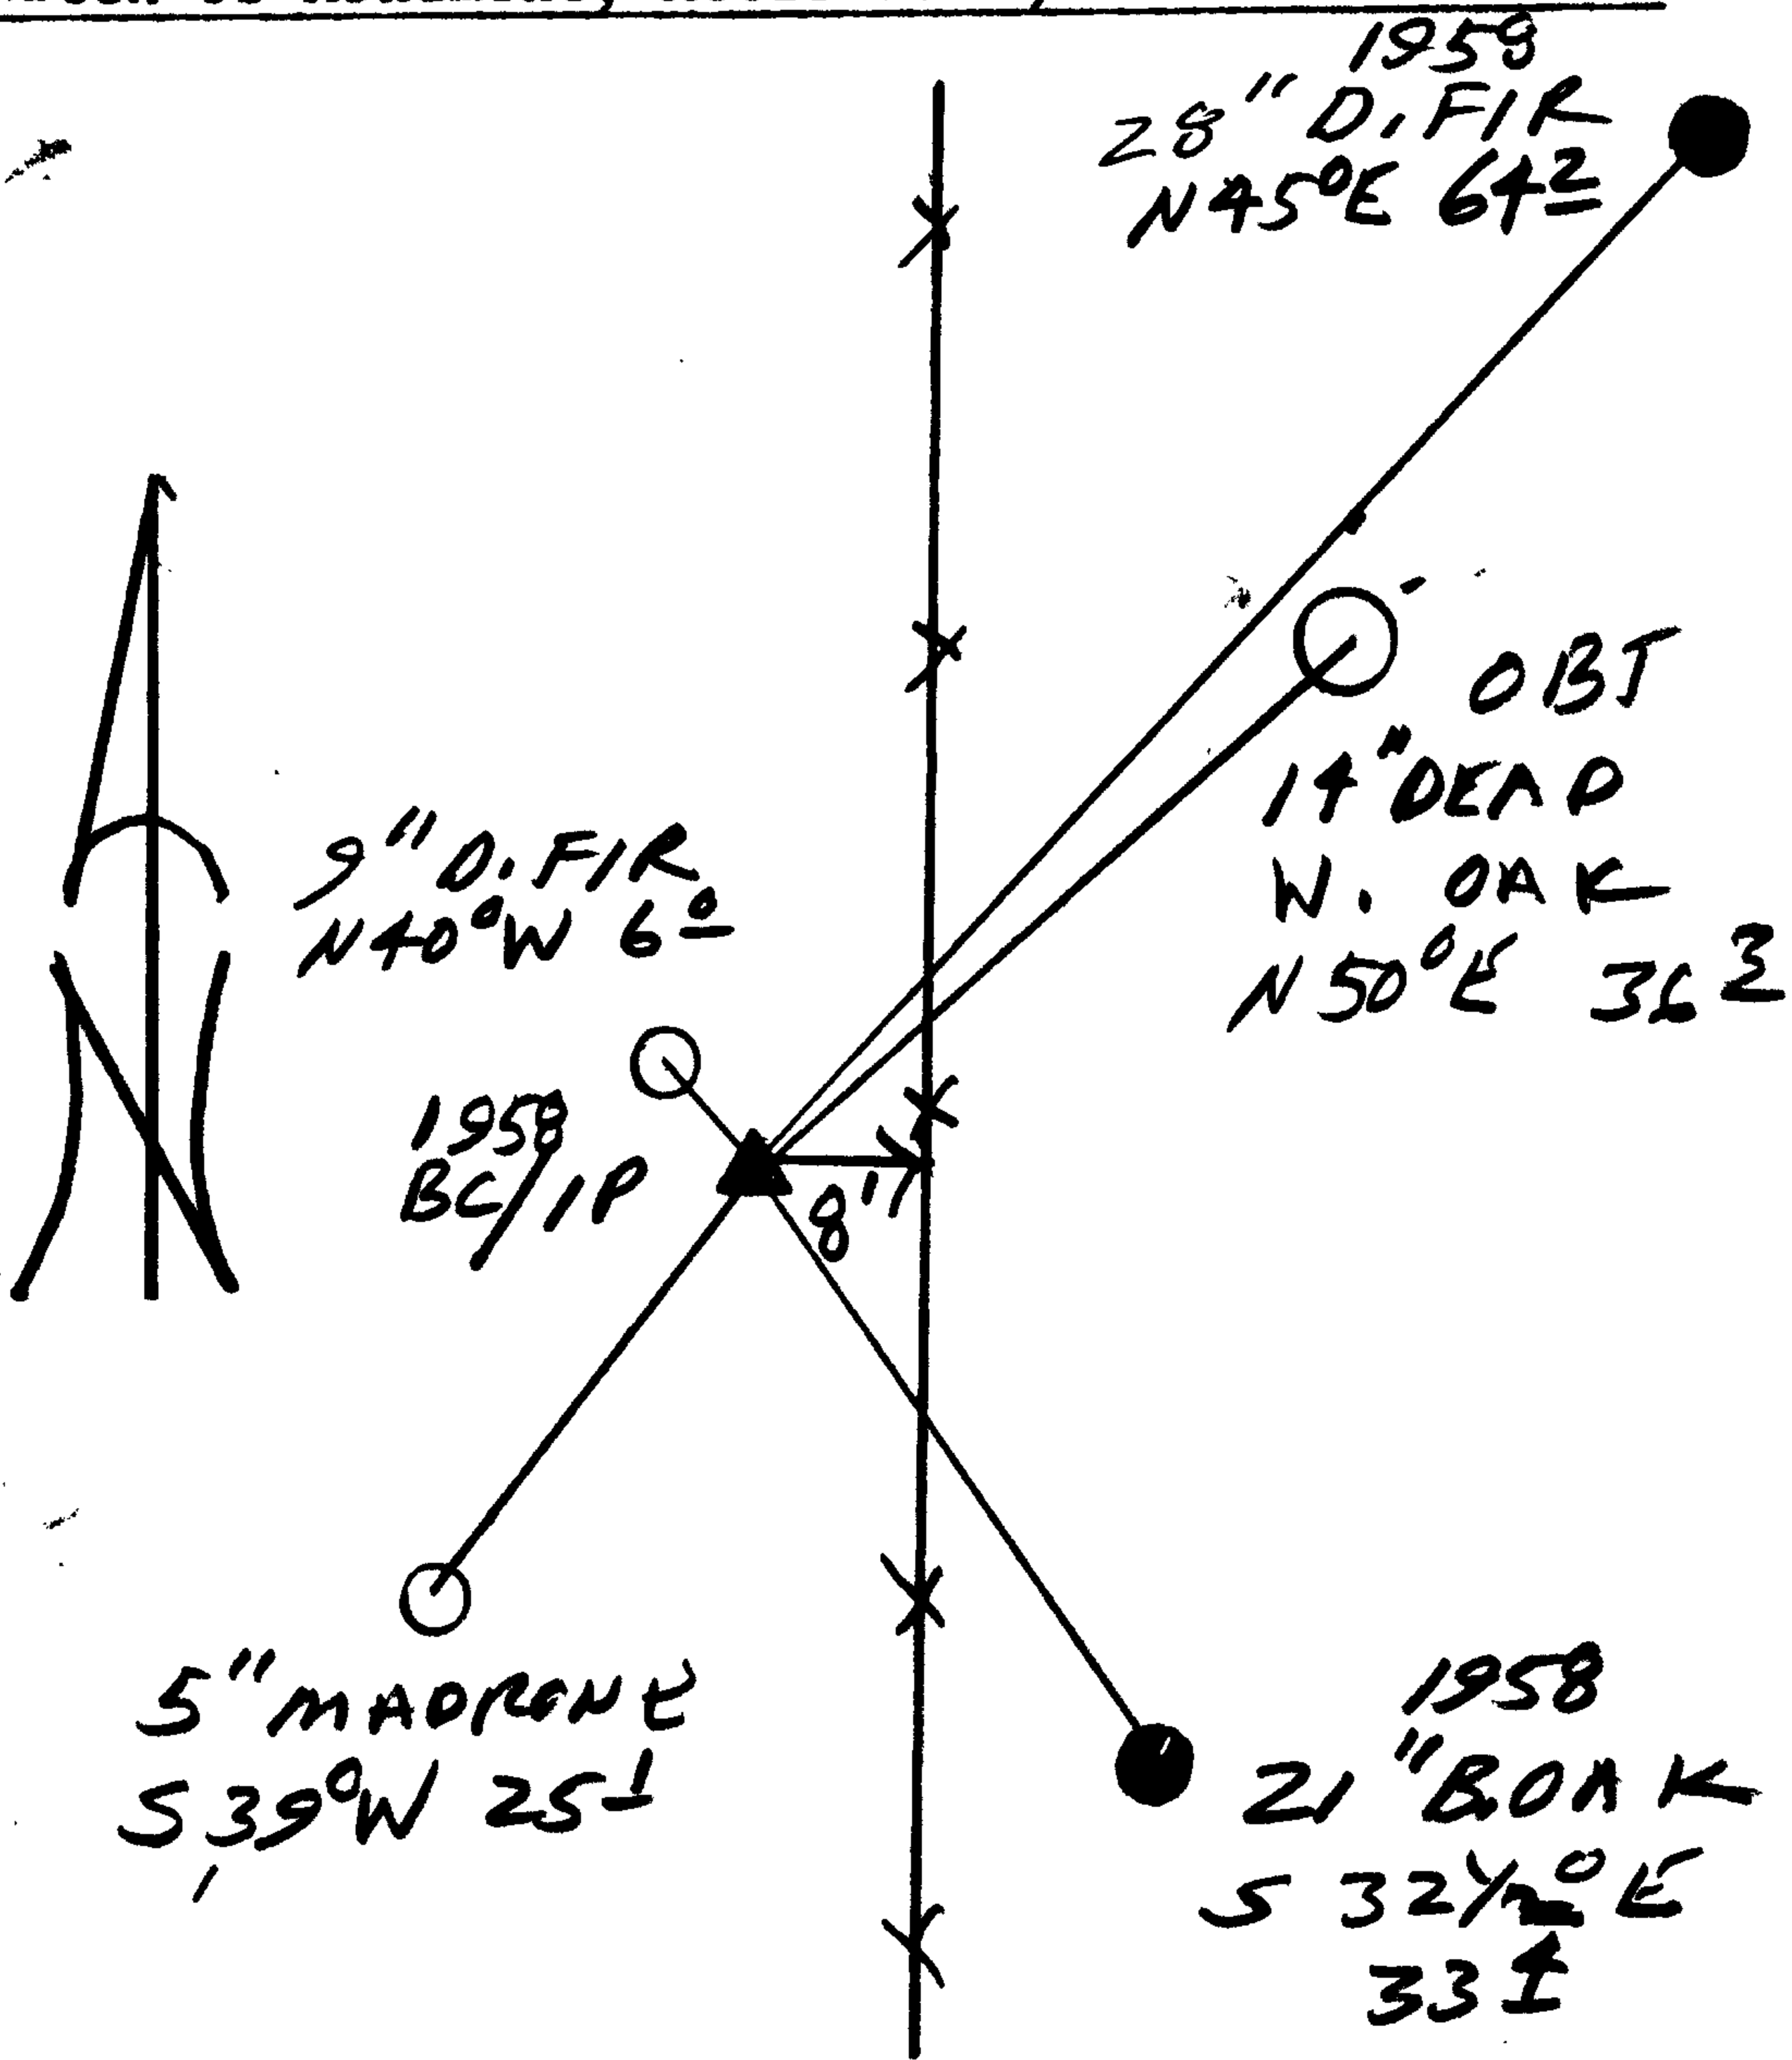

Location & Comments

CORNER LIES 8 FT WEST OF A N-S FENCE LINK.

Comp. Declin. 17 3/4° E  
Agency DCSD  
Party Chief RANDALL W. SMITH  
Notekeeper [Signature]  
Witnesses STEPHEN J. LAUSE

Address

Surveyor's Seal

REGISTERED PROFESSIONAL LAND SURVEYOR

[Signature]  
EXPIRES 6-30-2011

OREGON  
JULY 25, 1990  
RANDALL W. SMITH  
2489