

GOVERNMENT CORNER RESTORATION FORM

Date: 4-23-1999 By: JC

This survey consists of:

Township 27S Range 7W Sec. 29 County DOUGLAS

Map: _____

State OR Date 1-26-1999

No. 200200.012 Corner Rpt: 66/8-10

Corner Designation

S30 | S29
S31 | S32

DOUGLAS COUNTY SURVEYOR

- Condition Report Only
- Not Found
- Renewed
- Unrecorded
- Surveyed In
- Referenced Out

MONUMENT DETAIL

Previous Renewals 1930 + 1957 DCSO

Monument(s) Found: (Condition and Source)

2 1/2" DIA BRASS CAP ON A 1 1/2" OD IRON PIPE, PROTRUDING 13" ABOVE A ROUND OF STONE. (1957)

COUNTY SURVEYORS OFFICE

T 27S

S30 | S29

S31 | S32

R 7W

Accessories Found:

10" NOW 12" DIA W. OAK WITH A FULLY HEALED BLAZE, BEARS S60°W, 44.0 FT (AGREES WITH REC.) 1930

10" NOW 18" DIA W. OAK WITH A FULLY HEALED SINGLE BLAZE, BEARS N37°E, 55.7 FT (AGREES WITH REC.) 1930

18" NOW 14" DIA 2 FT HIGH ROTTEN D. FIR STUMP NO SCRIBING VISIBLE, BEARS N14°E, 19.8 FT (AGREES WITH REC.) 1957

24" NOW 36" DIA MARBONITE WITH HEALED BLAZE, BEARS N 21° W 23.0 FT (AGREES WITH REC.) 1957

1957 SE BT GONE

RENEWAL

Monument Set (Procedure and Description)

NONE


Monument Detail

N/A

New Accessories

21" DIA 1. CEDAR DOUBLE BLAZED AND SCRIBED 1" T 275 R 7W
S 132 CS BT, BEARS 577°E, 346 FT

Sketch of Monument, Accessories, and General Area

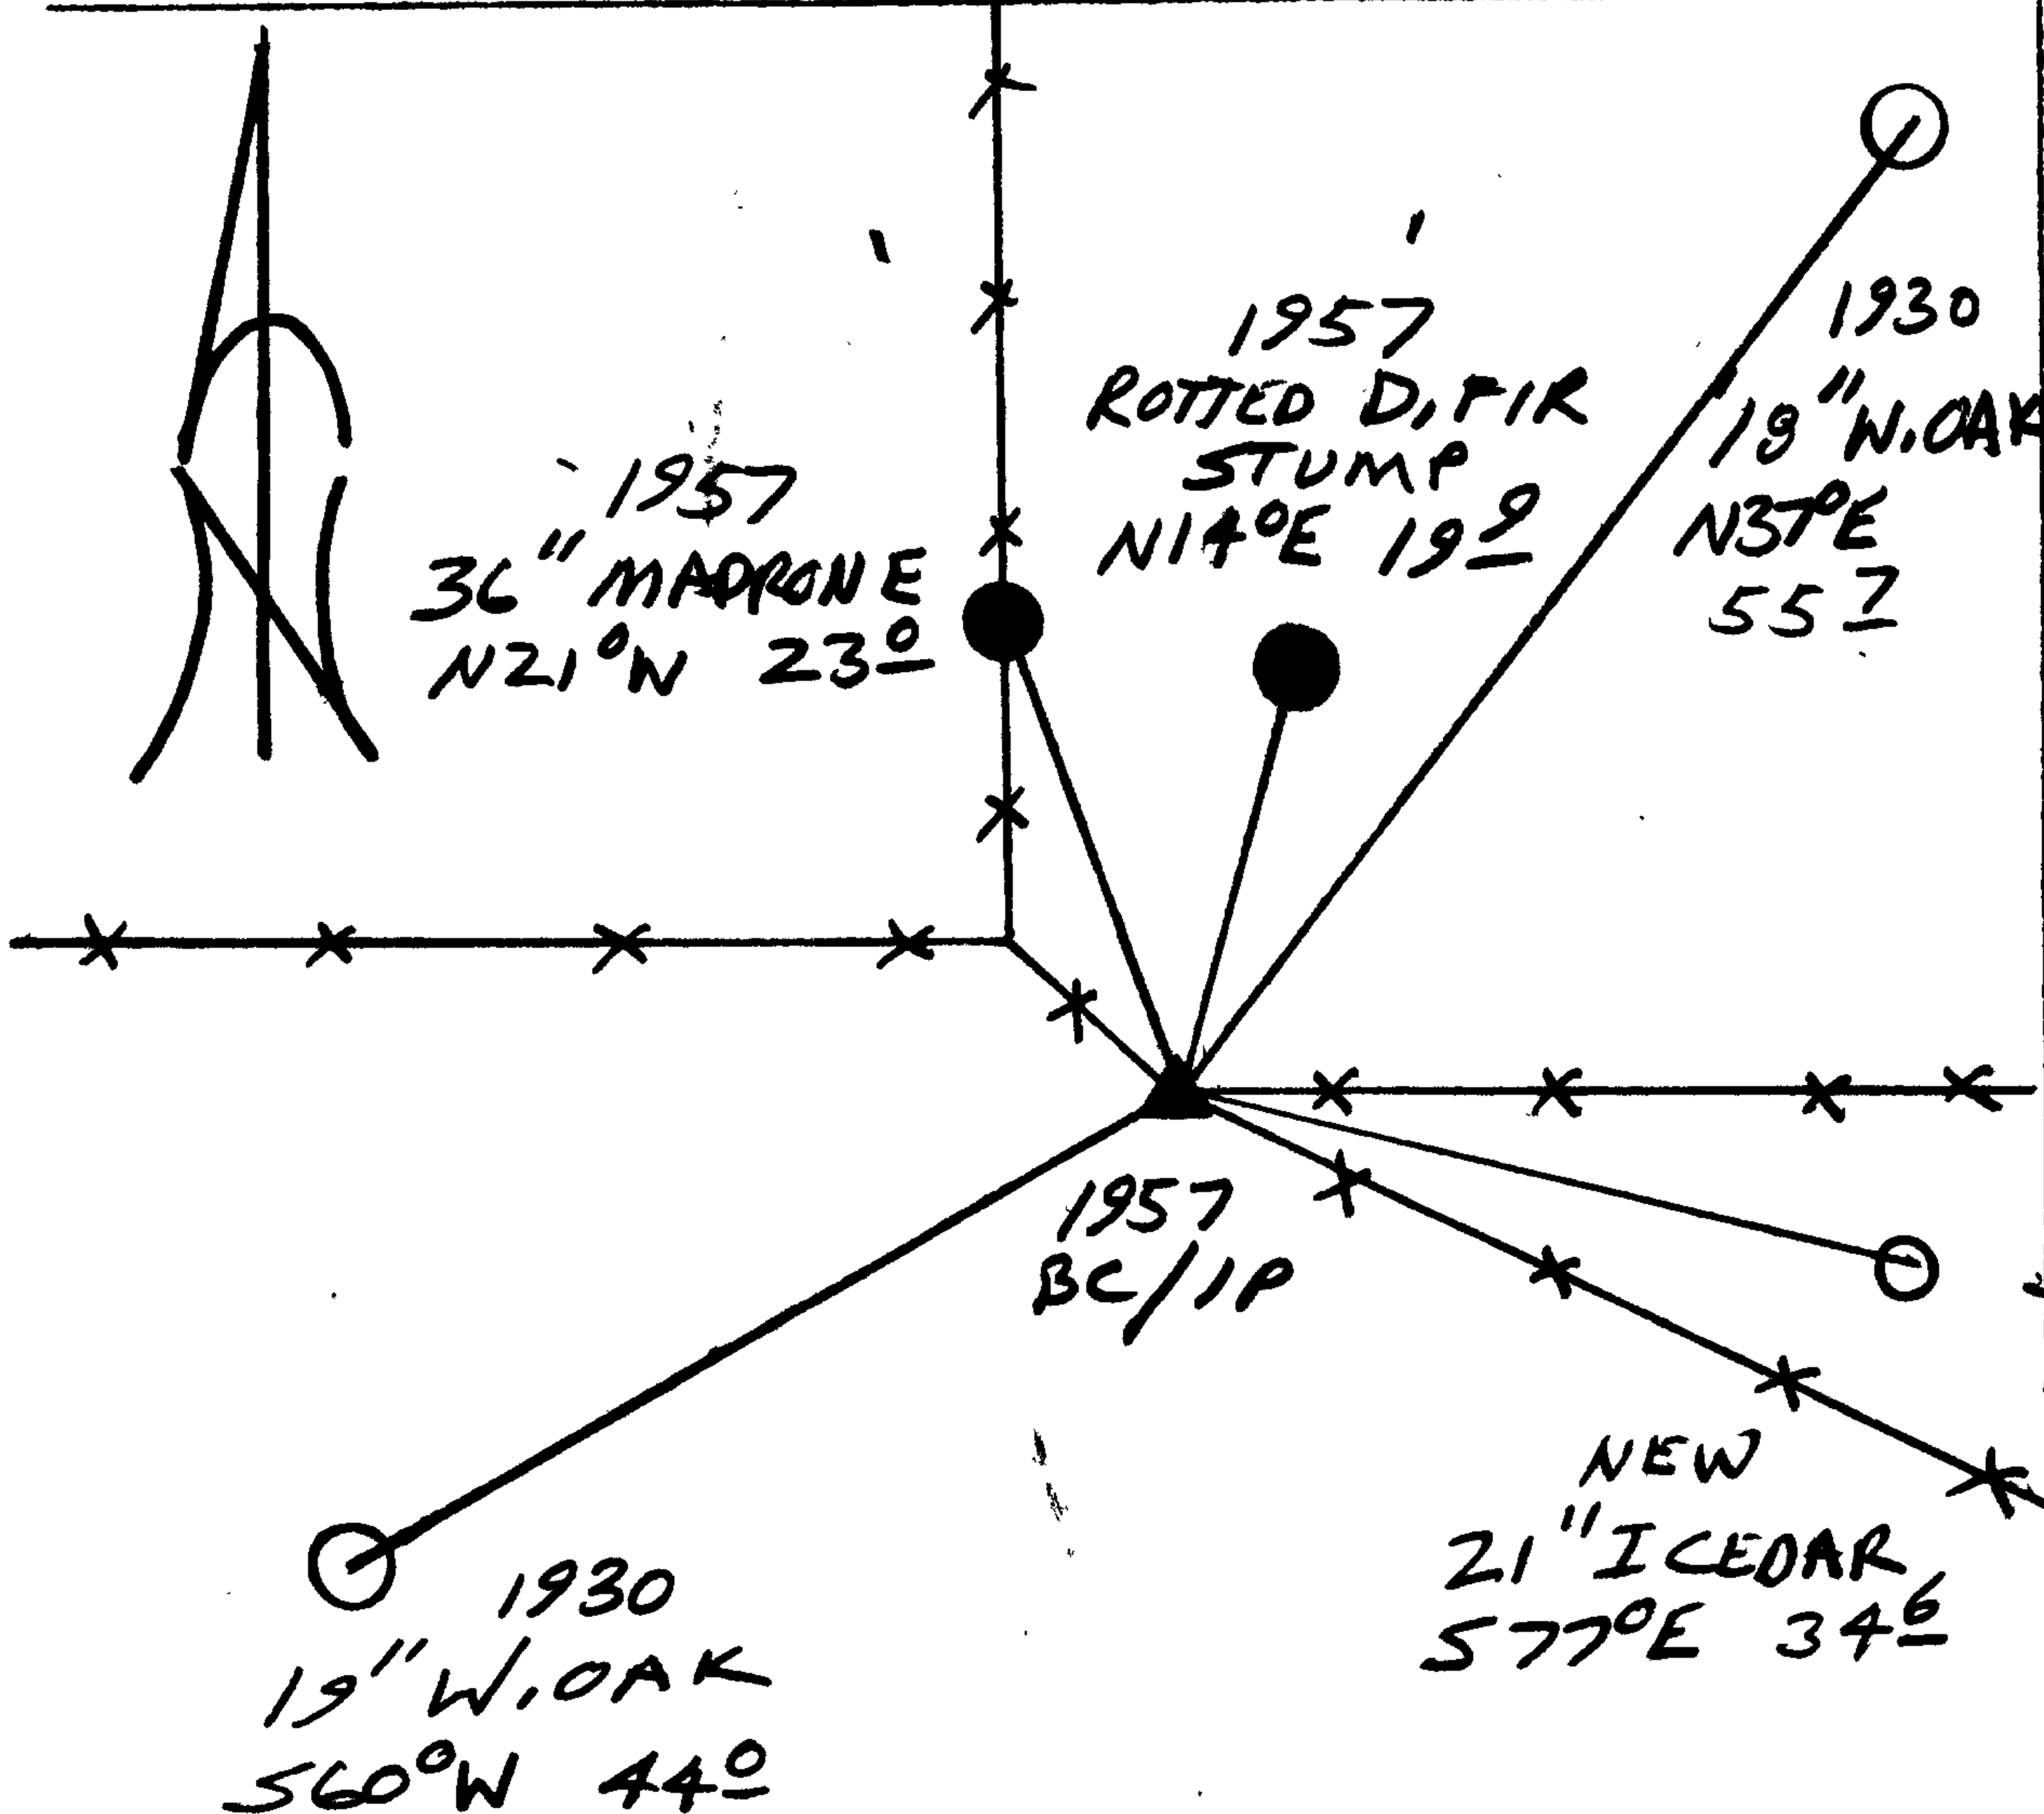

Location & Comments

Comp. Declin. 17 3/4° E
 Agency DCSO
 Party Chief RANDALL W. SMITH
 Notekeeper Charles W. Smith
 Witnesses STEPHEN J. LAUSE

Address

Surveyor's Seal

REGISTERED
 PROFESSIONAL
 LAND SURVEYOR

Charles W. Smith
 LICENSE 6530-2001

OREGON
 JULY 25, 1990
 RANDALL W. SMITH
 2488