

Date: 4-23-1999 By: JC

GOVERNMENT CORNER RESTORATION FORM

This survey consists of:

Township 27S Range 7W Sec. 29  
State OR Date 1-27-1999

County DOUGLAS  
No. 052030.012

Map: \_\_\_\_\_  
Narrative: \_\_\_\_\_  
Corner Rpt: 66/8-11

Corner Designation

SW COR  
DLC 52

DOUGLAS COUNTY  
SURVEYOR

- Condition Report Only
- Not Found
- Renewed
- Unrecorded
- Surveyed In
- Referenced Out

Previous Renewals 1929 DCSO

Monument(s) Found: (Condition and Source)

1 3/4" O.D. IRON PIPE  
EMBEDDING 0.5 FT NORTH  
OF PLUMB. PROTRUDES 3"  
ABOVE GROUND. 1929

N/A

Accessories Found:

12" NOW 18" DIA 10' HIGH D. FIR SNAG  
WITH A FULLY HEALED DOUBLE BLAZE,  
BEARS N80°E, 15.2 FT (AGLES WITH REC.)  
1929

RENEWAL

Monument Set (Procedure and Description)

2 3/8" DIA BRASS CAP ON A 1 3/8" BY  
 35" LONG IRON PIPE IS SET  
 AT PLUMB POSITION AS FOUND  
 IRON PIPE, PROTRUDES 5"  
 ABOVE GROUND.

FOUND I.P. MEASURED 17" LONG  
 IS SET ALONG NORTH EDGE OF  
 BCIP, PROTRUDES 3" ABOVE  
 GROUND

Monument Detail

DOUGLAS COUNTY SURVEYORS  
T. 27 S

SW | 52 | R  
 | | | 7  
 - DLC | W

1999  
OFFICE

New Accessories


16" DIA MADRONE DOUBLE BLAZED AND SCRIBED "SW DLC 52 CS BT"  
 BEARS N 18° E, 23.9 FT

18" DIA B. OAK / DOUBLE BLAZED AND SCRIBED "SW DLC 52 CS BT"  
 BEARS S 62° E, 46.0 FT

10" DIA W. OAK / DOUBLE BLAZED AND SCRIBED "SW DLC 52 CS BT"  
 BEARS S 10° W, 96.6 FT

4" DIA G. FIR DOUBLE BLAZED AND SCRIBED "X BT"  
 BEARS N 10° W, 4.4 FT

Sketch of Monument, Accessories, and General Area

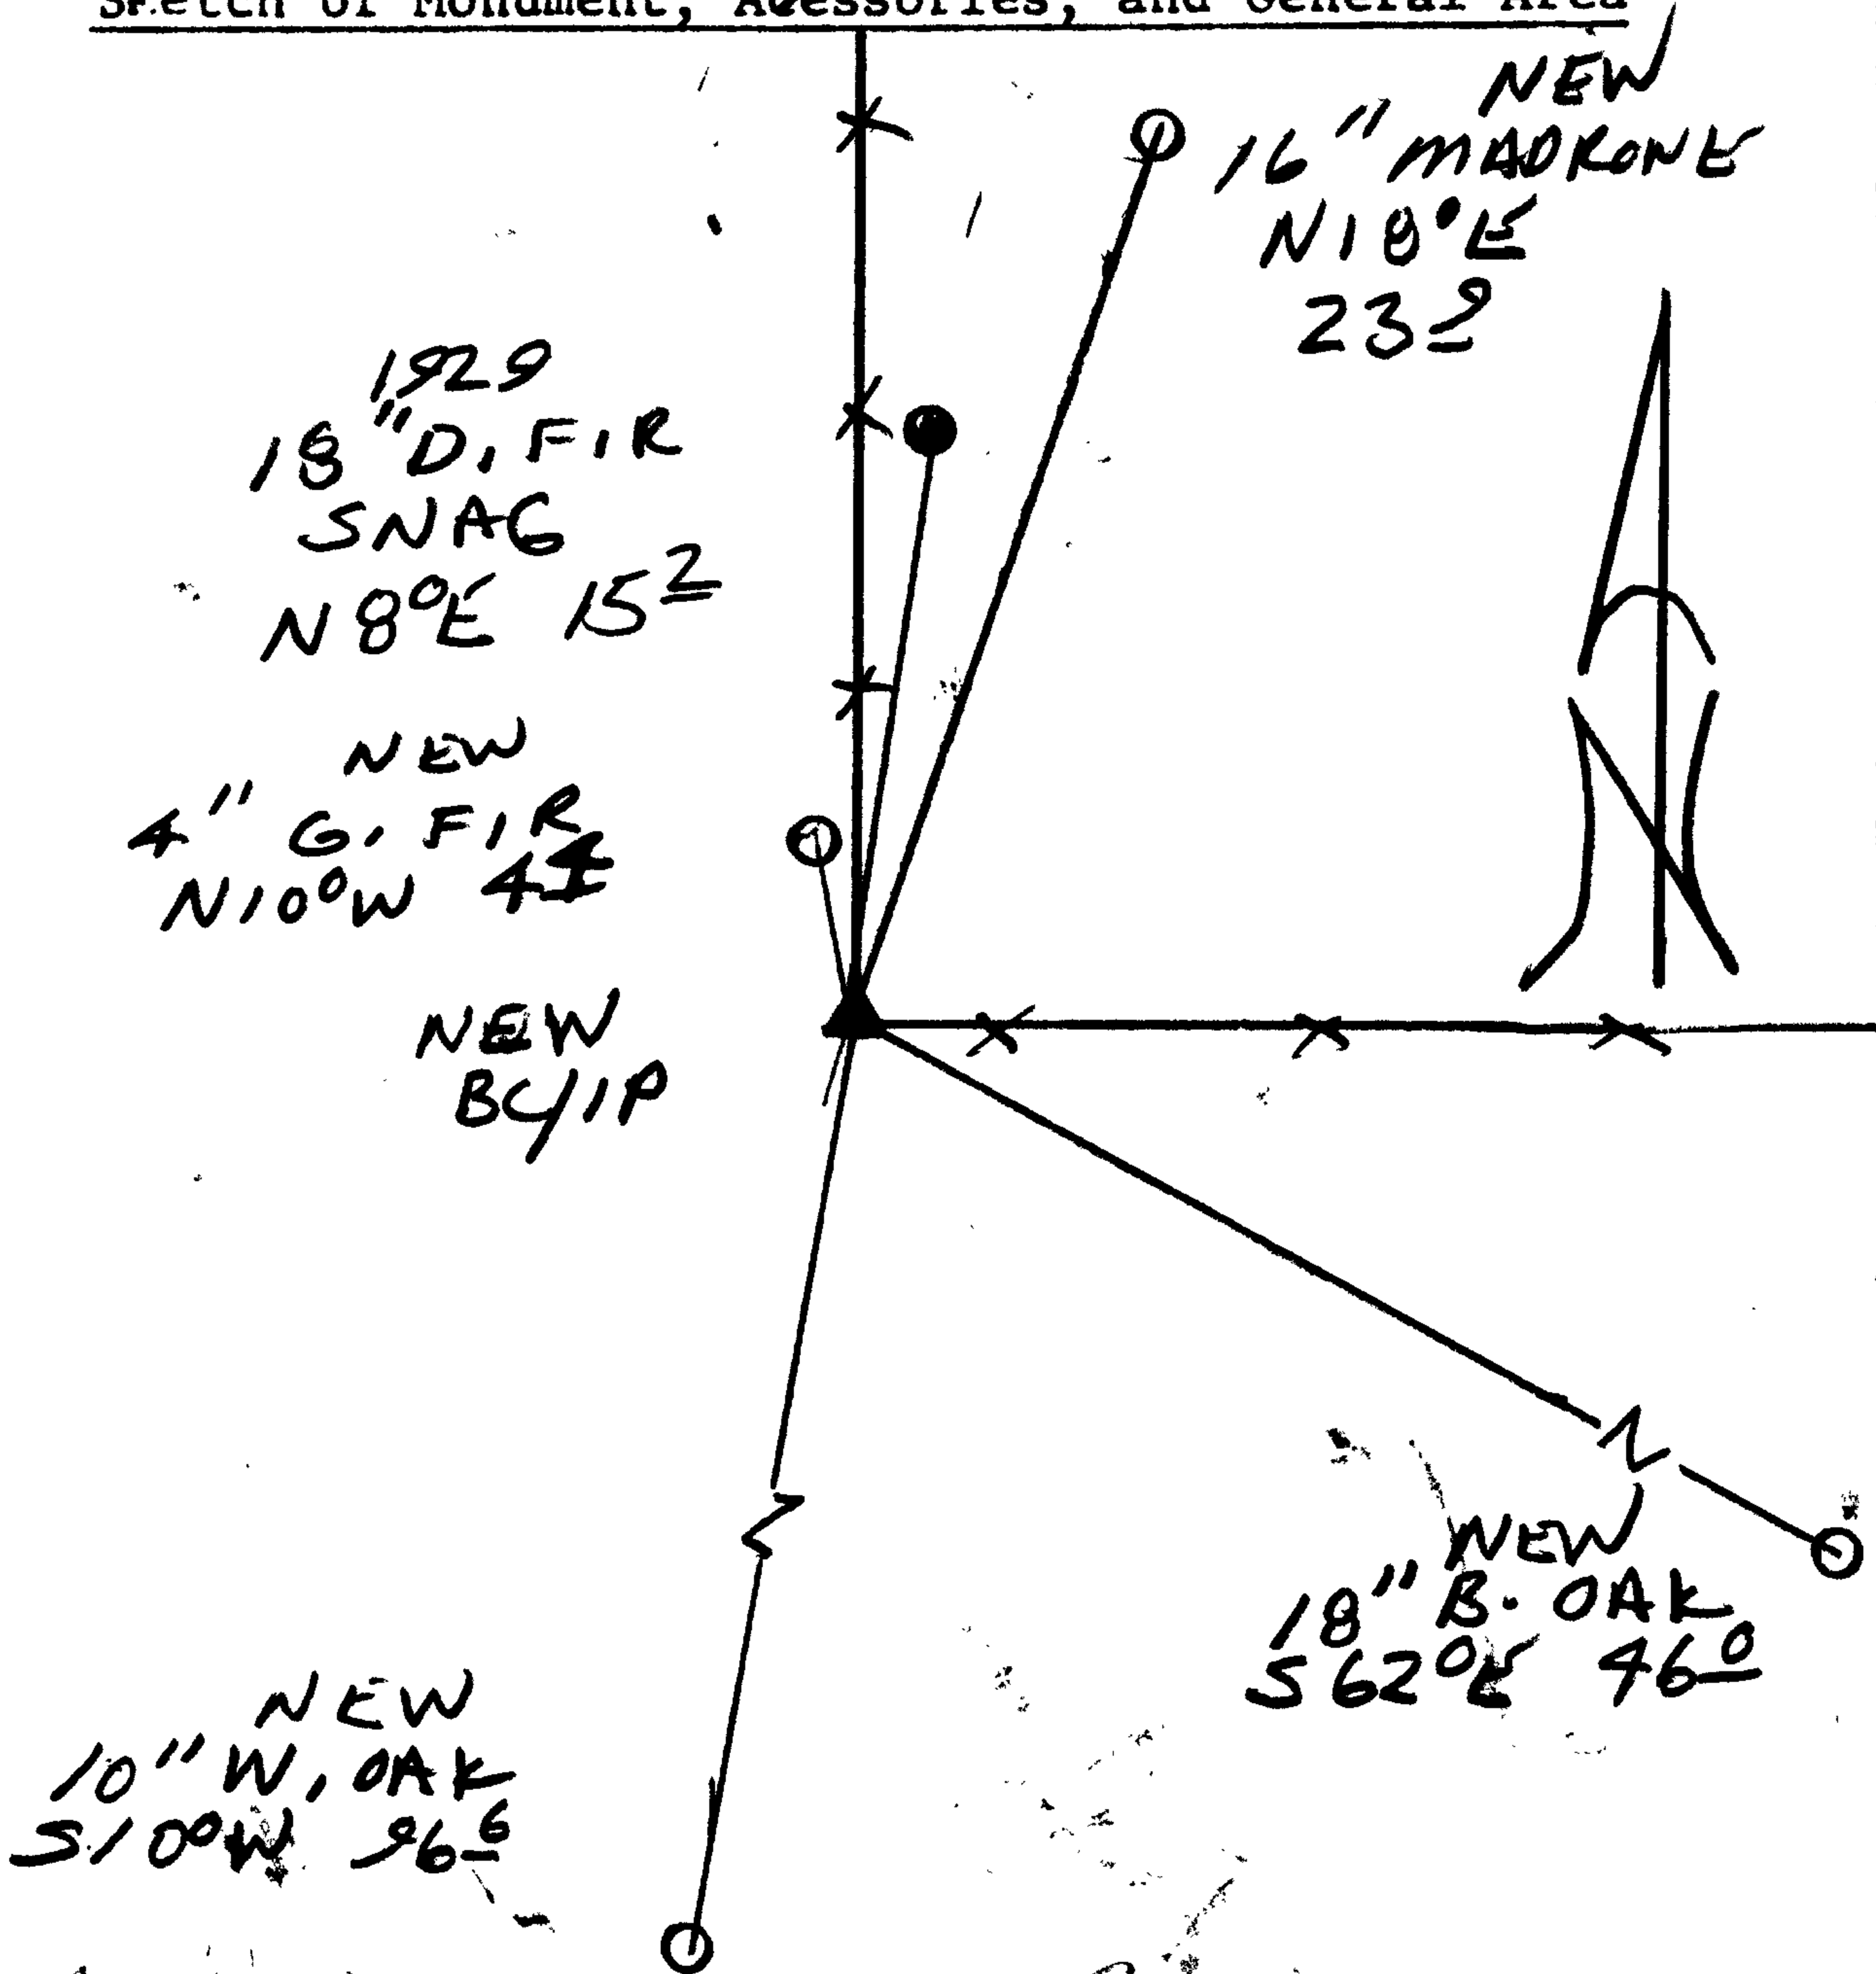

Location & Comments

CORNER LIES AT THE INTERSECTION OF A N AND E RUNNING FENCE LINES

Comp. Declin. 17 3/4° E  
 Agency DCSO  
 Party Chief RANDALL W. SMITH  
 Notekeeper [Signature]  
 Witnesses STEPHEN J. FINISH

Address

Surveyor's Seal

REGISTERED  
 PROFESSIONAL  
 LAND SURVEYOR

[Signature]  
 JULY 25, 1999

OREGON  
 JULY 25, 1990  
 RANDALL W. SMITH  
 2489