

GOVERNMENT CORNER RESTORATION FORM

Date: 4-23-1999 By: JC

This survey consists of

Township 30S Range 3W Sec. 30 County DOUGLAS

State OK Date 2-18-99

No. 100240 044

Map: Narrative: Corner Rpt: 66/8-15

Corner Designation

1/4 S30 ONLY

DOUGLAS COUNTY SURVEYOR

- Condition Report Only
- Not Found
- Renewed
- Unrecorded
- Surveyed In
- Referenced Out

MONUMENT DETAIL

Previous Renewals 1889, 1930, 1948, 1963

Monument(s) Found: (Condition and Source)

2 1/2 BRASS CAP ON A  
 1 1/2" O.D IRON PIPE, BLAZZ  
 2 1/2 FT SW OF PLUMB  
 1963

COUNTY SURVEYORS OFFICE  
 T30S  
 R 1/4 R  
 4 S30 3  
 W W  
 WEST  
 1963

Accessories Found:

22" NOW 22" DIA D. FIR STUMP, ROTTED, NO  
 SCRIBING VISIBLE, BEARS N65°E, 41.6 FT.  
 (AGREES WITH R.C.) 1930

12" NOW 27" DIA D. FIR WITH A FULLY HEALED  
 DOUBLE BLAZZ, BEARS N68°E, 32.0 FT  
 (R.C. N70°E, 38.0 FT) 1948

15" NOW 32" DIA D. FIR WITH A FULLY HEALED  
 DOUBLE BLAZZ, BEARS N5°E, 21.6 FT  
 (R.C. N7°E, 22.6 FT) 1963

RENEWAL

Monument Set (Procedure and Description)

EP BC/IP MEASURED 36"  
LONG IS STRAIGHTENED AND  
SET BACK AT PLUMB POSITION,  
PROTRUS 13" ABOVE GROUND,  
SURROUNDED BY A 1 1/2 FT DIA  
MOUND OF QUARTZ


Monument Detail

N/A

New Accessories

14" D. FIR DOUBLE BLAZED AND SCRIBED "WY4S30CS87"  
BEARS S 14 1/2° W 20.3 FT. NOTE BT ON  
WEST SIDE OF LINE

Sketch of Monument, Accessories, and General Area

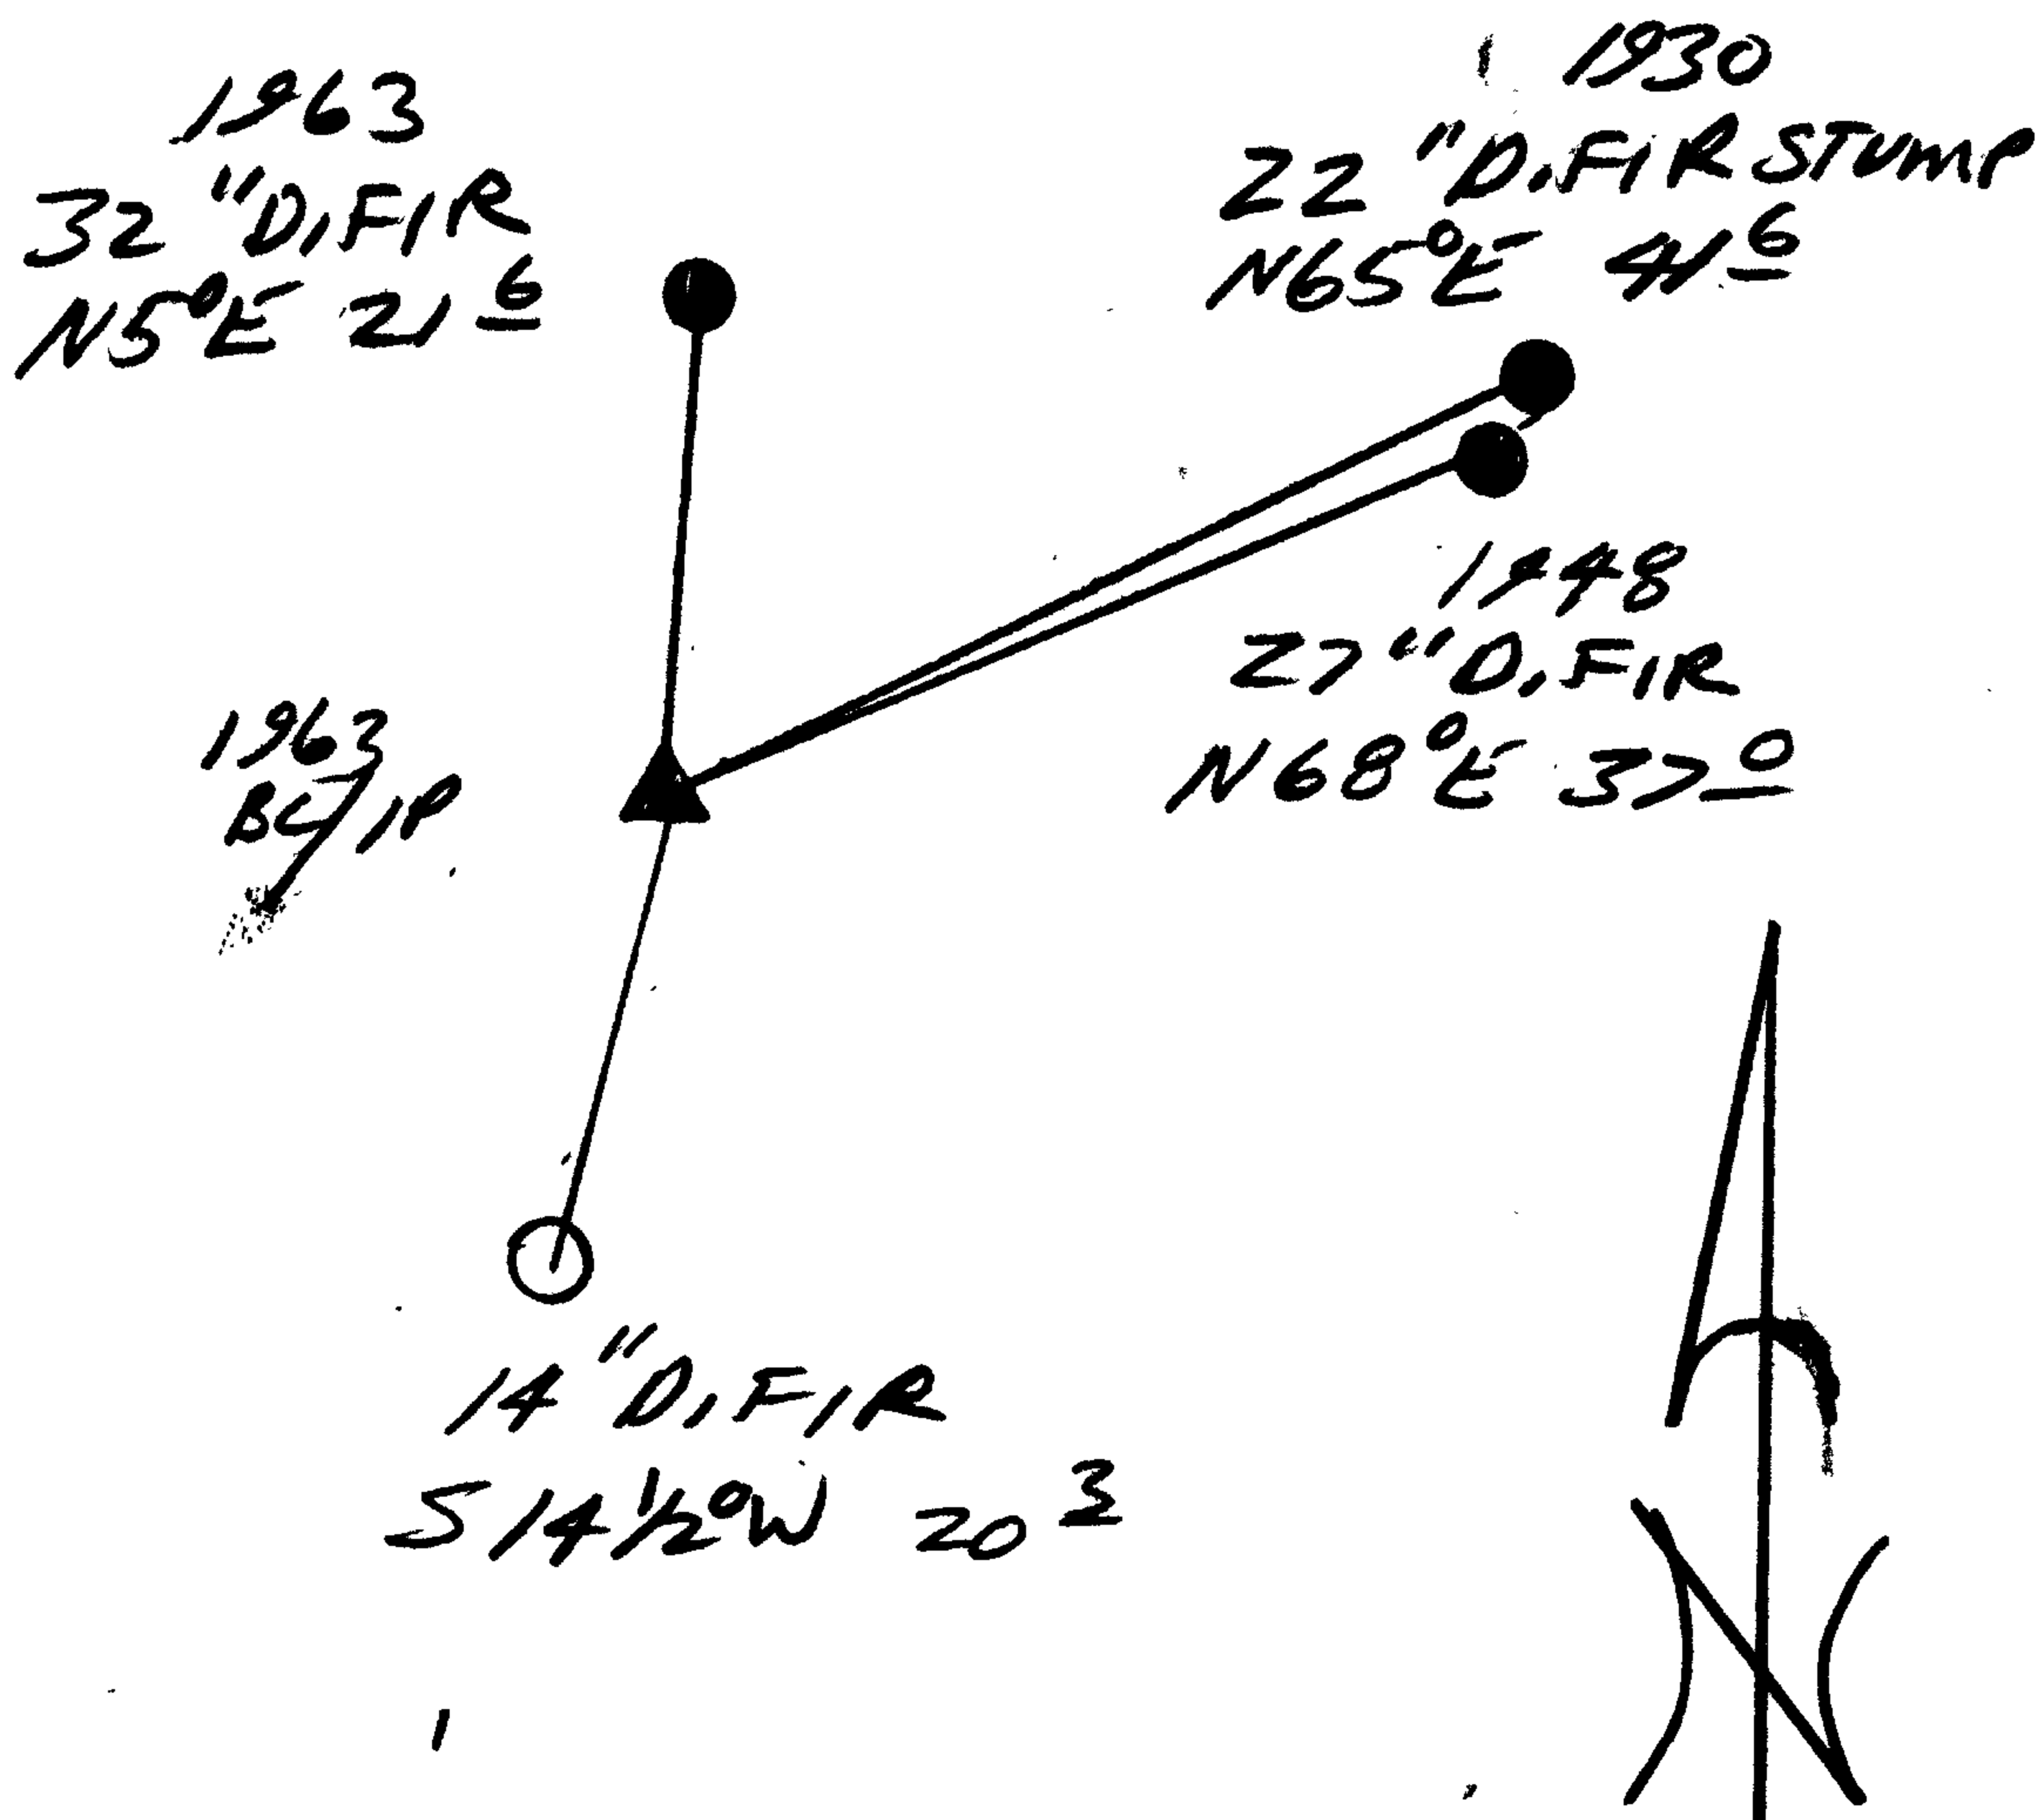

Location & Comments

Comp. Declin. 17 3/4 ° W  
Agency OCSO  
Party Chief RANDALL W. SMITH  
Notekeeper  
Witnesses STEPHEN J. FLYNN

Address

Surveyor's Seal

REGISTERED  
PROFESSIONAL  
LAND SURVEYOR

RANDALL W. SMITH  
EXPIRES 6-30-2001

OREGON  
JULY 25, 1980  
RANDALL W. SMITH  
2489