

GOVERNMENT CORNER RESTORATION FORM

Date: 4-23-1999 By: X

Township 30S Range 4W Sec. 10

County DOUGLAS

This survey consists of:

State OR

Date 3-3-99


No. 047040.034

Narrative:

Corner Rpt: 66/8-20

Corner Designation

INT SW

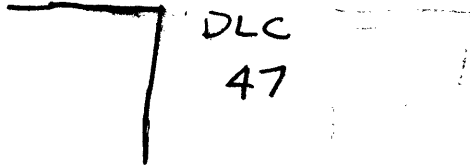

DOUGLAS COUNTY

- Condition Report Copy
- Not Found
- Renewed
- Unrecorded
- Surveyed In
- Referenced Out

MONUMENT DETAIL

Previous Renewals 1889, 1922, 1951, 1963

Monument(s) Found: (Condition and Source)
 1 1/2" O.D. IRON PIPE PROTRUDES
 18" ABOVE GROUND, BADLY RUSTY,
 BRASS CAP IS GONE. 1963

3/4" I.D. IRON PIPE FLUSH WITH
 GROUND 1989 - 1991

3/4" I.D. IRON PIPE PROTRUDES
 15" ABOVE GROUND, N 80° E,
 1.7 FT OF 1963 I.P. 1951

N/A

Accessories Found:

8 FT HIGH BT SNAG
 12" DIA 32" DIA HUBBARD V. WITH A PREVIOUSLY OPENED
 PARTIALLY HOLLOW BLAZE, NO SCALING VISIBLE,
 BRKS 1 S 21 1/2° E, 68 1/5 FT (SEE 521 1/2° E, 67.3 FT
 POSSIBLE BACK MEASUREMENT). 0BT

NO OTHER BT'S FOUND

TOP OF CHURCH STEEPLE, RECORD N 62° W.

RENEWAL

Monument Set (Procedure and Description)

FD BEAT 1 1/2" O.D. I.P. FROM
 1963 MEASURED 36" LONG, FD. 1922
 3/4" I.D. I.P. MEASURED 16" LONG.
 AT REFERENCED POSITION OF ABOVE
 I.P.'S A 2 3/8" DIA BRASS CAP
 ON A 1 3/8" O.D. BY 32" LONG IRON
 PIPE IS SET PROTRUDING 12" ABOVE
 GROUND, FD 3/4" I.P. IS SET
 ALONG NORTHERLY EDGE, FLUSH
 WITH GROUND.

Monument Detail

DOUGLAS COUNTY SURVEYORS


T 30 S
 INT SW R
 DL C 4
 7 47 N

1999
 OFFICE

New Accessories

- 4" W. OAK DOUBLE BLAZED AND SCRIBED " X CS BT BEARS
 S 7 51.9 FT
- 4" W. OAK DOUBLE BLAZED AND SCRIBED " SW INT DLC 47 CS BT"
 BEARS S 31 3/4° E 67.2 FT
- 5" X" CHISEL IN ROCK OF CUTBANK AT THE
 NW CORNER OF MICHAELS RANCH LN AND TILLER TRAIL
 HWY BEARS S 46 1/2° W 76.4 FT

Sketch of Monument, Accessories; and General Area

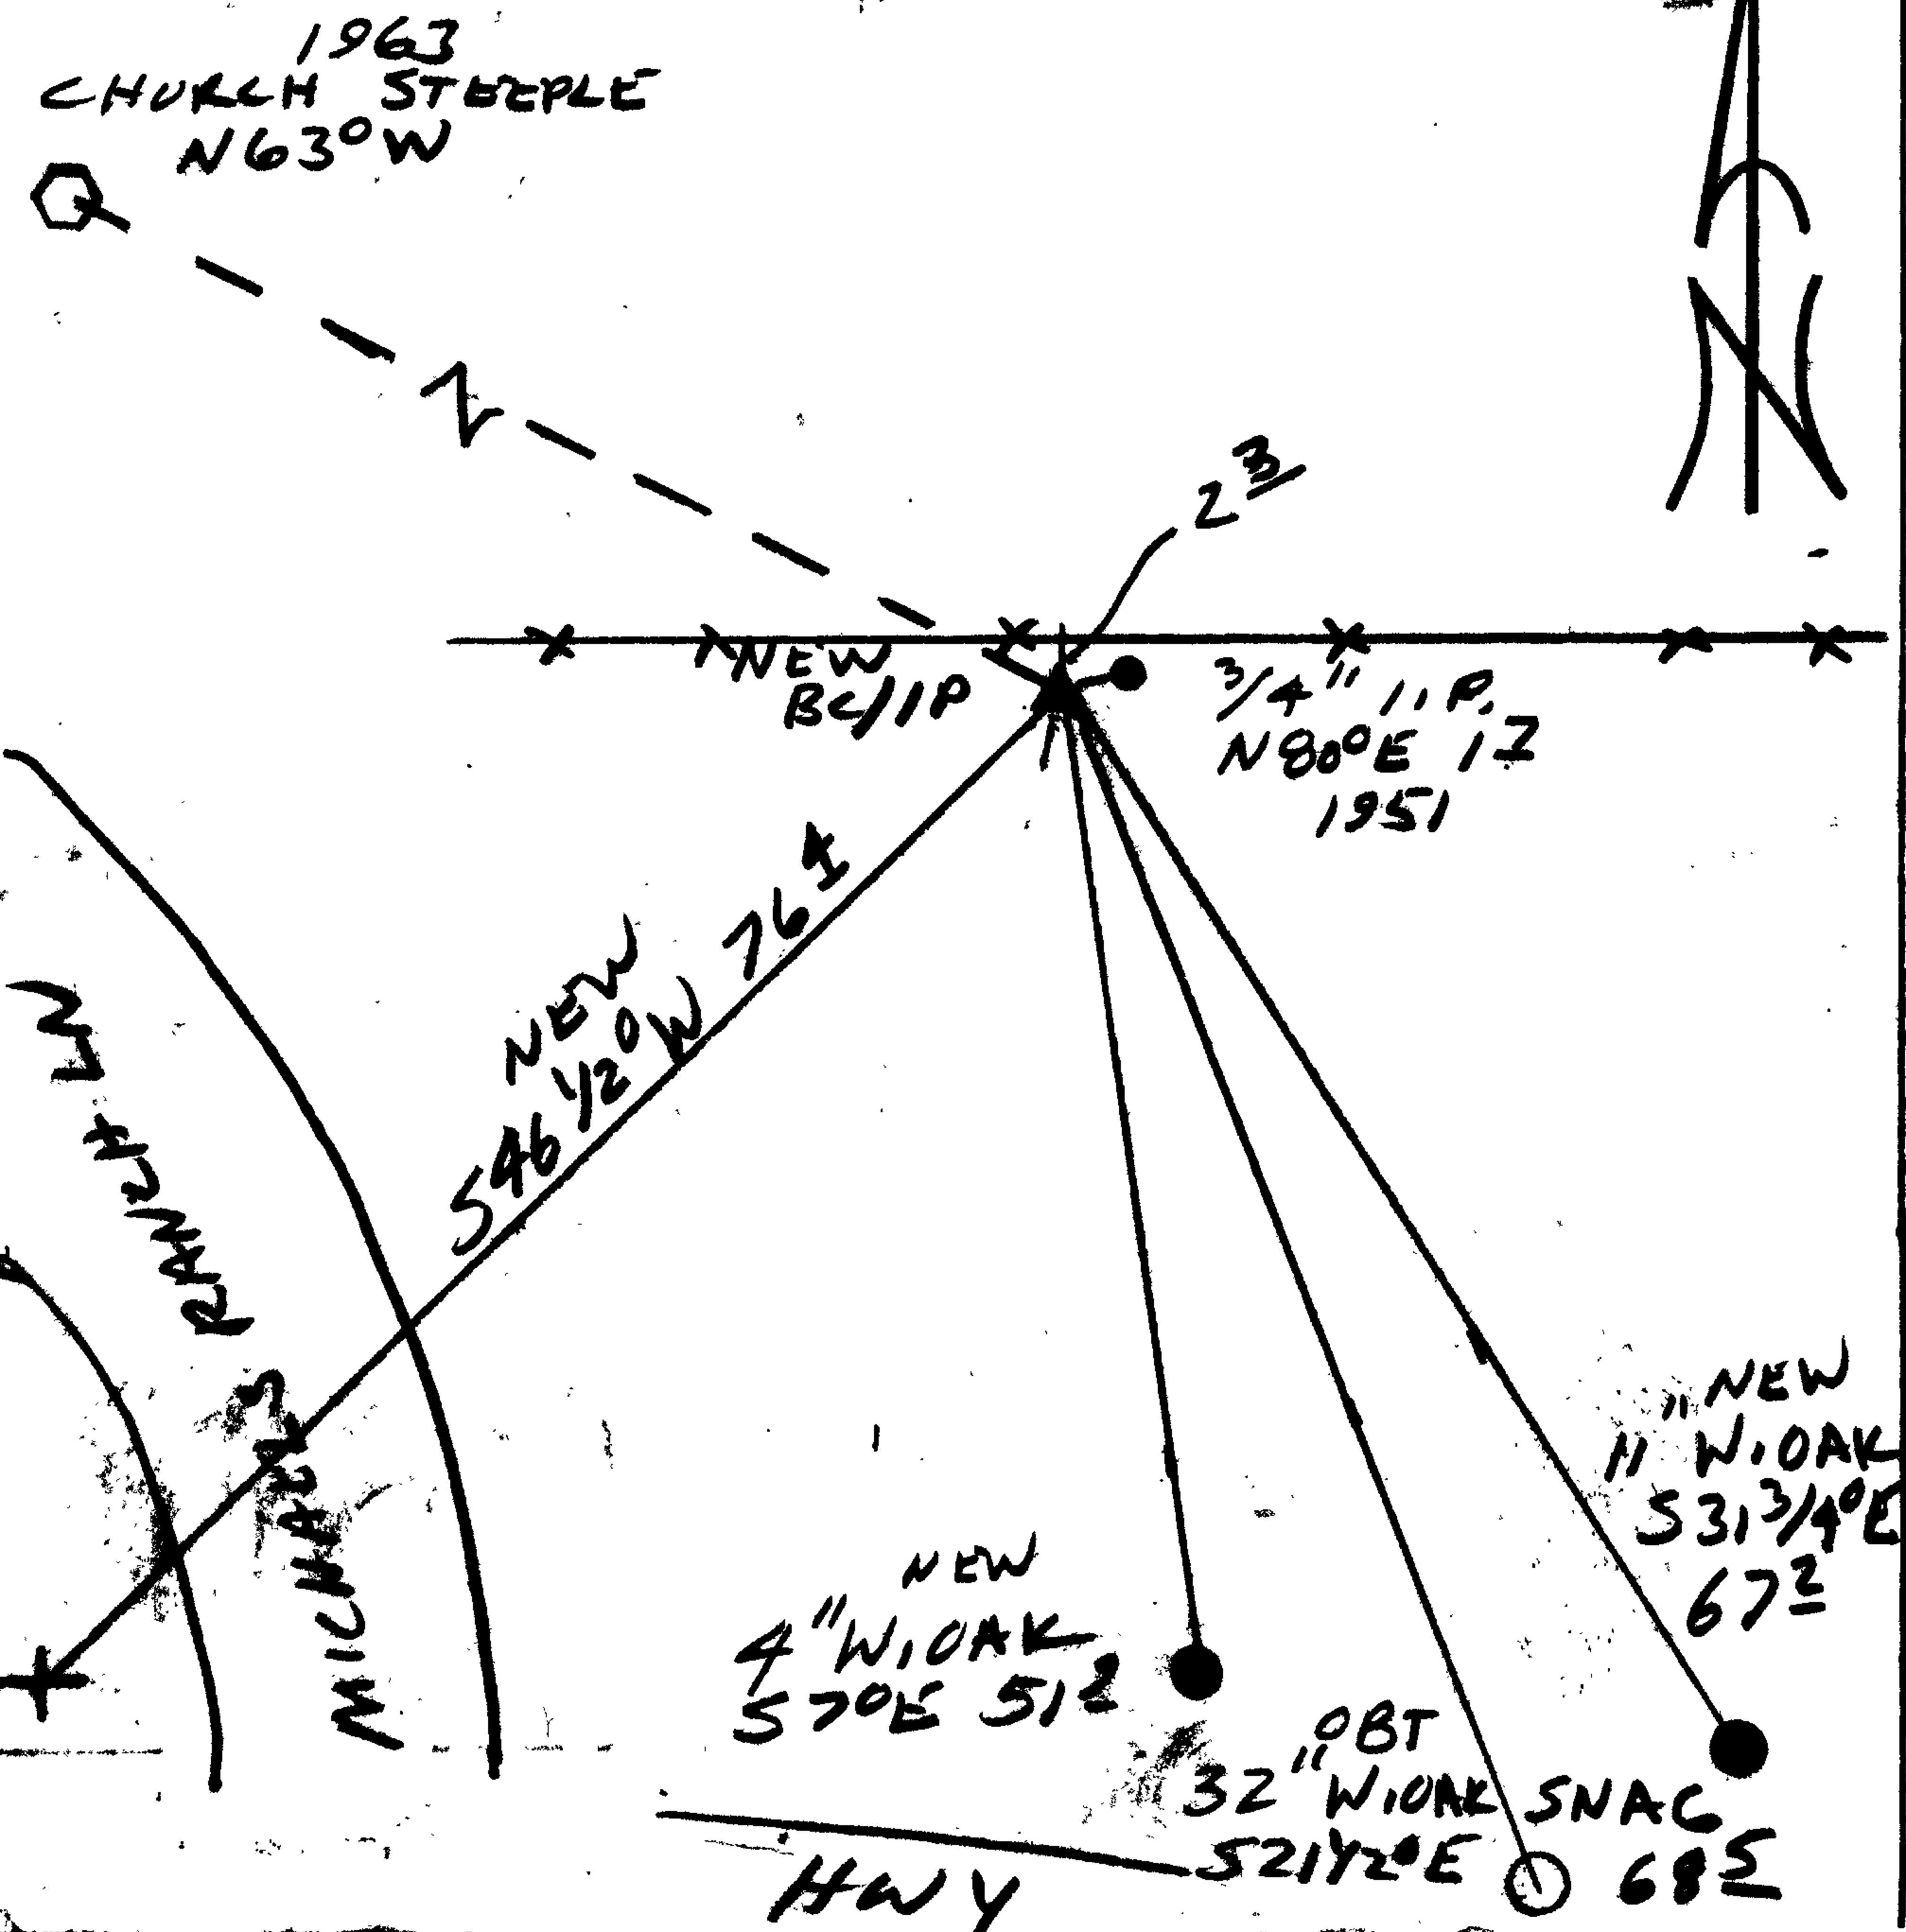

Location & Comments

- INT. OF TILLER TRAIL
 HWY AND MICHAELS
 RANCH LN BEARS
 APPROX S 15° W 90 FT

Comp. Declin. 17 3/4°
 Agency DCSC
 Party Chief RANDALL W. SMITH
 Notekeeper
 Witness

Address

Surveyor's Seal

REGISTERED
 PROFESSIONAL
 LAND SURVEYOR

OREGON
 JULY 25, 1980
 RANDALL W. SMITH
 2489