

GOVERNMENT CORNER RESTORATION FORM

Date: 4-23-1999 By: X

Township 30S Range 4W Sec. 10

County DOUGLAS This survey consists of:

State OR Date 3-3-99

No. 048040.031 Narrative: _____

Corner Designation

Corner Rpt: 66/8-21

SSE
DLC 48

- DOUGLAS COUNTY Condition Report Only
- Not Found
- Renewed
- Unrecorded
- Surveyed In
- Referenced Out

Previous Renewals 1889, 1945, 1963

MONUMENT DETAIL

Monument(s) Found: (Condition and Source)

1" I.D. IRON PIPE PROTRUDES 4" ABOVE GROUND, 1945

N/A

Accessories Found:

8" NOW 10" DIA. W. OAK WITH A FULLY HEALED DOUBLE BLAZE BEARS N 9 1/2° W, 46.2 FT (REC N 3 1/2° W, 46.2 FT) 1945 NOTE: THIS RT IS DEAD WILL BE CUT DOWN IN NEAR FUTURE)

10" NOW 24" DIA. D. FIR WITH A FULLY HEALED DOUBLE BLAZE BEARS S 68 1/2° W, 124.3 FT (AGREES WITH REC.) 1945 NOTE: THIS TREE NOW IS ALIVE AND HEALTHY!

7" NOW ROTTEN TO GROUND D. FIR, NO SCRIBING OR BLAZES FOUND BEARS N 68° W, 20.3 FT (AGREES WITH REC.) 1963

CV

RENEWAL

Monument Set (Procedure and Description)

2 3/8" DIA BRASS CAP ON A 1 3/8" O.D.
BY 32" LONG IRON PIPE IS
SET AT REFERENCED POSITION OF
FO I.P. PROTRUDES 6"
ABOVE GROUND.

FO 1" I.P. MEASURED 33"
LONG IS SET ALONG
SOUTH EDGE OF BC/IP PROTRUDES
4" ABOVE GROUND.

Monument Detail

DOUGLAS COUNTY SURVEYORS
T 30 S


DLC	R
48	4
	W

1999
OFFICE

New Accessories

19" DIA. D. FIR DOUBLE BLAZED AND SCRIBED "SSE DLC 48 CS BT"
BEARS N 31 1/2° W, 28.3 FT
12" DIA. D. FIR DOUBLE BLAZED AND SCRIBED "SSE DLC 48 CS BT"
BEARS S 42 1/2° E, 23.2 FT.
8" DIA. D. FIR DOUBLE BLAZED AND SCRIBED "SSE DLC 48 CS BT"
BEARS N 55 1/2° E, 22.9 FT

Sketch of Monument, Accessories, and General Area

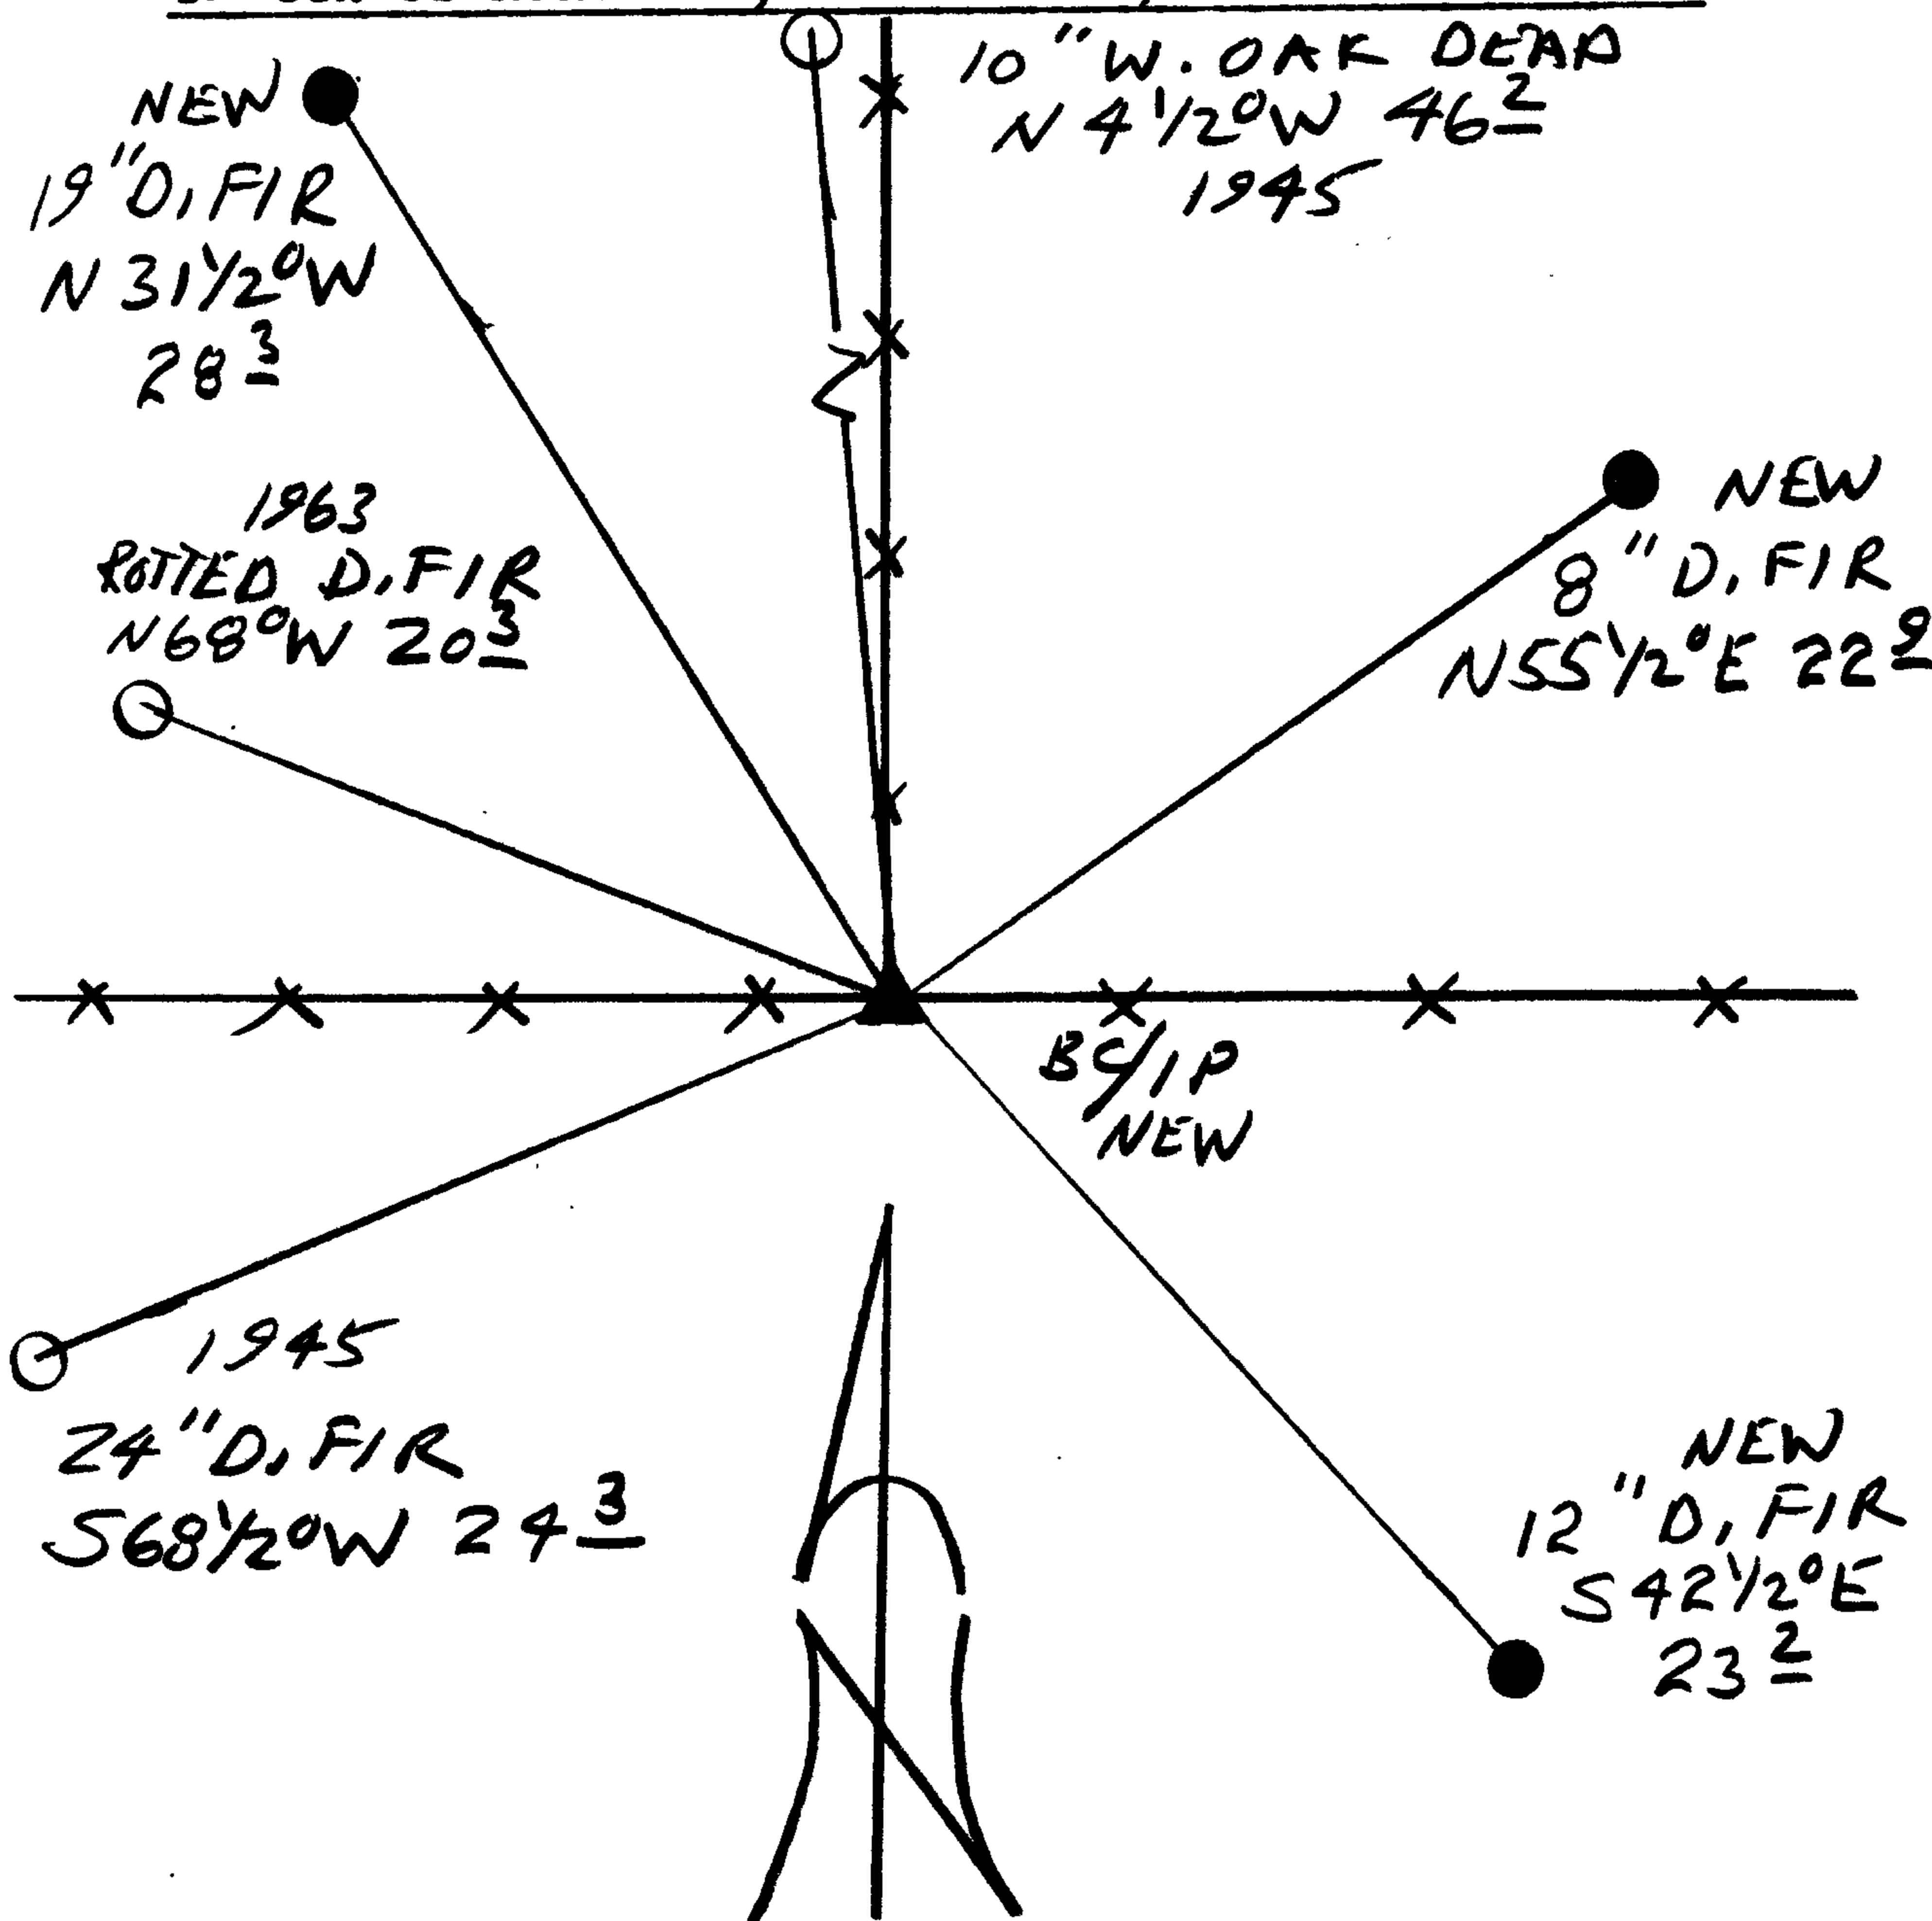

Location & Comments

CORNER LIES AT THE
INTERSECTION OF FENCE
LINES RUNNING E-W
AND N-S

Comp. Declin. 17 3/4° E
Agency DESG
Party Chief RANDALL W. SMITH
Notekeeper
Witnesses STEPHEN J. FLISK

Address

Surveyor's Seal
REGISTERED
PROFESSIONAL
LAND SURVEYOR

Randall W. Smith
EXPIRES 6-30-2000

OREGON
JULY 25, 1999
RANDALL W. SMITH
2480